

# DIMENSIONS

LENGTH B.P. --- 190'-0"  
 BREADTH M.L.D. --- 28'-0"  
 DEPTH - 7. M.D. --- 13'-8 1/2"  
 DEPTH - 7. A.D. --- 20'-9"

No 192 "Buccaneer"

1875LX

## MIDSHIP SECTION

SCALE 1/2" = 1 FOOT


## LLOYDS NUMBERS

1/2 girth --- 24.75  
 1/2 breadth --- 14.00  
 depth --- 14.25  
 53.00 x 189 = 10017

Equipment No 12678

depths - 13.7  
 breadth = 6.7

Note. Iron age gun in sixteenth  
 Steel in 1/2"

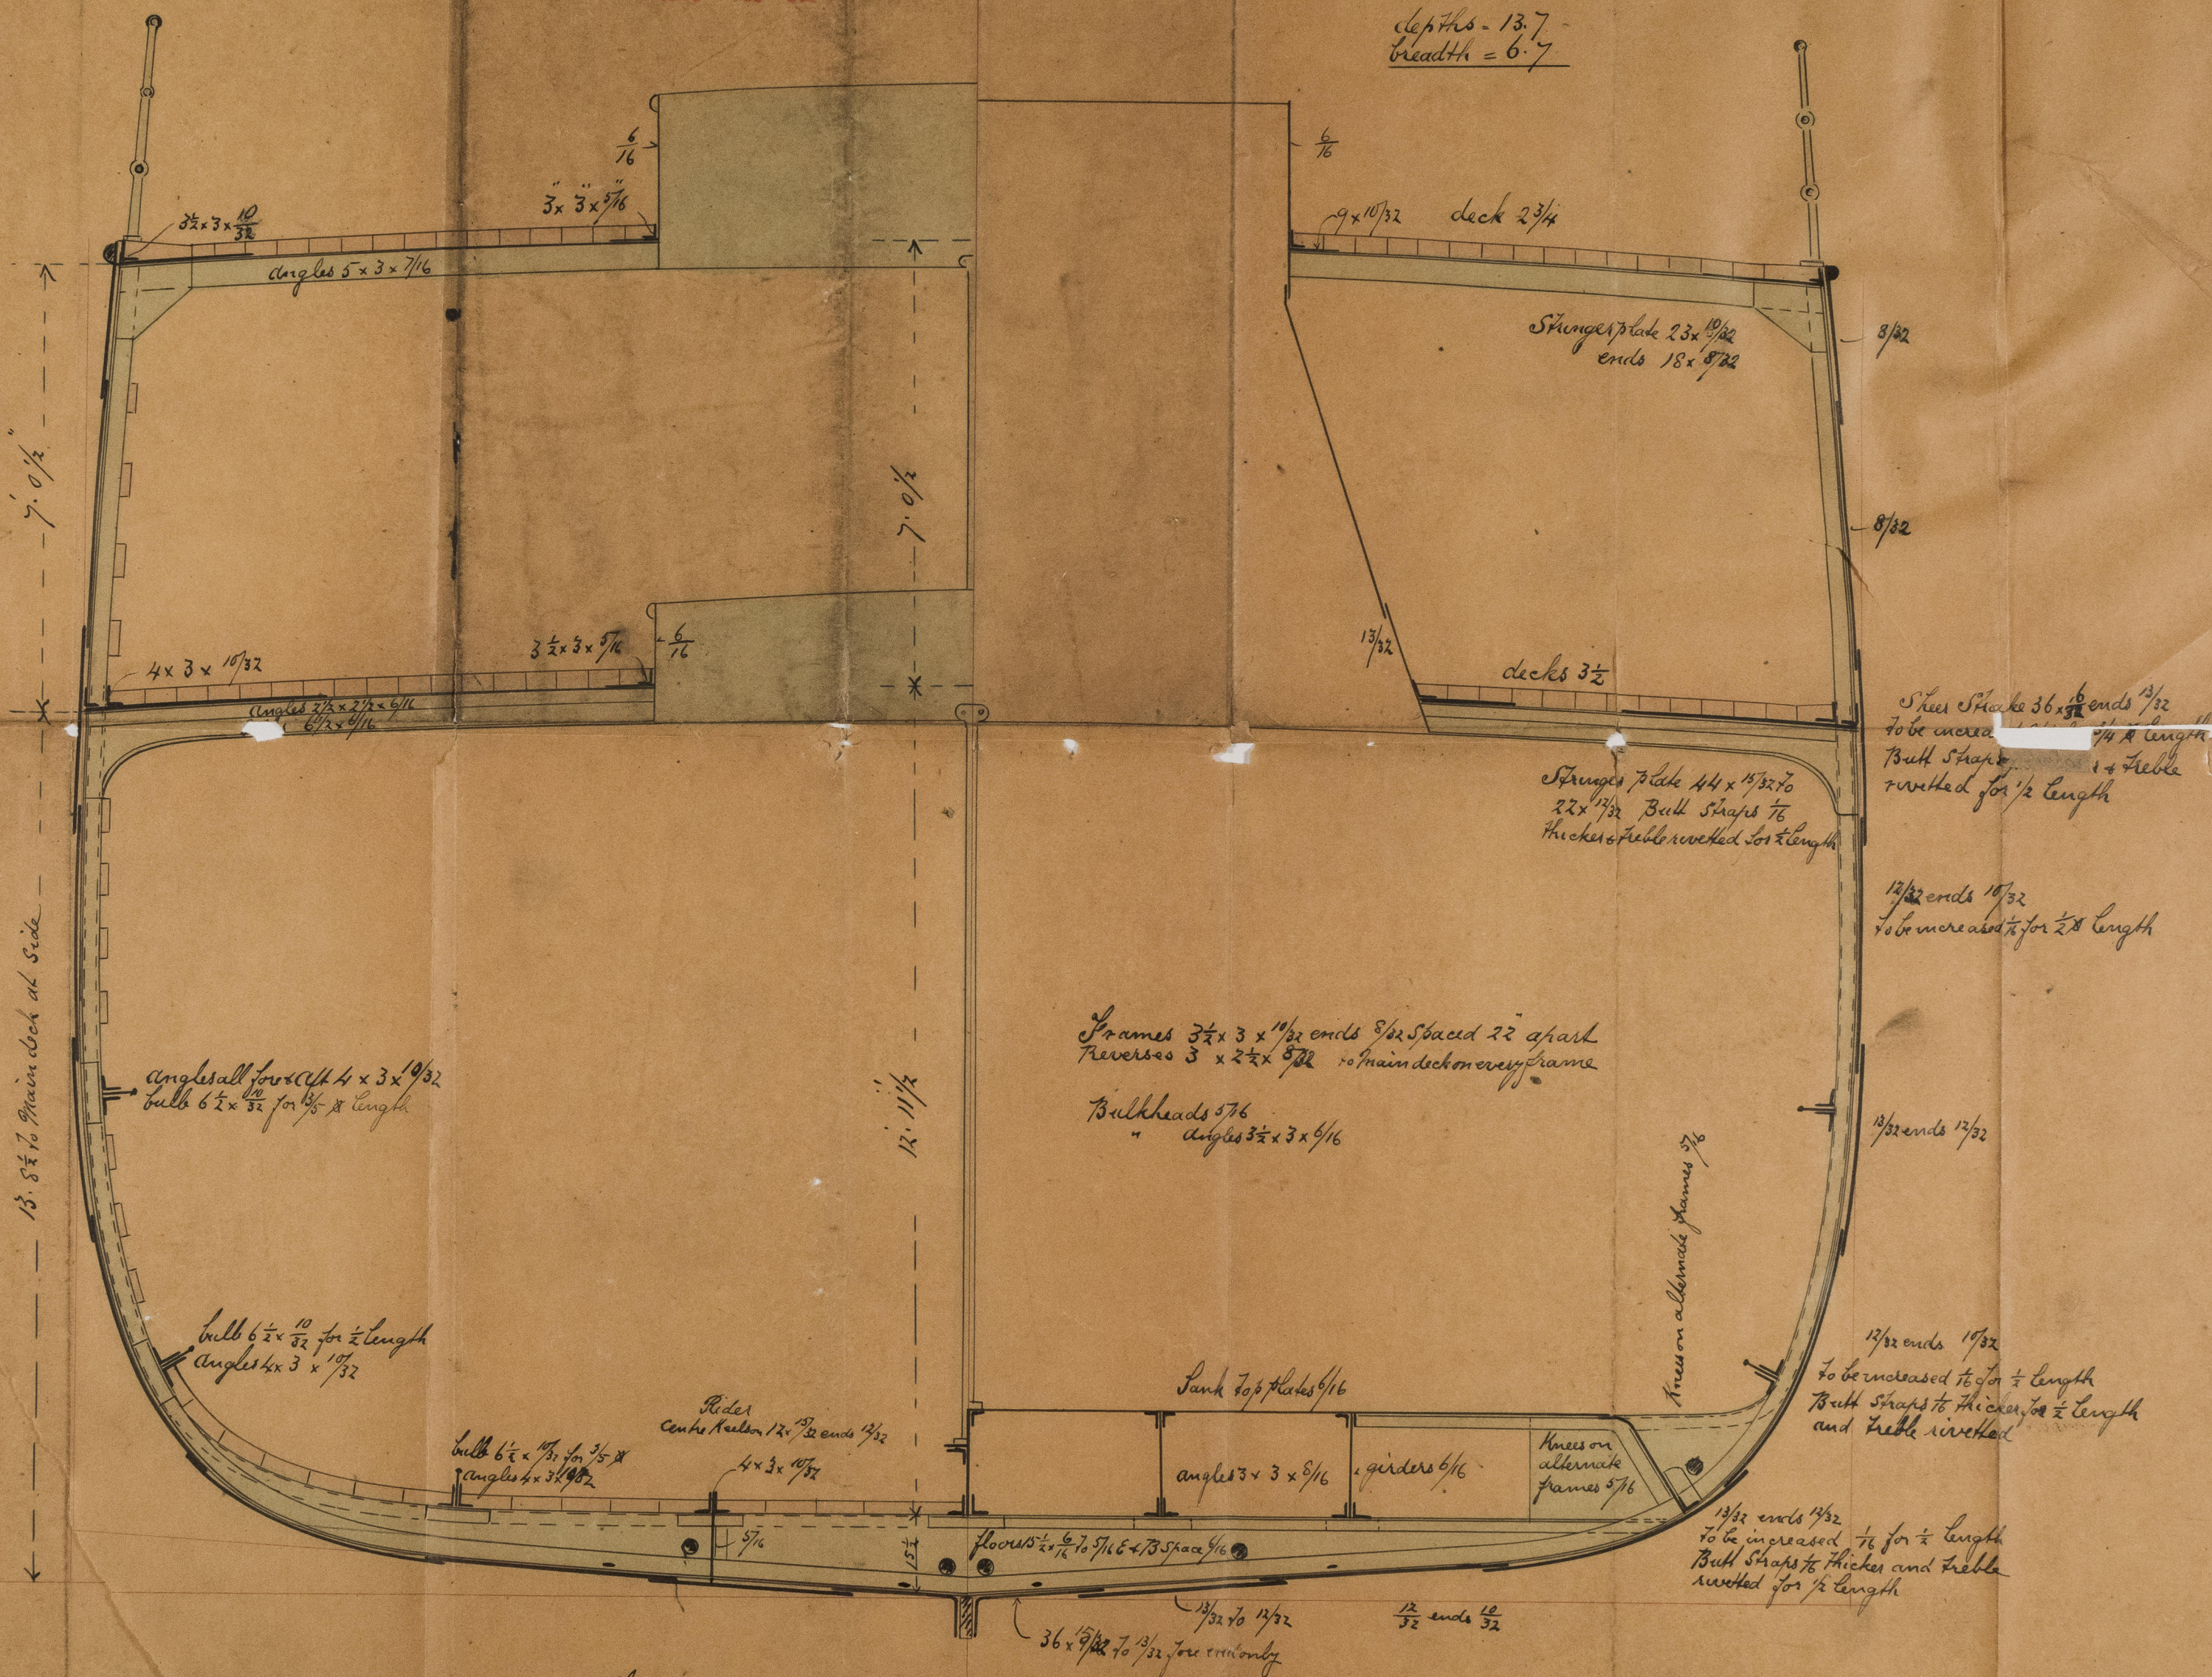

Forgings  
 Keel 7 1/2 x 2 1/2  
 Stem 6 3/4 x 2 1/2  
 Stem frame 6 3/4 x 4 1/4  
 Rudder head 4 x 4  
 " keel 2 3/4 -

Wigham Richardson  
 Newcastle-on-Tyne  
 1875

NWC194-0144