
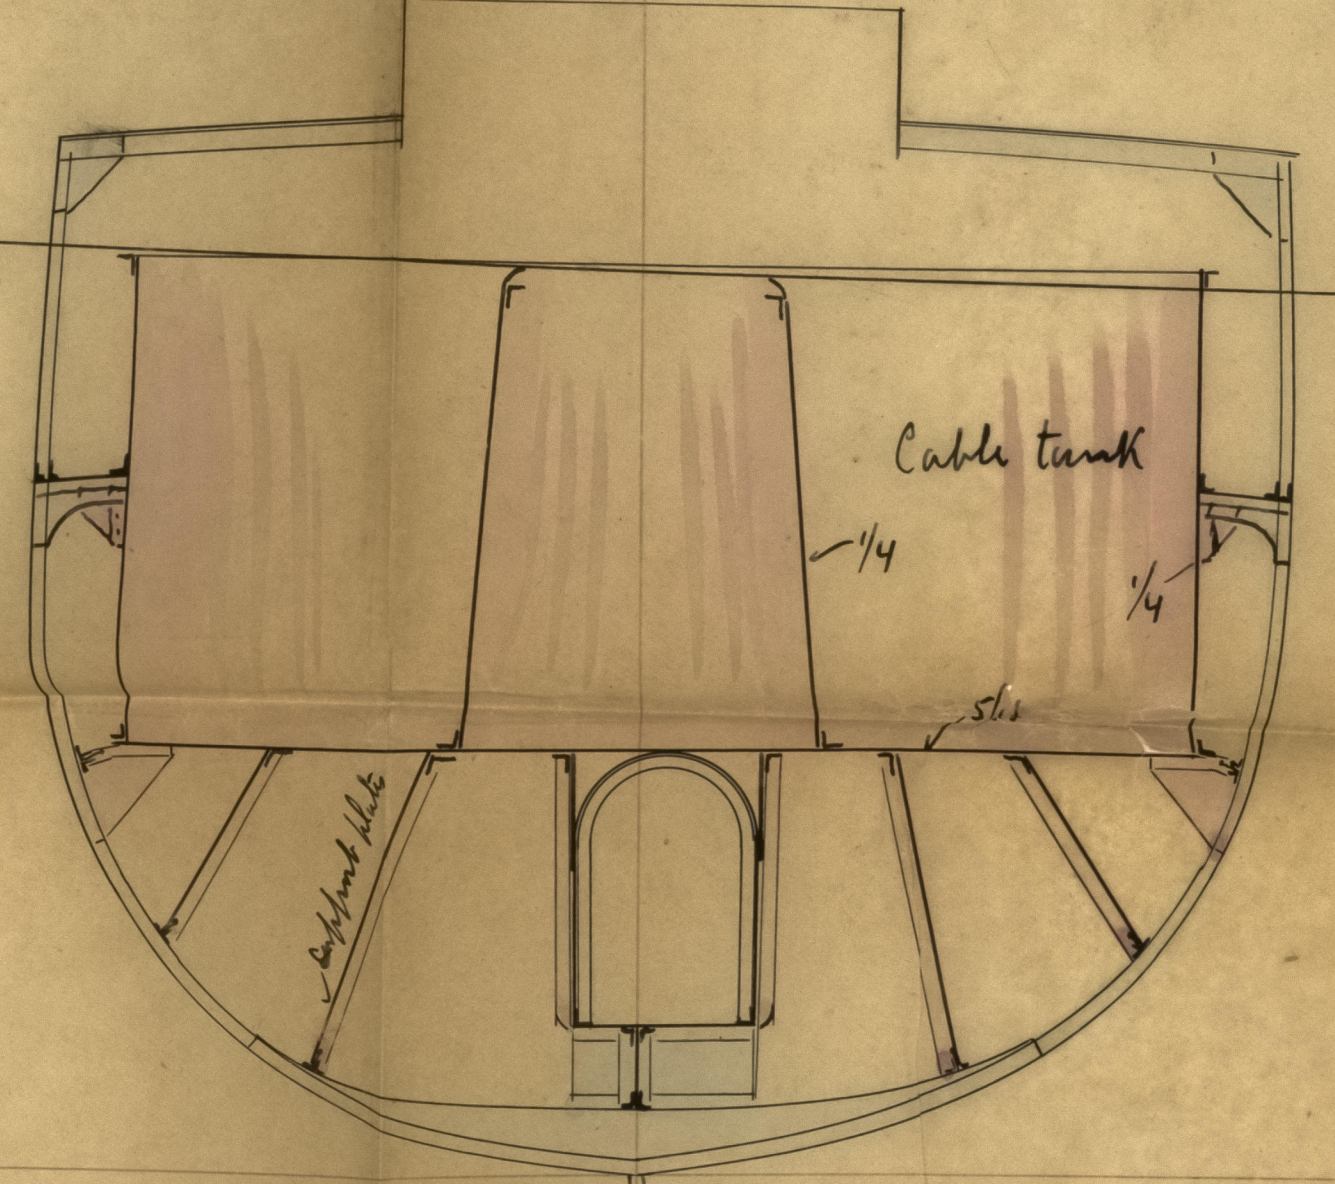


Rowing deck



Sec. Stm. "Buccaneer" Swc. Rept No. 18754

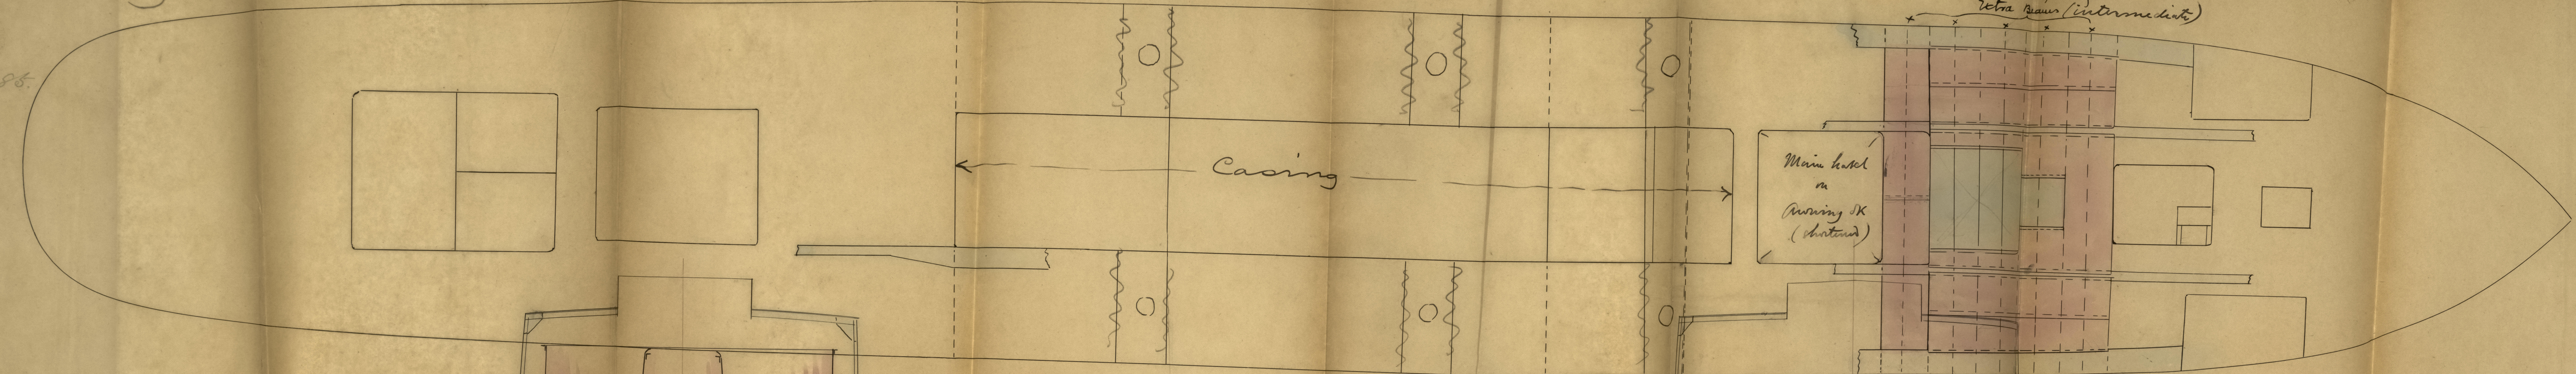

Vol 192
 S.S. "Buccaneer"
 Plan showing arrangement for
 Cable Tanks
 &c

Alterations & additions
in Red

Scale $\frac{1}{4}$ inch = 1 foot

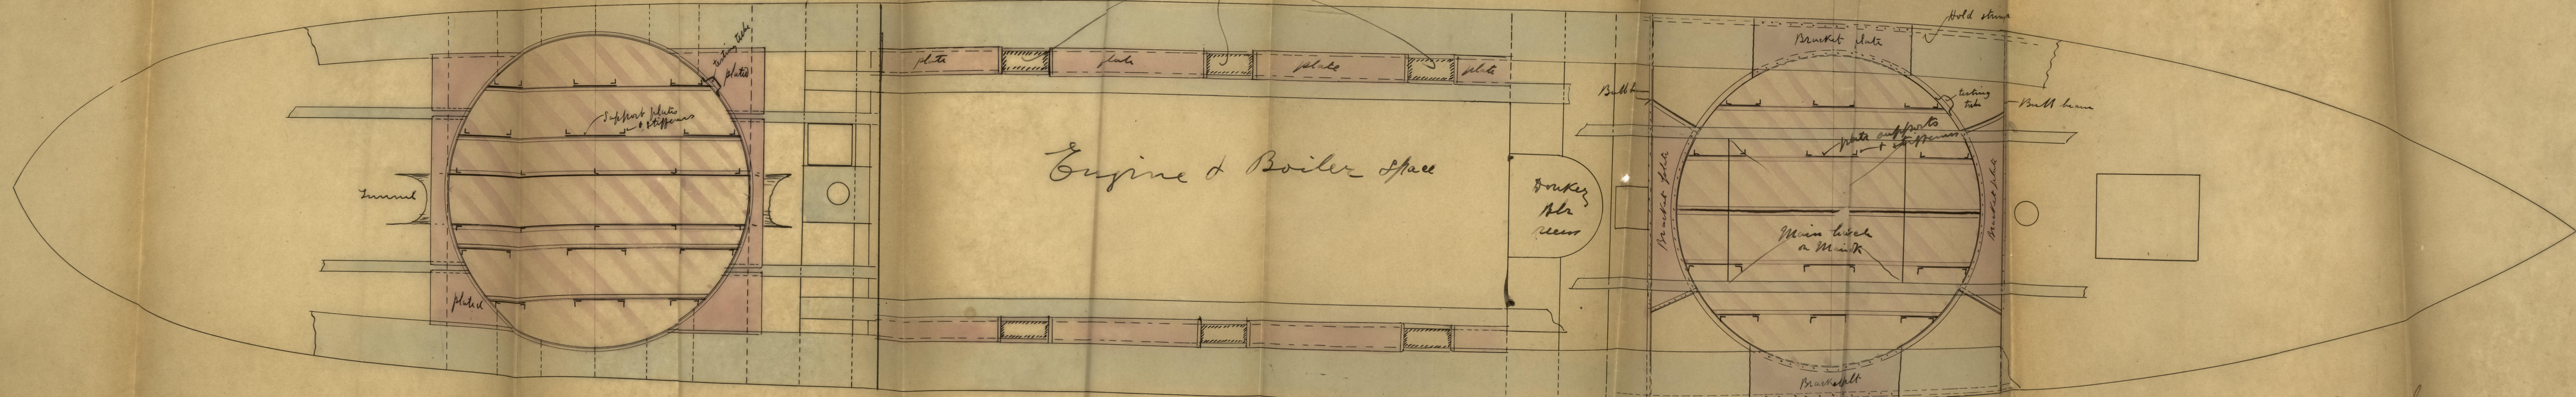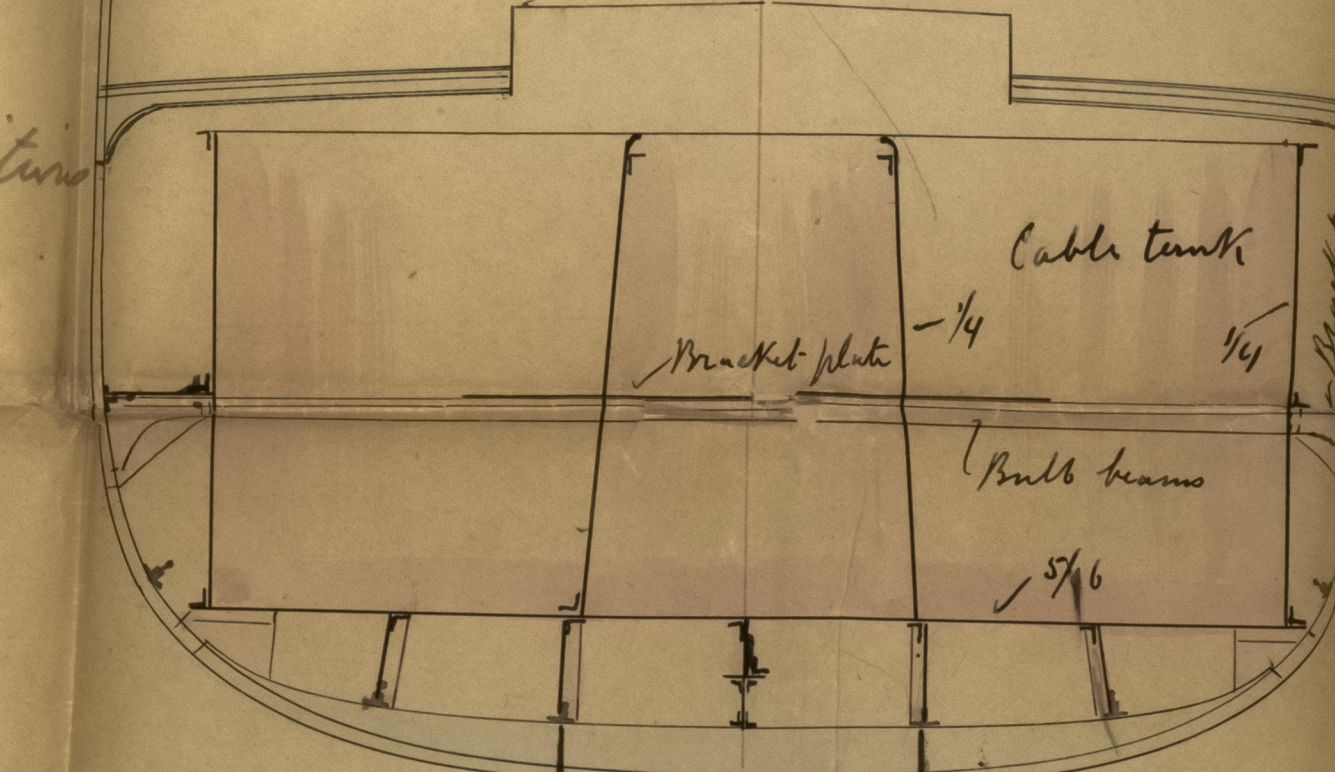

Engine & Boiler Space

Donkey
Blk
reem

Recd
 7/9/85
 Nippon Thomson &
 Newcastle upon Tyne
 5th Apr. 83