

# Lloyd's Register of British and Foreign Shipping.

(Report on Vessel No. \_\_\_\_\_ Port \_\_\_\_\_)

## No. 238.a. SHIP FORGINGS OR CASTINGS.

I have to report that the undermentioned Iron or ~~Steel~~ Forgings or Castings, manufactured by

*Wm. & March & Co.* of *Newcastle*

for the Vessel No. *192*, being built by *Wm. & Richardson & Co.*

of *Newcastle* have been inspected by me as set forth below, and found

to be, so far as can be seen, *sound and efficient.*

The words FORGINGS or CASTINGS, IRON or STEEL, should be struck out as may be required.


Mark on Forgings.

**Lloyd's**  
No. 238.a.

*Hugh Cameron*  
*Sunderland.*

	STERN FRAME.	RUDDER FRAME.	STEM.
Material*	<i>Scrap Iron</i>	<i>Scrap Iron</i>	<i>Scrap Iron</i>
How made	<i>Forged</i>	<i>Forged</i>	<i>Forged</i>
Dimensions	<i>6 3/4" x 4 1/4"</i>	<i>4 3/4" - 2 3/4"</i>	<i>6 3/4" x 2 1/8"</i>
Progress on Inspection	<i>Smithing</i>	<i>Forged &amp; Smithed</i>	<i>Forged</i>
Dates when Inspected	<i>Feb 9-13/85</i>	<i>Feb 25 March 3-11-19-23/85</i>	<i>Feb 9/85</i>

SKETCHES OF FRAMES SHEWING POSITION AND DESCRIPTION OF WELDS OF FORGINGS, OR PARTICULARS OF TESTS APPLIED TO CASTINGS.

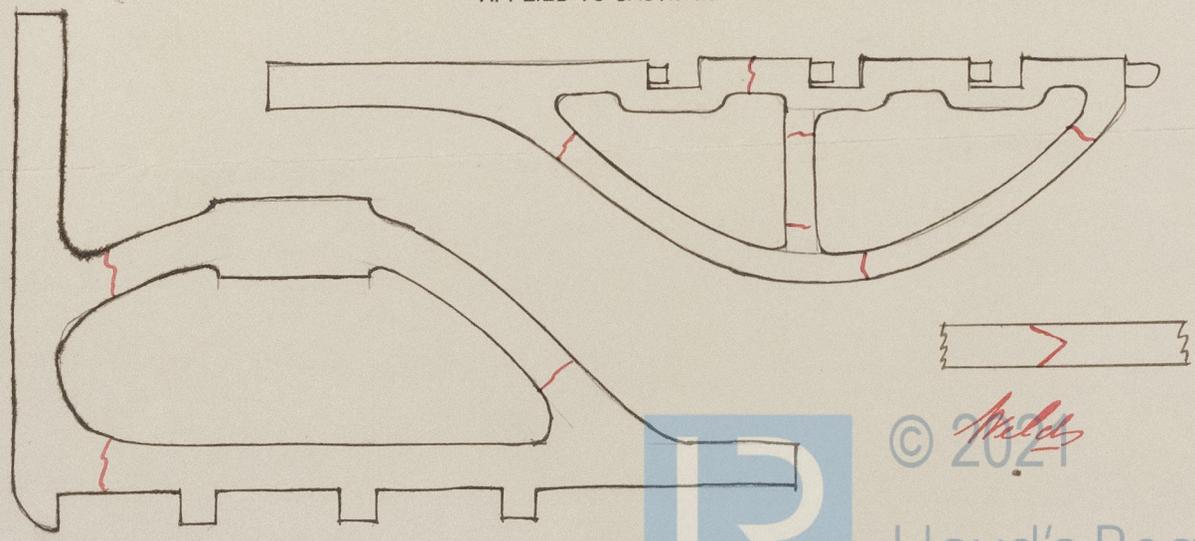

© 2021 *M&L*

Lloyd's Register  
Foundation

\* If of Iron, state whether scrap or puddled Iron.

238

13/4/85

W Richardson & Co's No. 192  
S.S. "Buccaneri"  
Kwc. Report No. 18754



© 2021

Lloyd's Register  
Foundation