

Freeboard Report No. 19424

MIDSHIP SECTION FOR A STEEL SCREW STEAMER

TO CLASS 100A1 SPAR DECKED

PRINCIPAL DIMENSIONS

LENGTH FOR LLOYDS _____ 338.50


BEAM MOUNTED 39-0

DEPTH TOP OF FLOORS TO UNDERSIDE } - 27 6
OF SPAR DECK ANTIOSHOIPS

SCALE $\frac{1}{2}" = 1 \text{ FOOT.}$

Dr: & Merc:

20/11/84

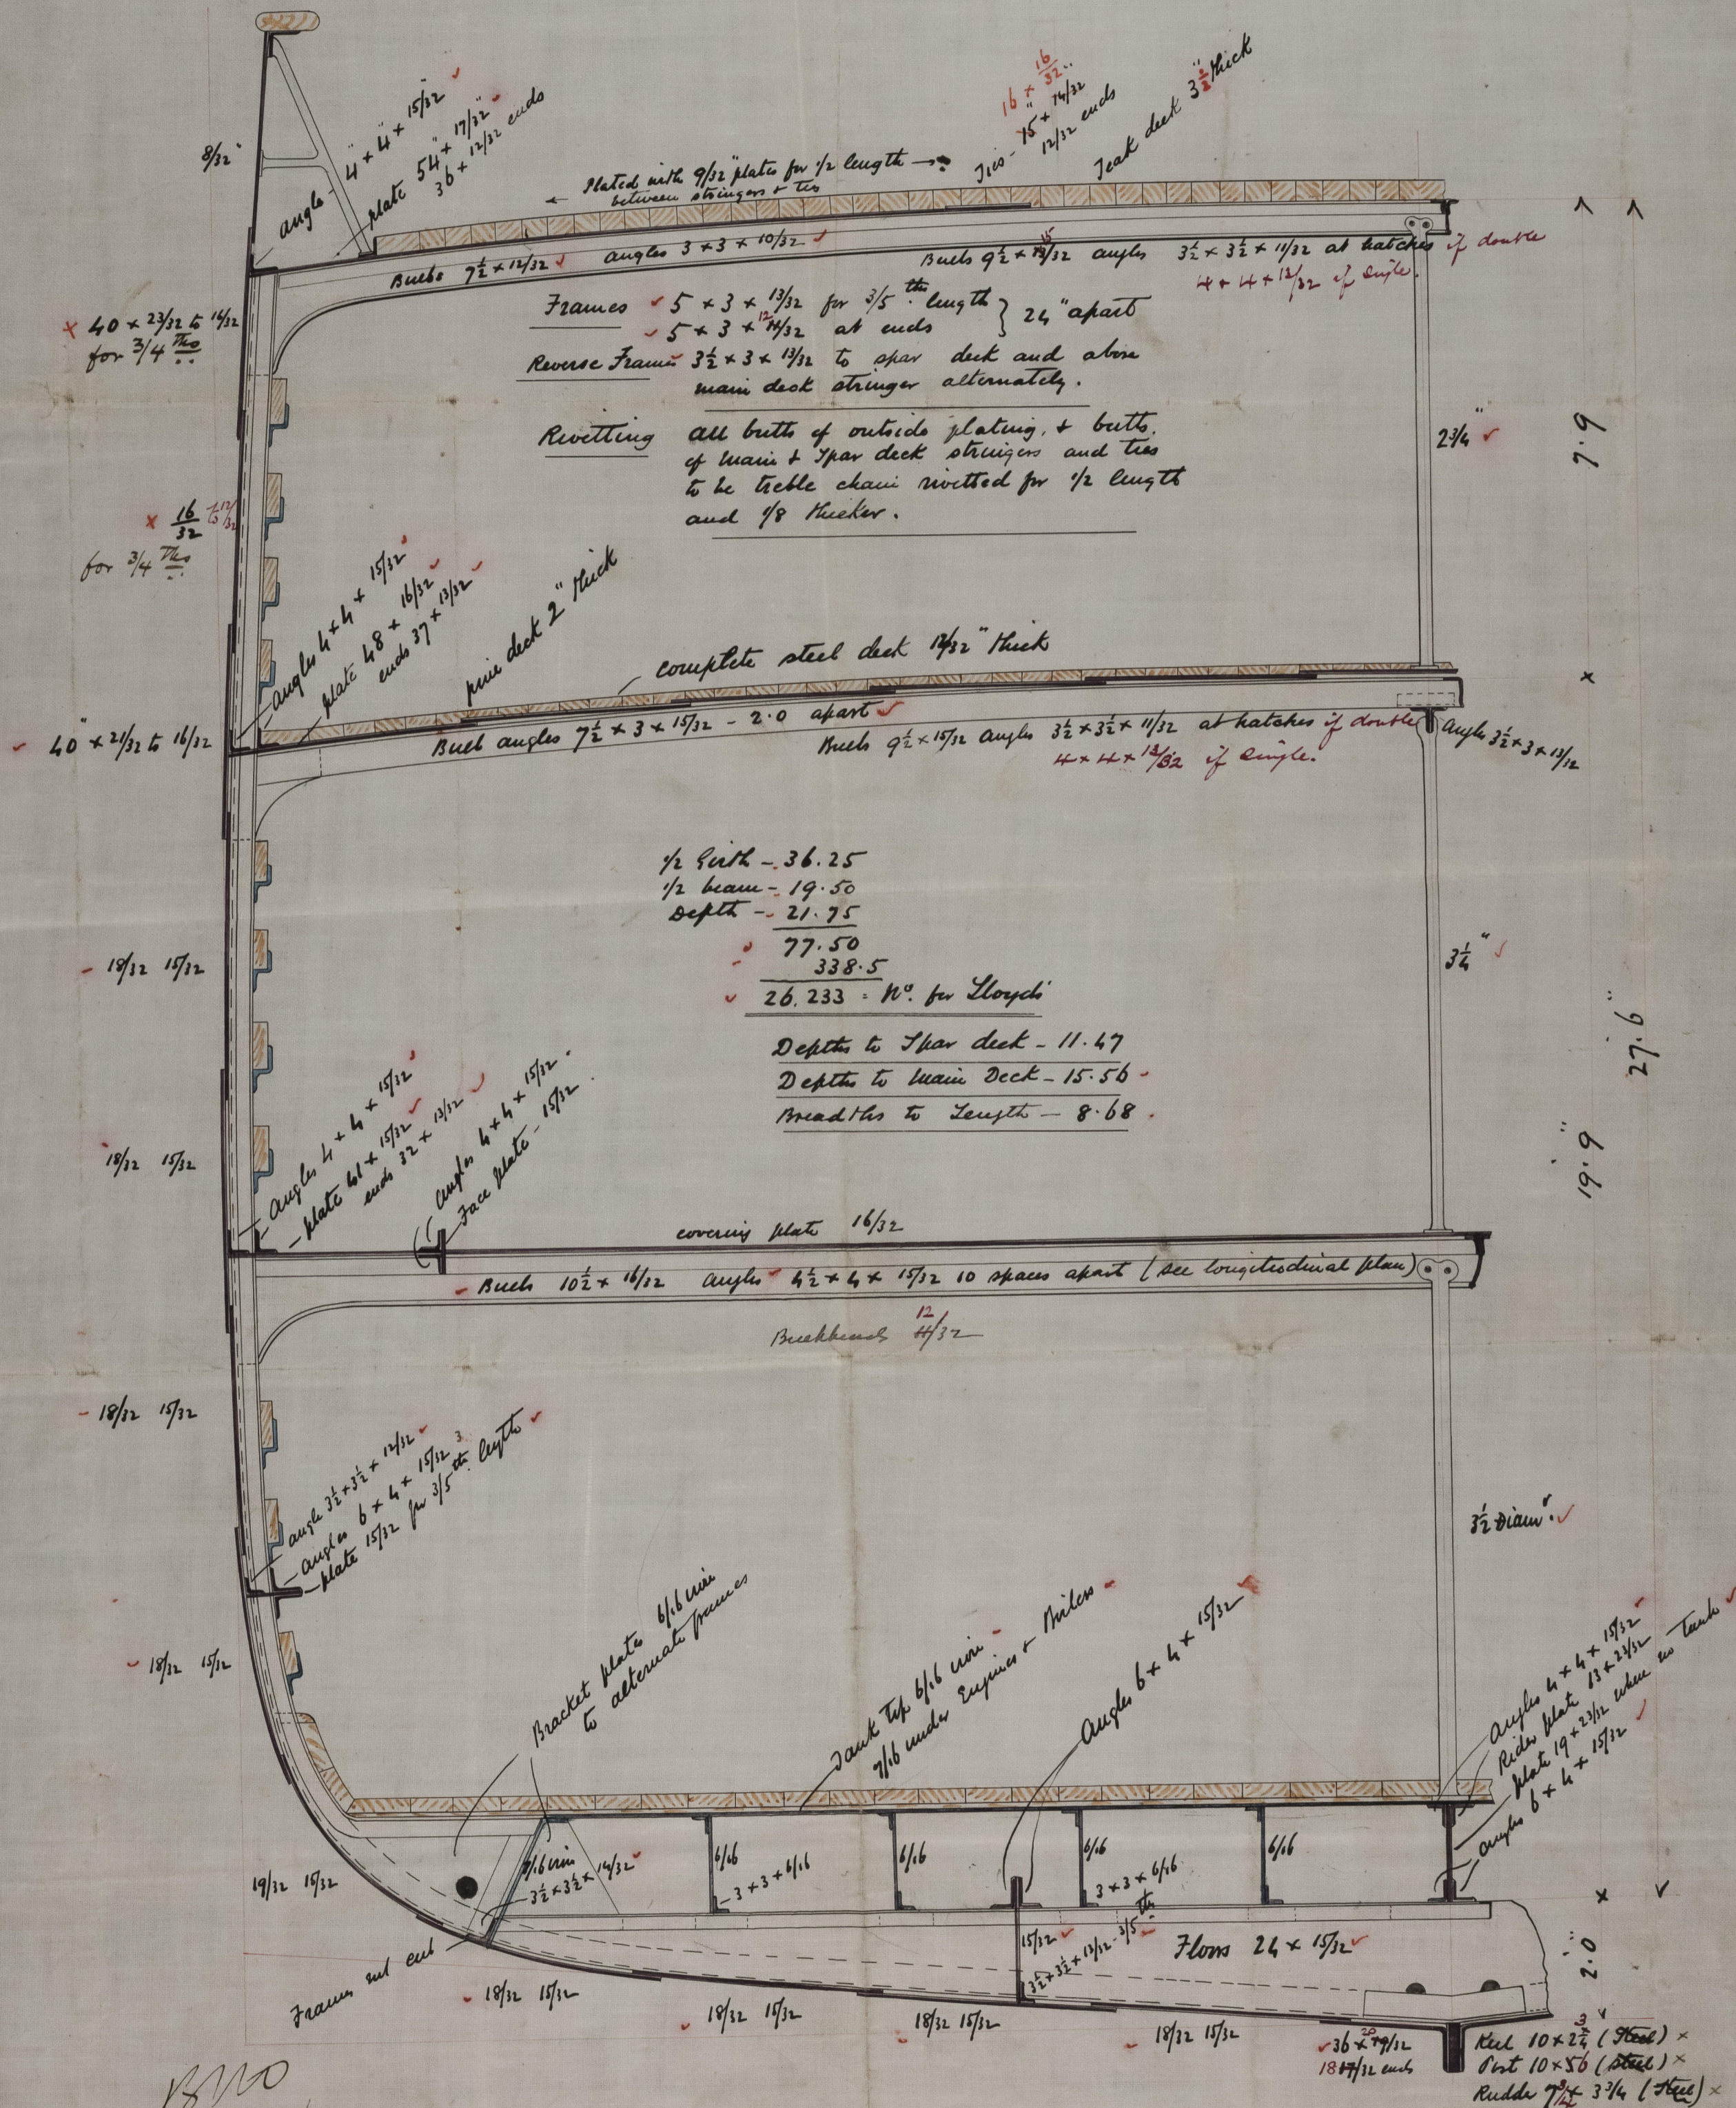

BMO
20711/84

1910-56E3MN



22/11/17
24/12



Nº 258

1910-5677M



22/11/17
24/12



© 2021
Lloyd's Register
Foundation

WIDENB 22/10/17 21/11/17 20/12/17

22/11/17 24/12