




S.S. "Port Pirie" Inc. Report No. 19441  
No 258 SHIP. Freeboard Report No. 19424

Dr. to Pwce.  
20/11/84.

LONGITUDINAL SECTION FOR A STEEL SPAR DECK STEAMER TO CLASS 100 H1

PRINCIPAL DIMENSIONS	
LENGTH FOR LLOYDS	338-50
BREADTH (MOULDED)	39-0
DEPTH	
{ TOP OF KEEL TO UNDERSIDE OF SPAR DECK AMIDSHIPS	29-6
{ DEPTH TO UNDERSIDE OF MAIN DECK	21-9
SCALE 1/8" = 1 FOOT	

1/2 GIRTH 36-25  
1/2 BREADTH 19-5  
DEPTH 21-75  
27-50  
38-0  
36-25 H<sup>1</sup> FOR LLOYDS  
DEPTH TO SPAR DECK 11-47  
" MAIN DECK 15-55  
BREADTH TO LENGTH 8-65

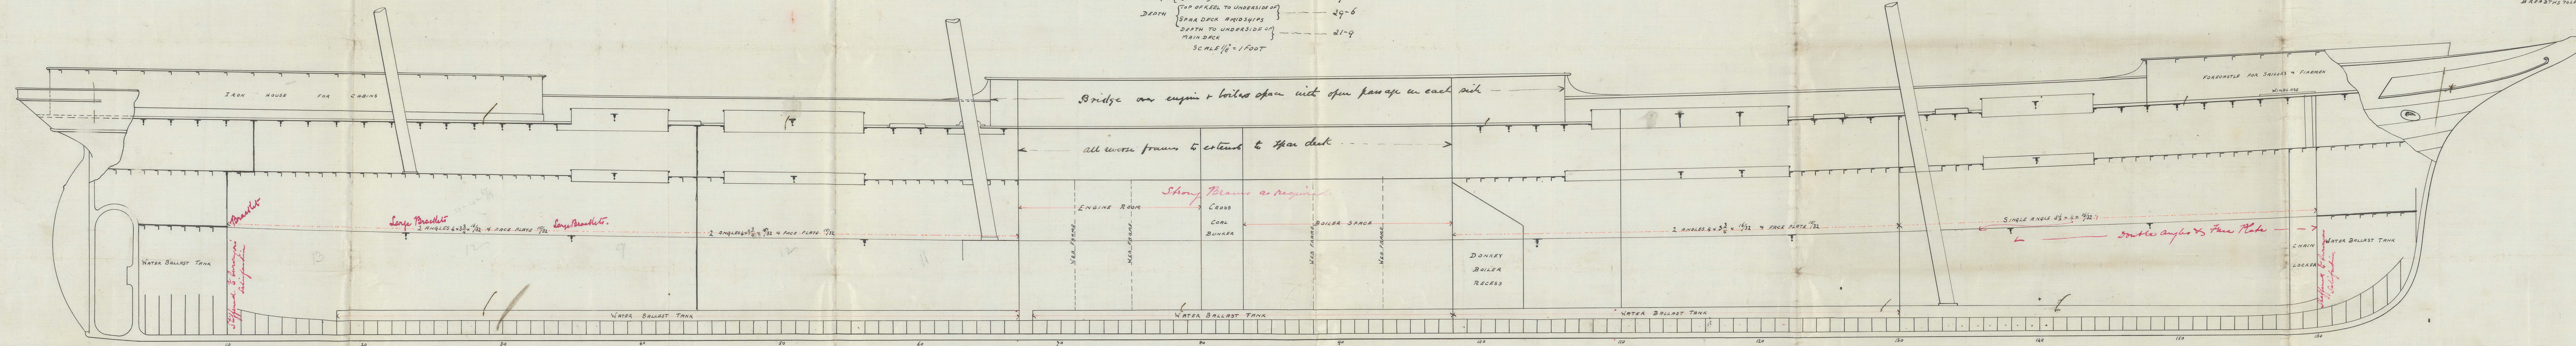

14/11/84