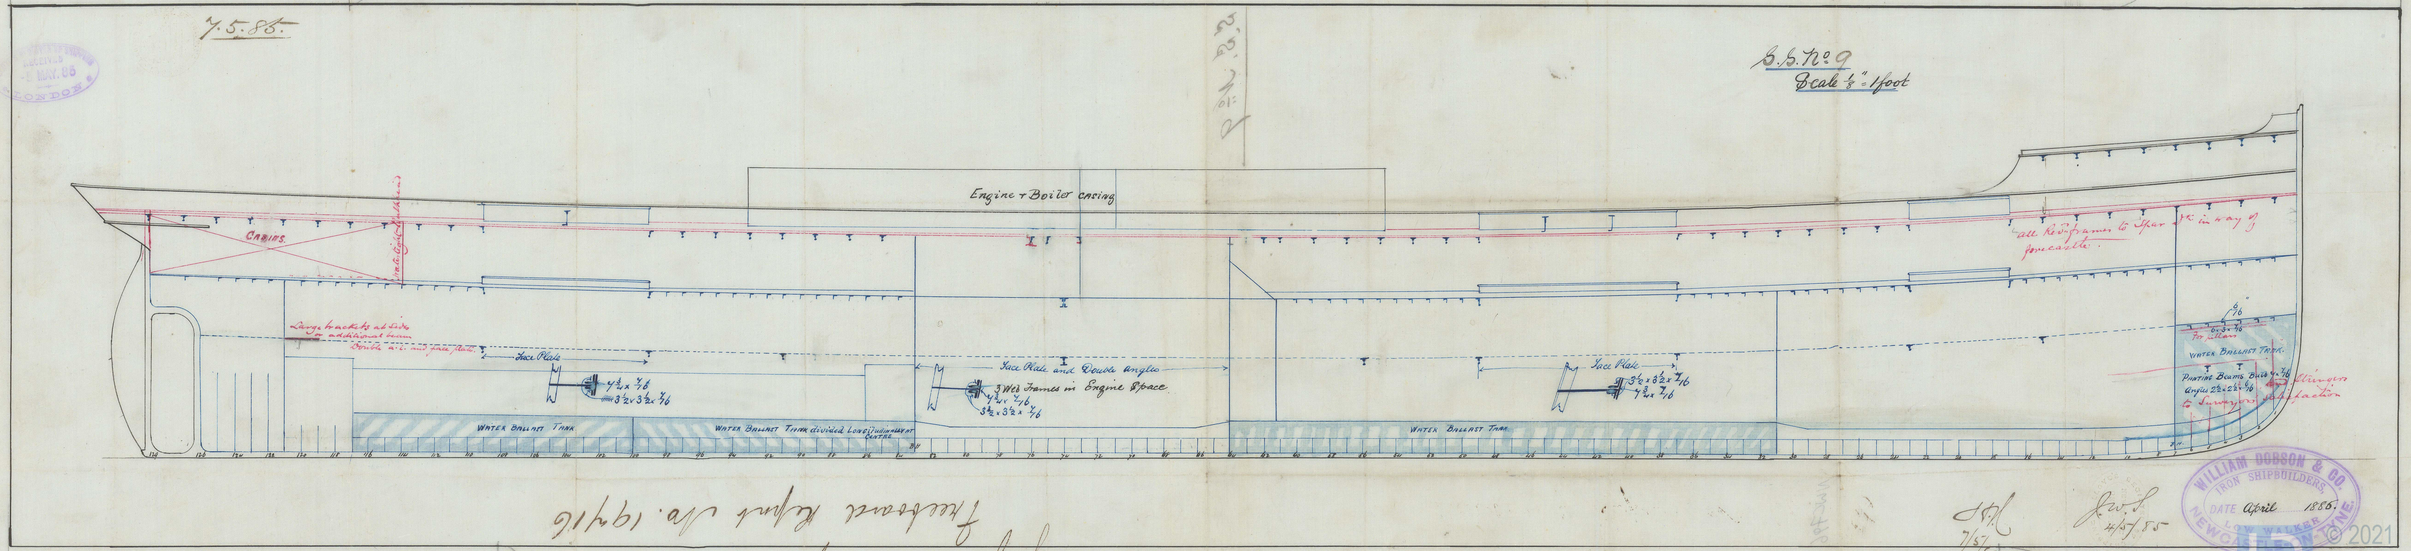

© 2021
Lloyd's Register Foundation

S. S. No. 9


Freeboard Report &c.

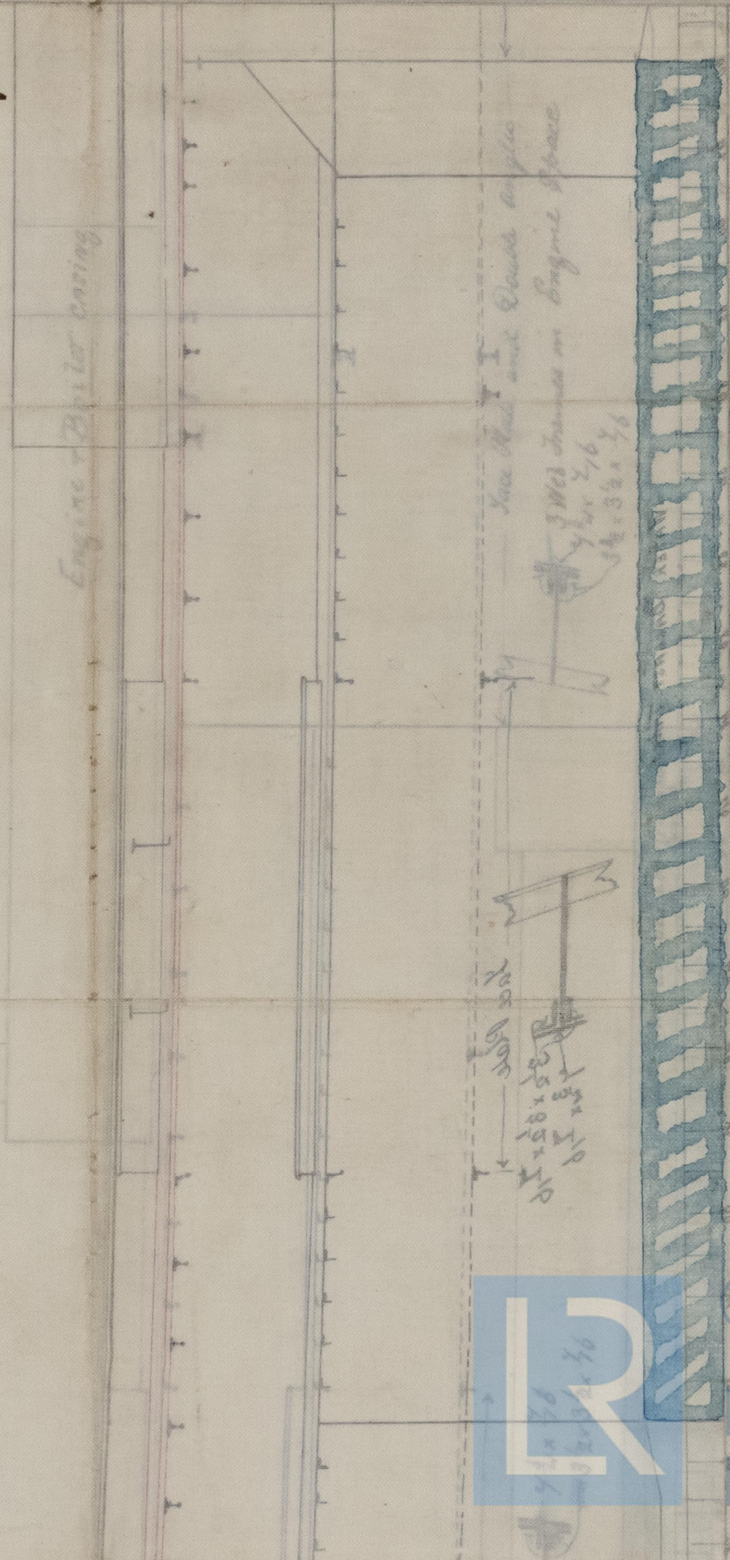

© 2021 Lloyd's Register Foundation

NWC796 - 0094