


dr. to Acc.
20/5/85.

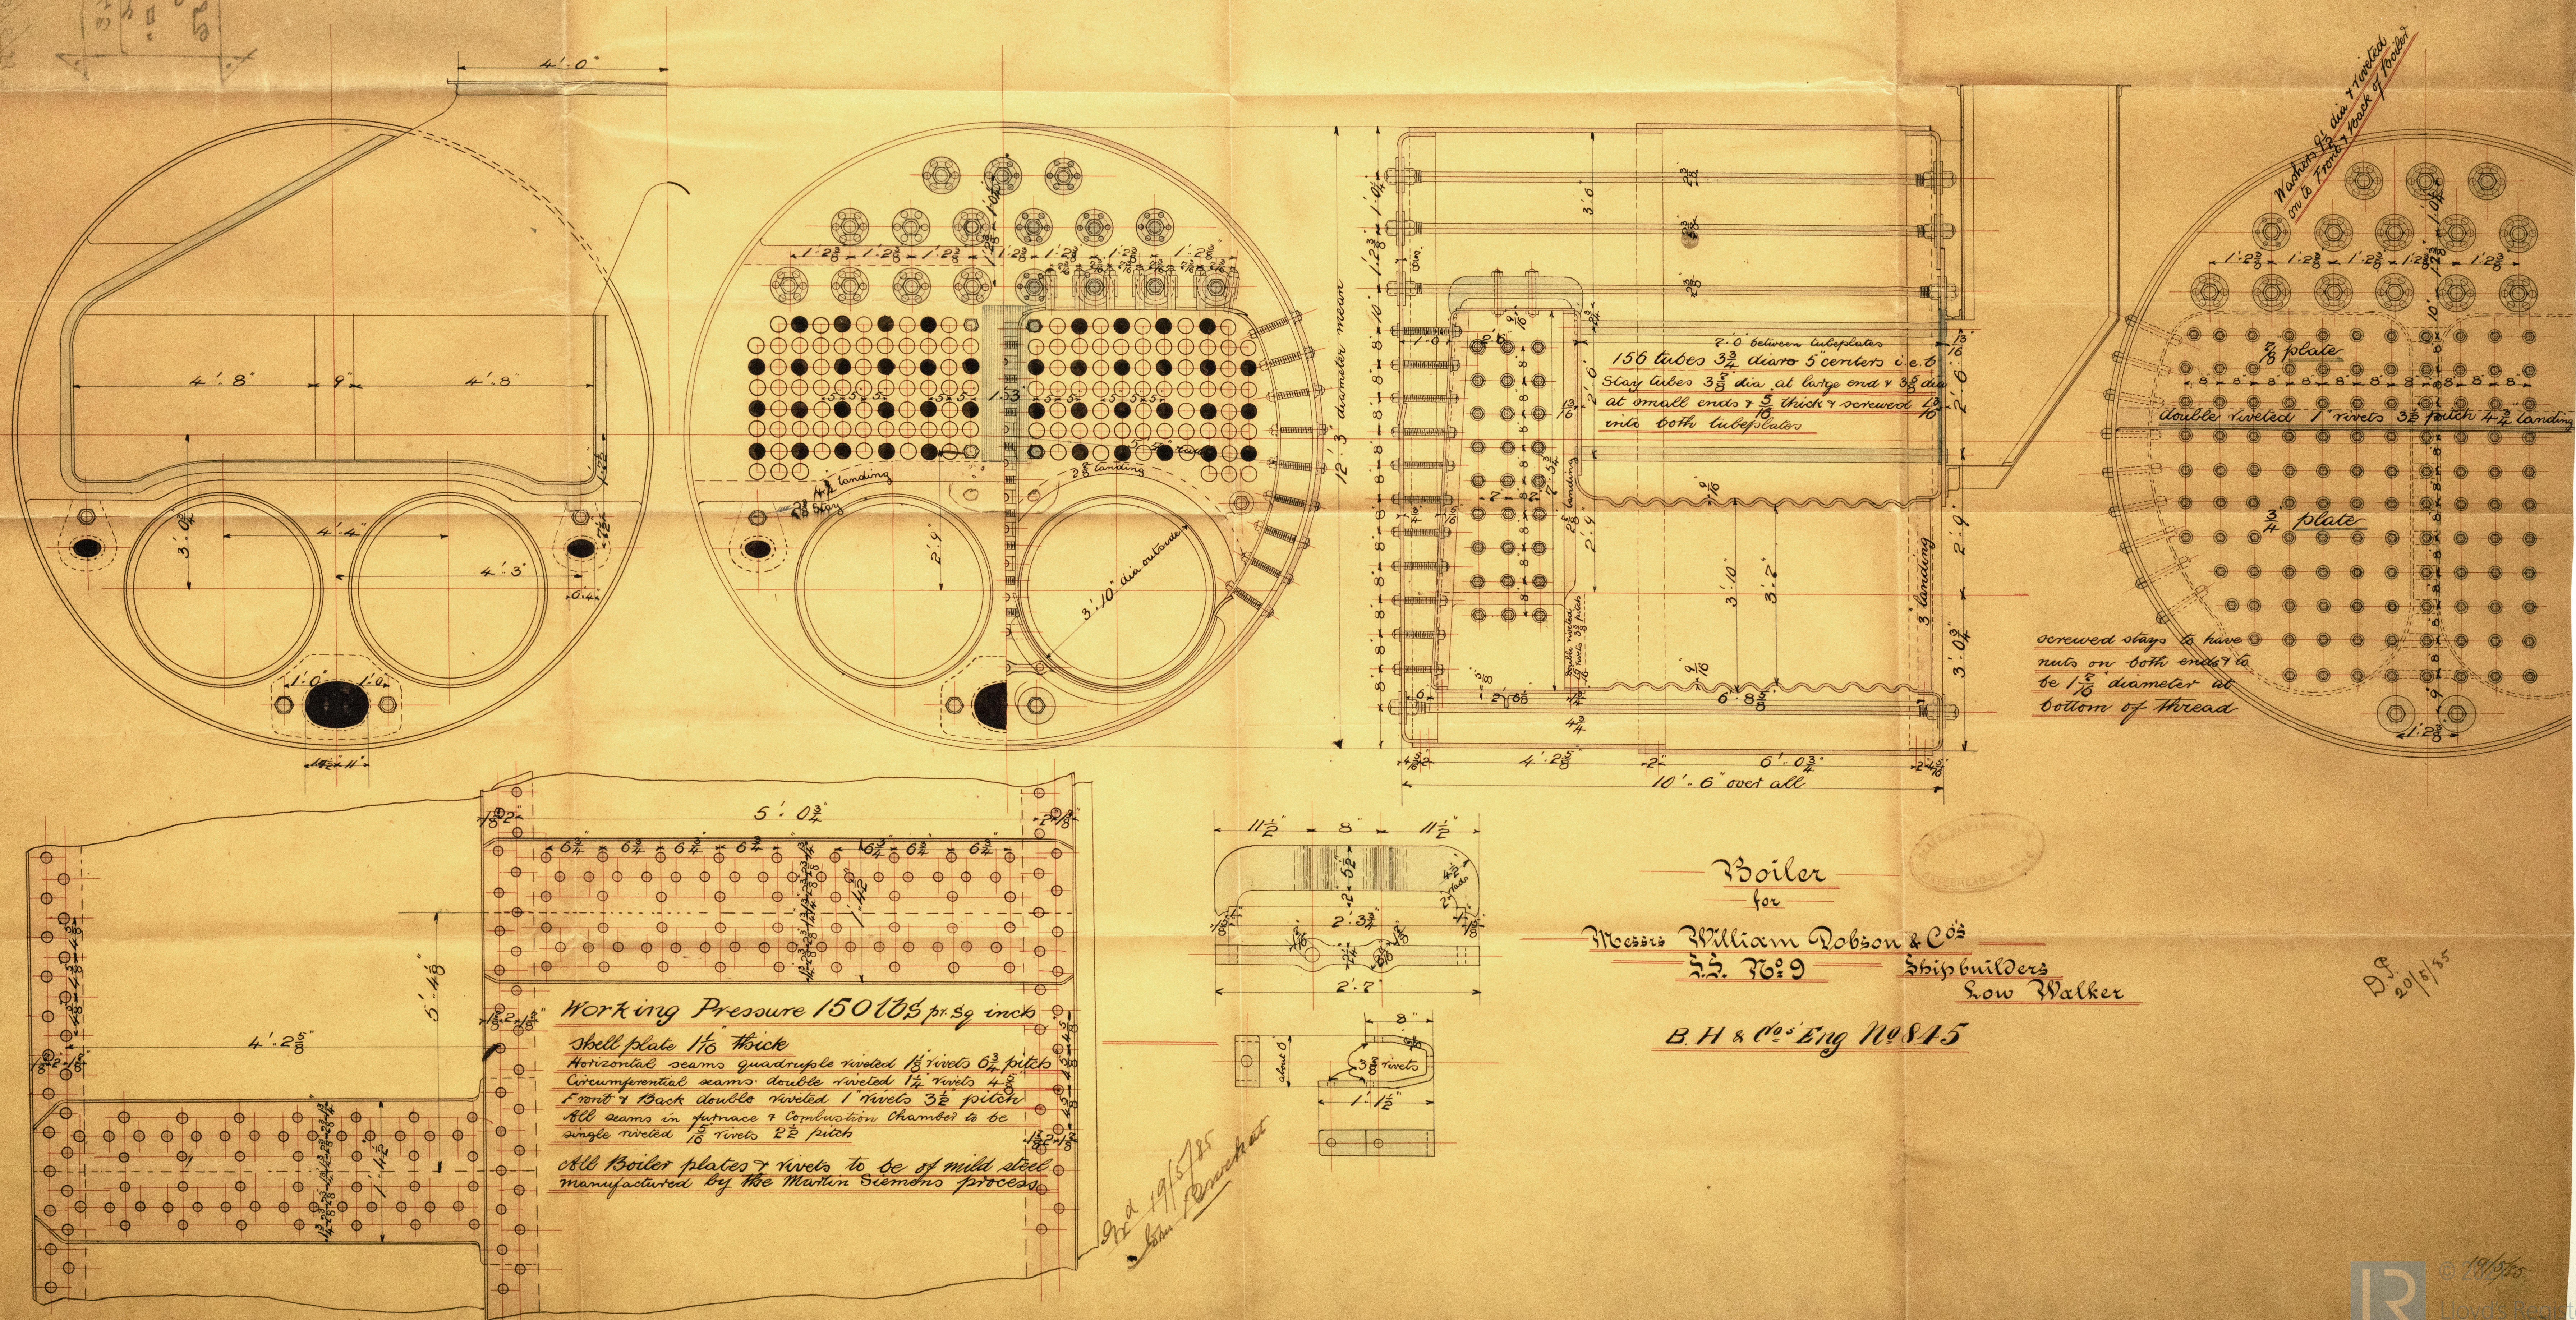

Boiler
for

Messrs William Robson & Co^s

Shipbuilders
Low Walker

B. H & Co's Eng No 845

D. J. 20/5/85

Robert & Co

9 barrel

20/5/85-

Nº 2143
Lloyds Est
300 lbs. 10"
J B
26-8-86



© 2021

Lloyd's Register
Foundation

NWC 796 - 0095