

Freeboard Report No. 19416

Scale $\frac{1}{2}'' = 1 \text{ foot}$

7.5.85-

$\frac{1}{2}$ Gerfte. 31-0 ✓
 $\frac{1}{2}$ Breaath 16-9 ✓
 Repete 18.625 ✓
66.525 ✓
 24767 ✓
465675
 399150
 465675
 266100
133050
 1647624675 ✓


Depth 13.2 ✓
Breadth 7.3 ✓

Breadth 7.3 ✓

~~hammered for Galt 2/27/21~~ ✓

Numerical for 6 outfit Notice No. 576 = 20425
Steel

Class 100A Spar Deck Steel

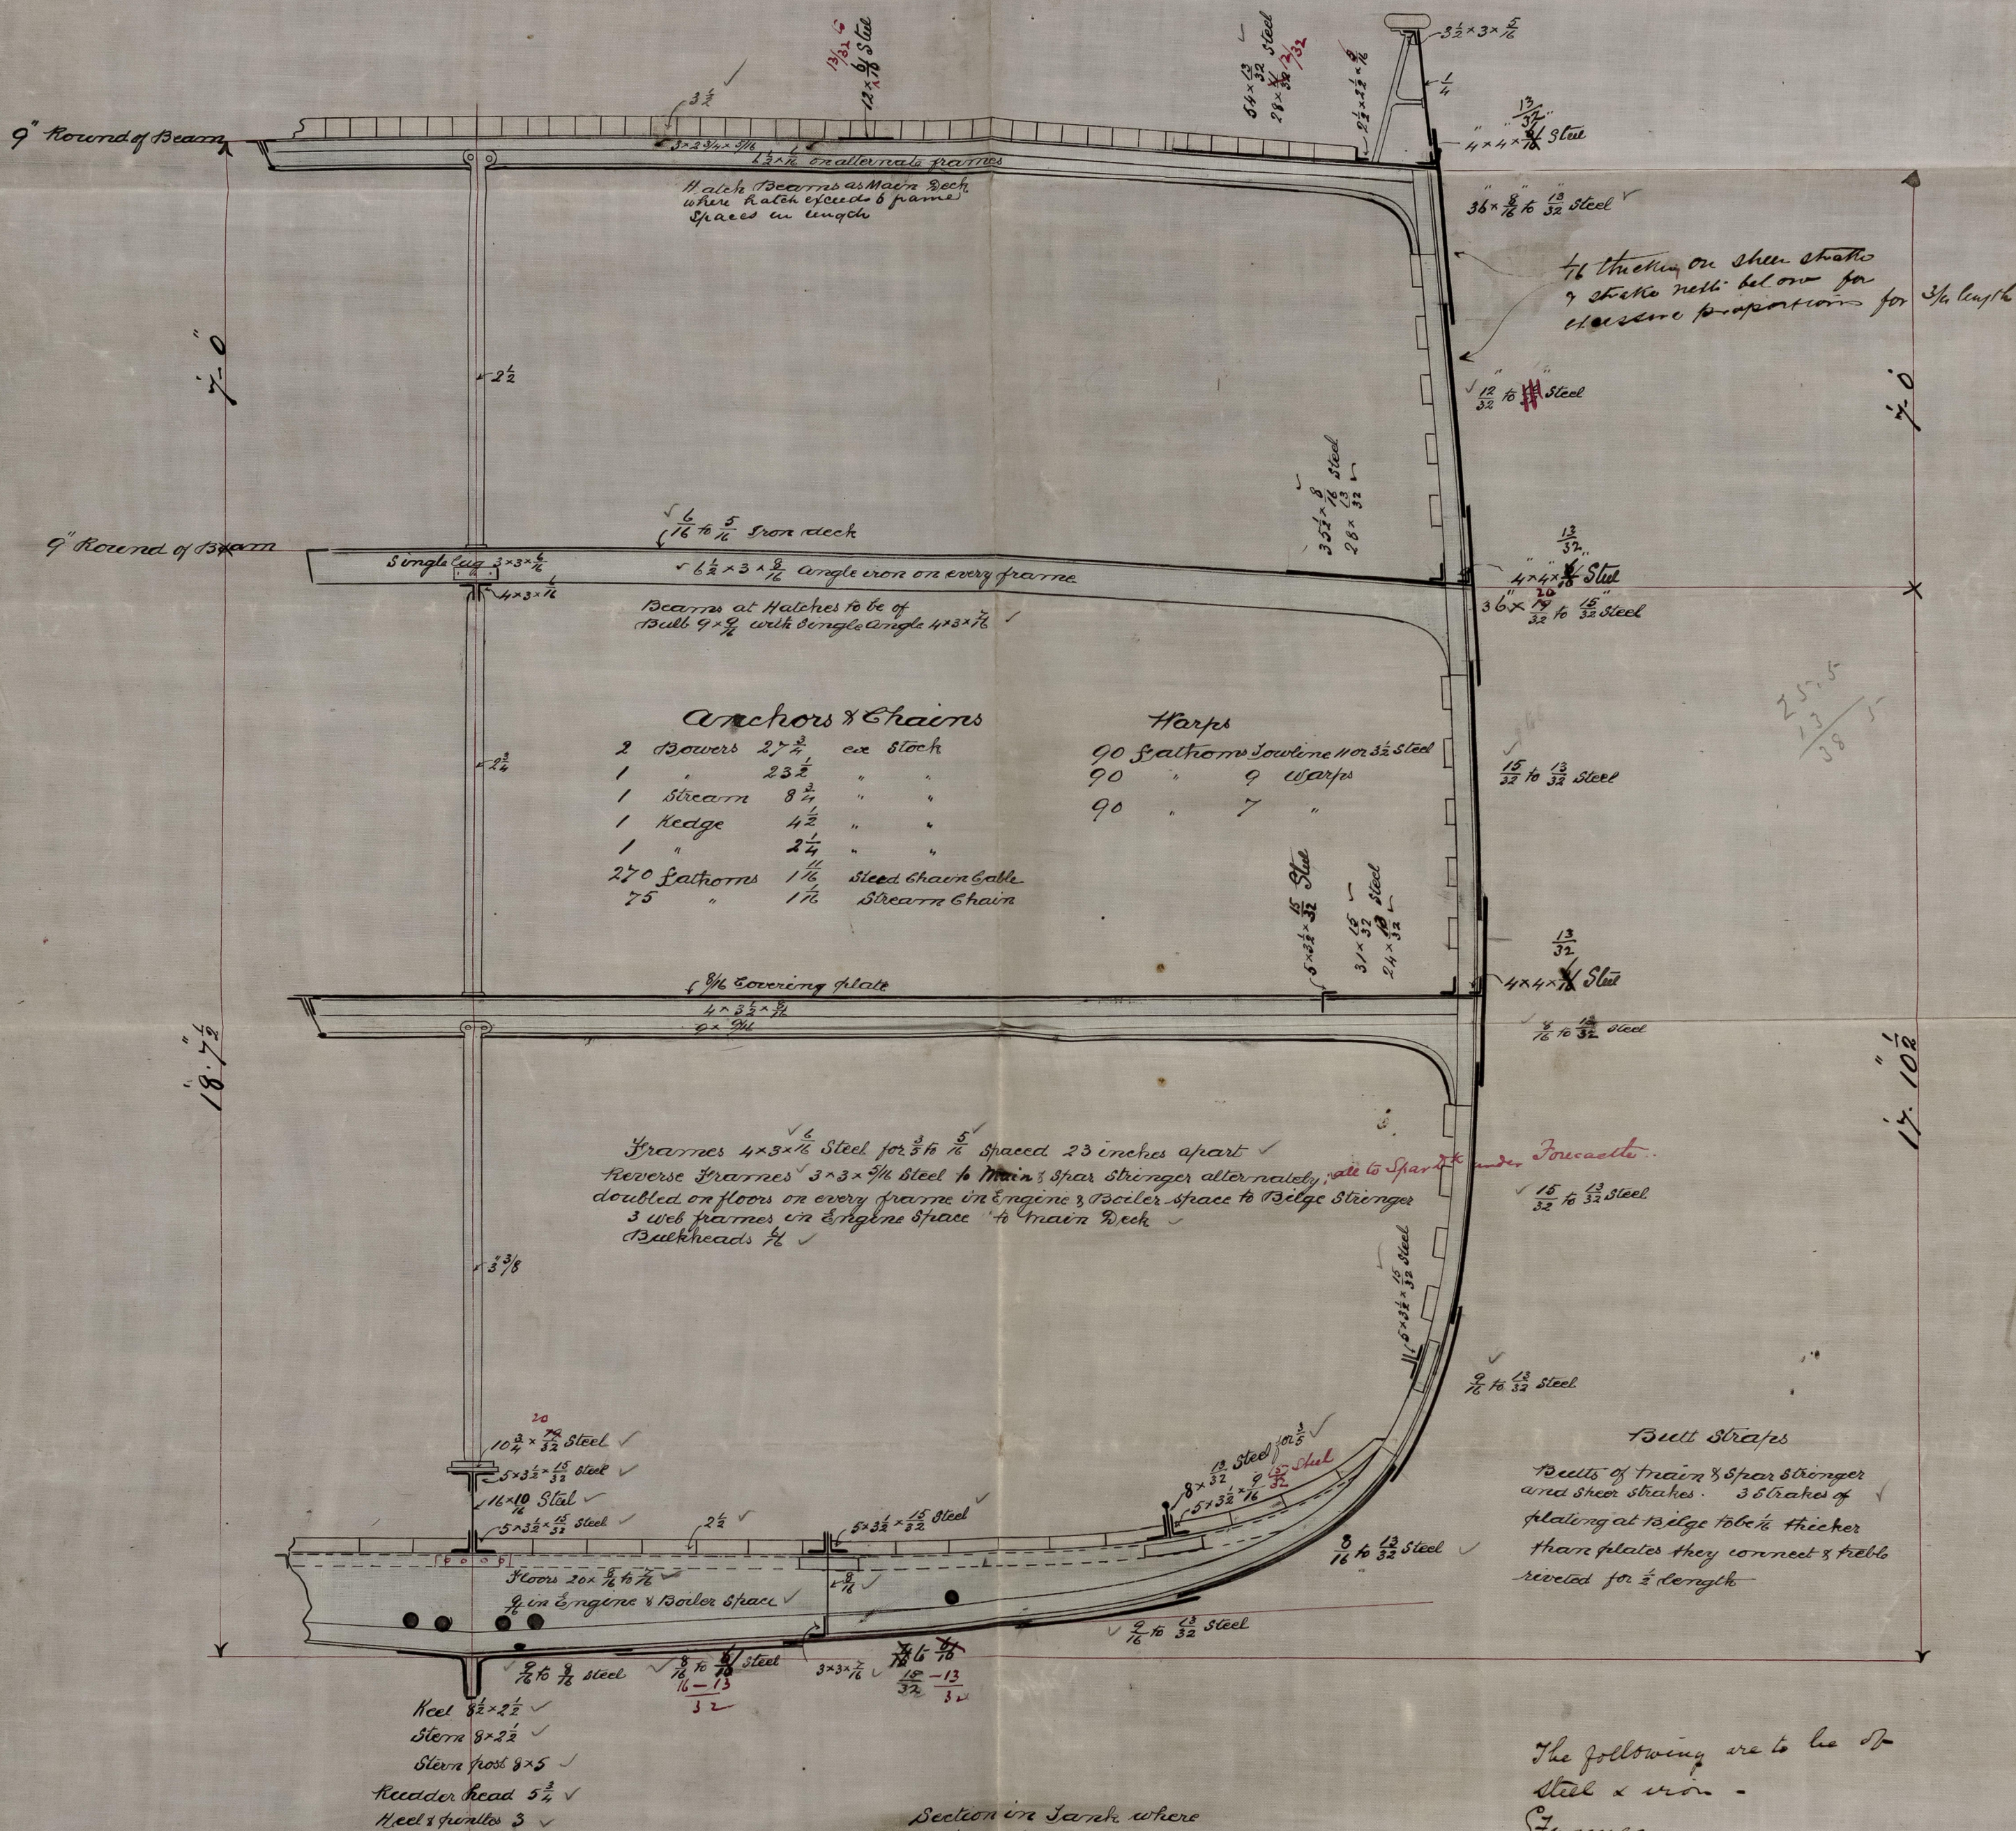

The following are to be of
steel & iron -
Frames
Heavy frames
Keelsons
Stringer on the decks & angles.
outside plating to Spar deck

7 floors
Beams
Bulkhead
Double bottom
Keel
Decks
and other parts such as casing's
Coaming's &c.

WILLIAM DOBSON & CO.
IRON SHIPBUILDERS.
DATE _____
LOW WALKER
NEWCASTLE-ON-TYNE.

© 2021

Lloyd's Register
Foundation

NWC796-0096

No 9

NWCMN







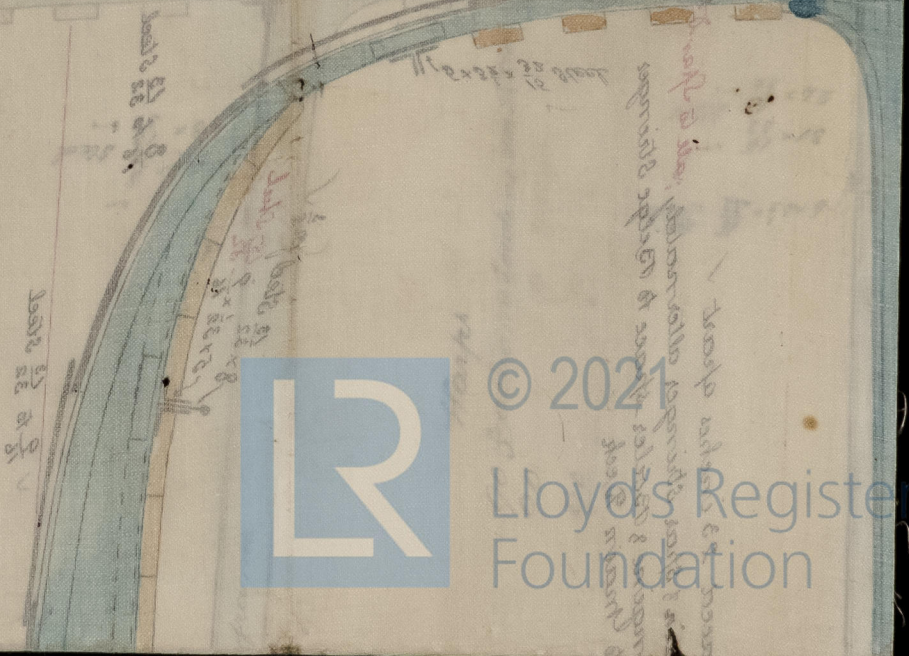

© 2021
Lloyds Register
Foundation