
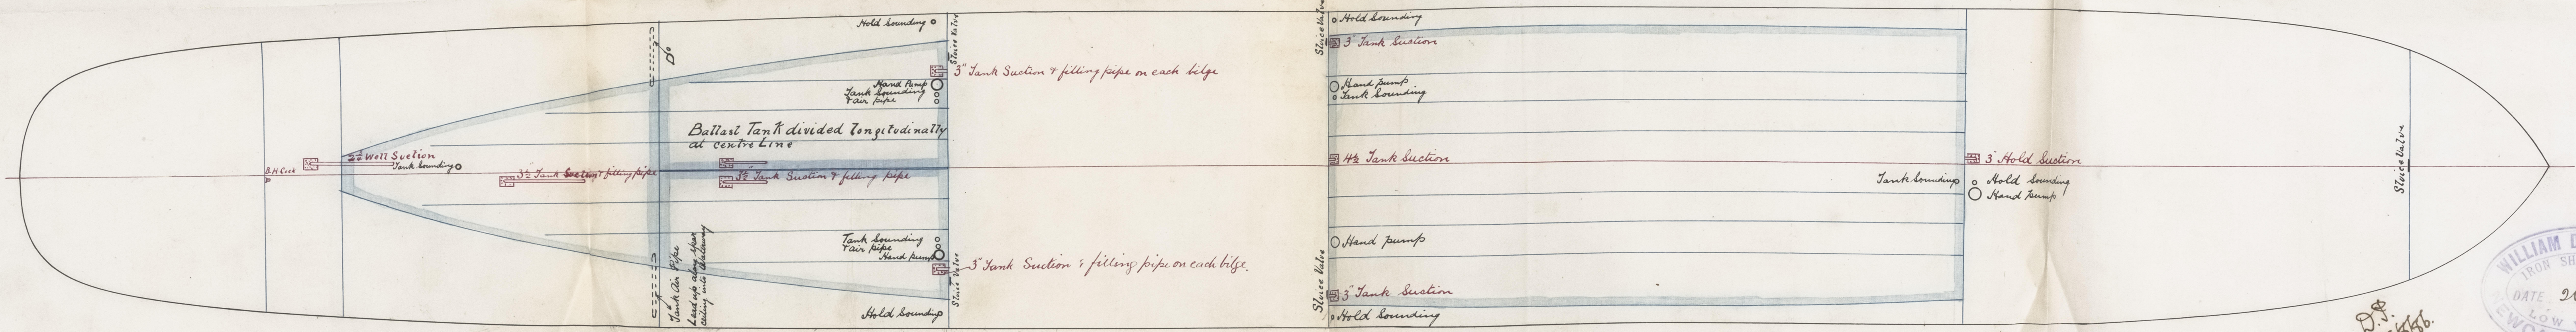


LOYD'S REGISTER OF SHIPPING  
RECEIVED  
28 AUG. 86  
LONDON

*Sew Steam "Aragay" Nwe Report No 19768*

PUMPING ARRANGEMENT  
S.S. No 9  
Scale 1/4" = 1 Foot

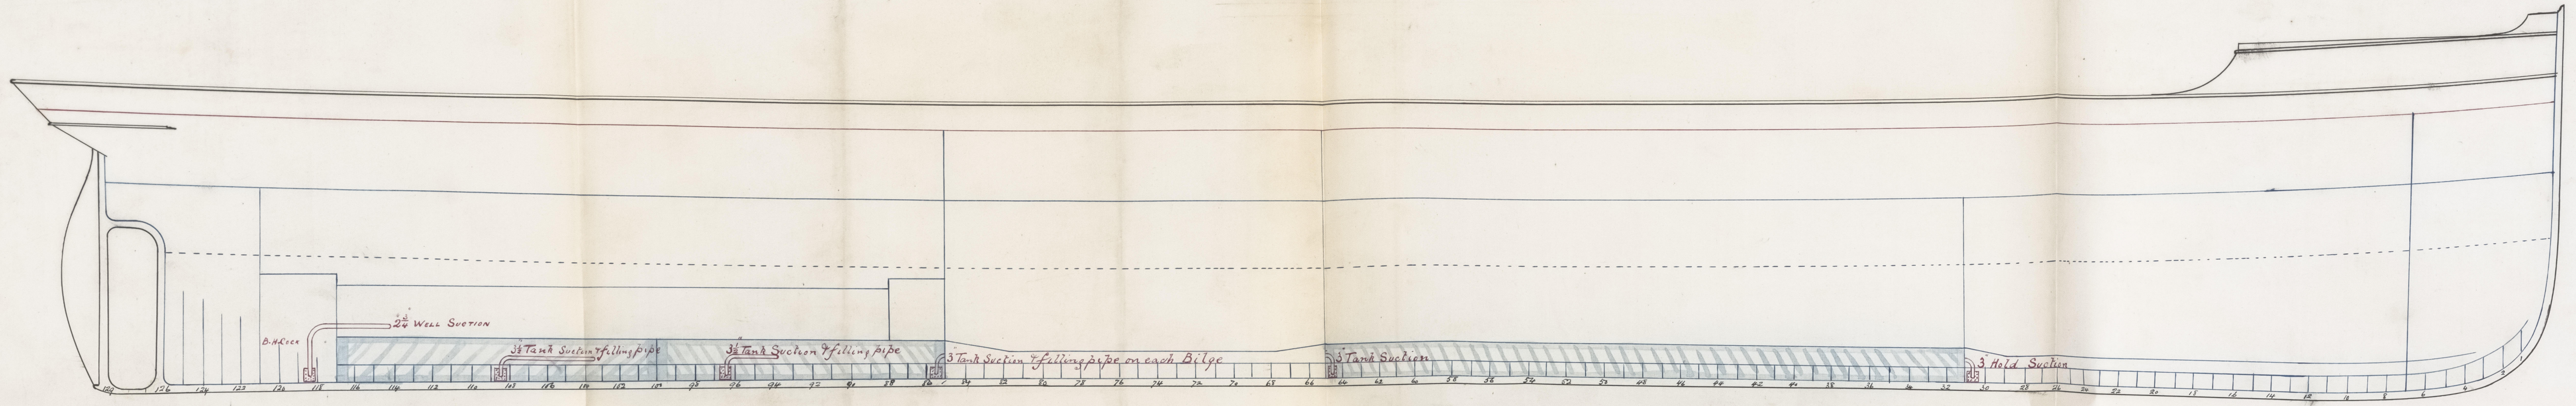

D.P.  
28/8/86

WILLIAM DOBSON & CO.  
IRON SHIPBUILDERS  
DATE 26/8/86  
LOW WALKER  
NEWCASTLE-ON-TYNE