

Lloyd's Register of British and Foreign Shipping.

(Report on Vessel No. 19468 Port Newcastle-on-Tyne)

No. 313.A

SHIP FORGINGS OR CASTINGS.

I have to report that the undermentioned Iron or ~~Steel~~ Forgings or Castings, manufactured by Messrs G H Reed & Co. of Sunderland, for the Vessel No. 9, being built by Messrs W Dobson & Co. of Low Walker have been inspected by me as set forth below, and found to be, so far as can be seen, sound.

Mark on Forgings.

Lloyd's

No. 313.A


G.H.

Hugh Cannon

Sunderland

	STERN FRAME.	RUDDER FRAME.	STEM.
Material* - - - -	<u>Scrap iron</u>	<u>Scrap iron</u>	<u>Scrap iron</u>
How made - - - -	<u>Forged</u>	<u>Forged</u>	<u>Forged</u>
Dimensions - - - -	<u>8' x 5'</u>	<u>5 3/4' - 3'</u>	<u>8' x 2 1/2' to 8' x 2'</u>
Progress on Inspection -	<u>Forged Smithed</u>	<u>Forged Smithed</u>	<u>Forged</u>
Dates when Inspected	<u>June 10-15-14-20-25</u> <u>July 16-21-24-30 Aug 6-11-18/85</u>	<u>Sept 2-5-7-15-18-28</u> <u>Oct 1-5-9-13-31/85</u>	<u>Sept 28/85</u>

SKETCHES OF FRAMES SHEWING POSITION AND DESCRIPTION OF WELDS OF FORGINGS, OR PARTICULARS OF TESTS APPLIED TO CASTINGS.

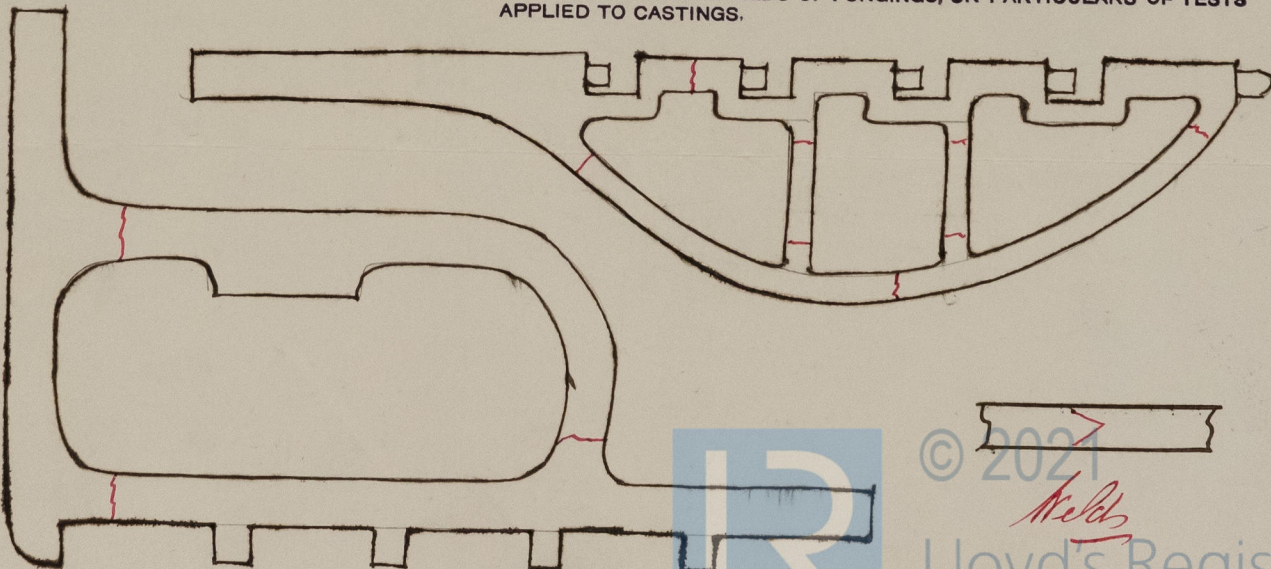

Wm Dobson & Co
No. 9. Sew. Str.

Sew Str "Hagay"
Vinc Report No 19768



© 2021

Lloyd's Register
Foundation