



S.S. New Amsterdam" Rec Report No. 20455



24.2.87.

Shade ~~Deck~~ Deck For this Length Supported on 24" Standions on each Side
 Shade Deck Stringer 8 ins by 4" thick
 Shade Deck Pl. Plate 6" " 4" thick

Sketch Showing Arrangement of Beams &c
 for Twin Screw Steamer No 107.
 Scale 1/4 Inch = 1 Foot.

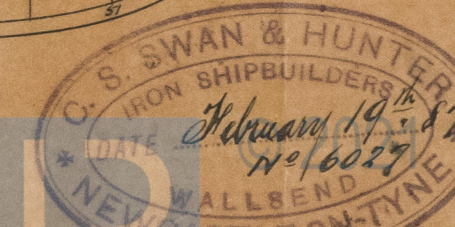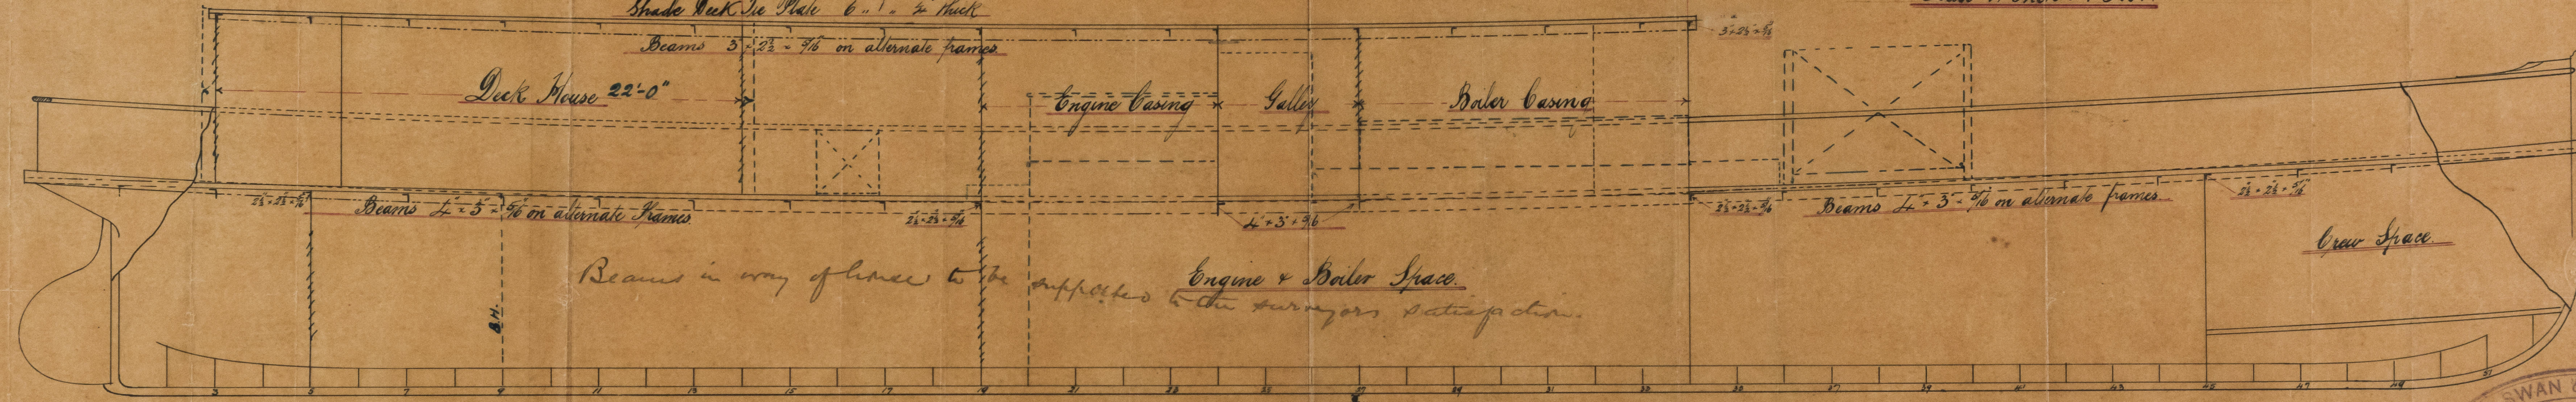

Lloyd's Register
 Foundation
 NWG-97-0202