

Midship Section of Yarn S.S. No. 107.

To be classed A for River purposes only. (Iron)

24.2.87.



Dimensions

Length to p.	100-0
Breadth to p.	14-0
Depth moulded	4-0

1/2" 8.5
1/2" 14.25
Depth 7.5
29.25 30.25 2 1/2" Tube.
99.25
2403. 3002

Anchor, Chains etc.

2 Bowers	3 1/2	cwt	ex	stock
1 Stream	1 3/4	"	"	"
90 lbs	13 1/16	slid chain	each	
30 "	9 1/16	stream chain		
4 Hawsers	4 1/2	fathoms	each	4 1/2 hump.
2 "	"	"	"	3 "

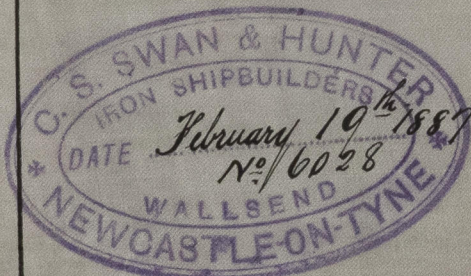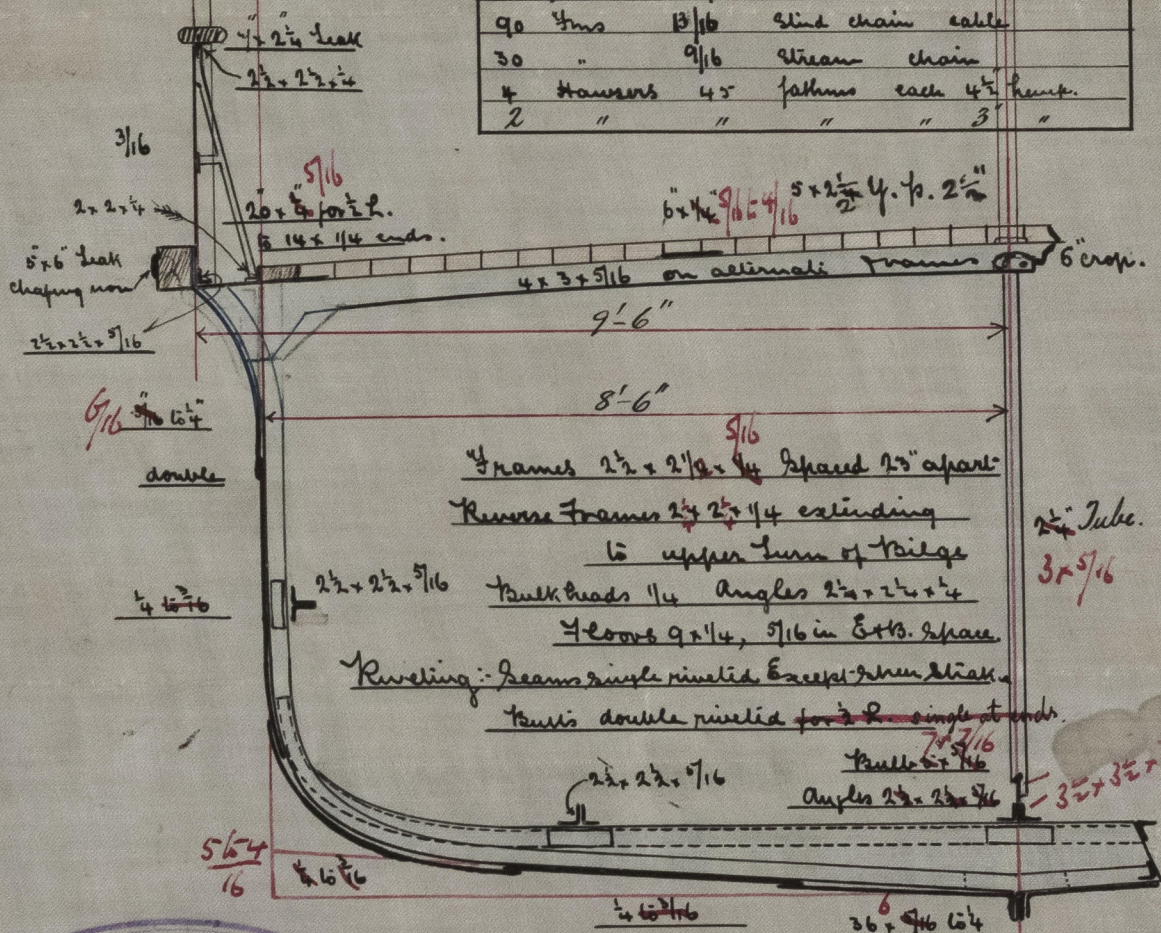

J.H.

22/2/87



Keel 5/16
Stem 5/16
Sliding keel 5/16
Rudder head 5/16

Lloyd's Register Foundation

NWC797-0204