

Lloyd's Register of British and Foreign Shipping.

(Report on Vessel No. 20533 Port Newcastle)

No. 580A SHIP FORGINGS OR CASTINGS.

I have to report that the undermentioned Iron or Steel Forgings or Castings, manufactured by

Messrs Palmers S B Co. of Jarrow
for the Vessel No. 582, being built by Messrs Palmers S B Co.
of Jarrow have been inspected by me as set forth below, and found
to be, so far as can be seen, sound.

Mark on Forgings.

Lloyd's

No. 580A

S B Co.


Hugh Cameron

Sunderland-

1/6/87

	STERN FRAME.	RUDDER FRAME.	STEM.
Material* - - - -	Scrap iron	Scrap iron	Scrap iron
How made - - - -	Forged	Forged	Forged
Dimensions - - - -	4' x 4 3/4'	5' - 3'	4' x 2 3/8'
Progress on Inspection -	Forged & mitted	Forged & mitted	Forged
Dates when Inspected	Feb 16-21 March 4-21/87	March 21-29 April 6 May 4 16-19/87	

SKETCHES OF FRAMES SHEWING POSITION AND DESCRIPTION OF WELDS OF FORGINGS, OR PARTICULARS OF TESTS APPLIED TO CASTINGS.

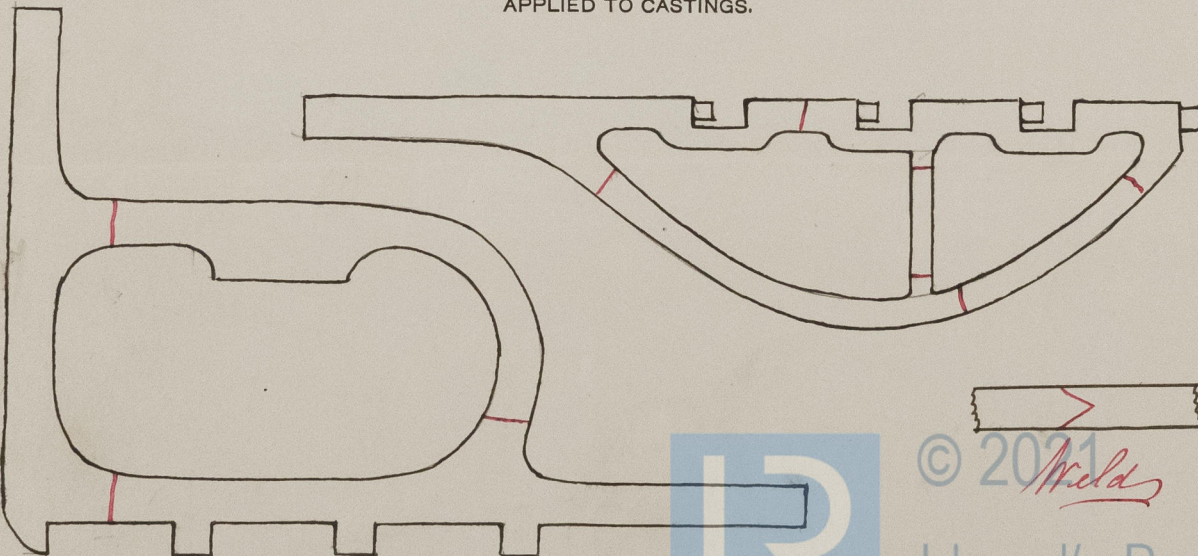

© 2021
Melds

Lloyd's Register
Foundation