
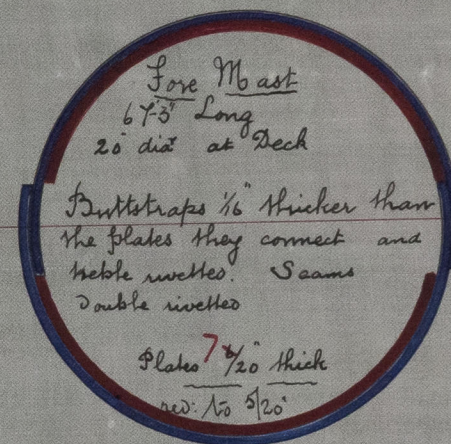


Steel Masts SS No 582

3.5.87.

Fore Mast.



Doubling 5'-0"

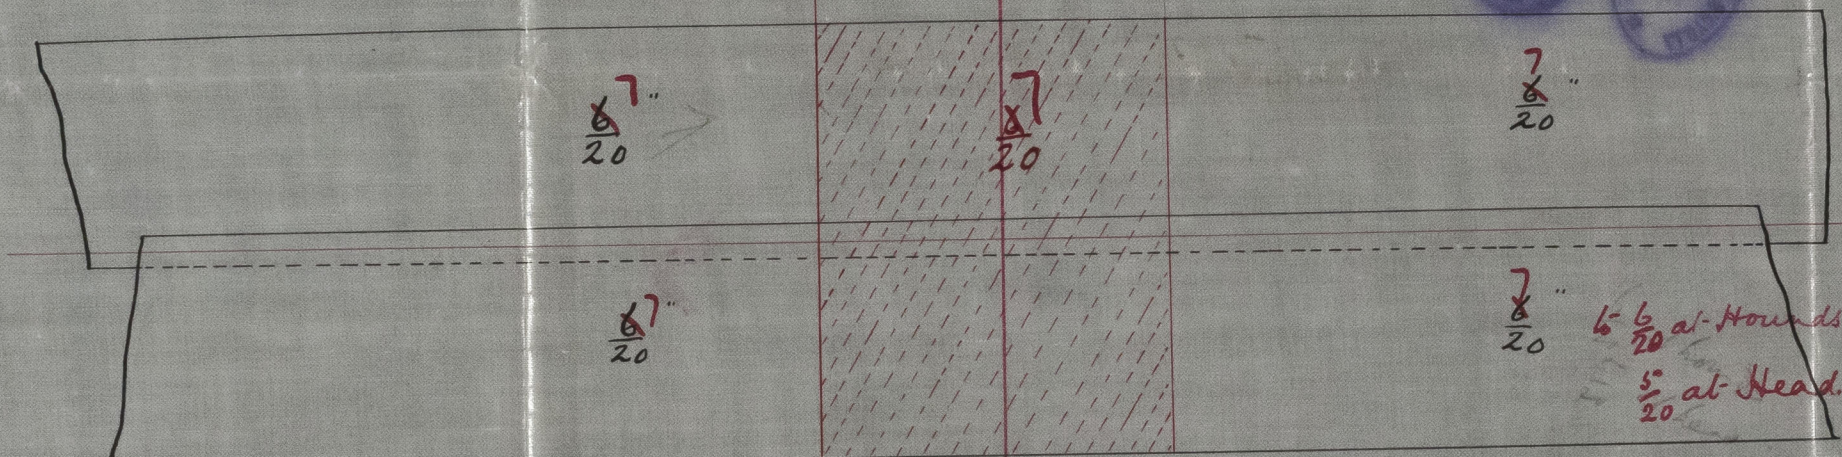

Plates $\frac{7}{20}$ thick at Partners
 $\frac{6}{20}$ " " Hounds
 $\frac{5}{20}$ " " Head


Main Mast

Doubling 5'-0"

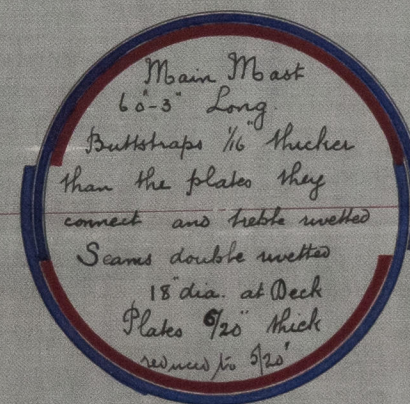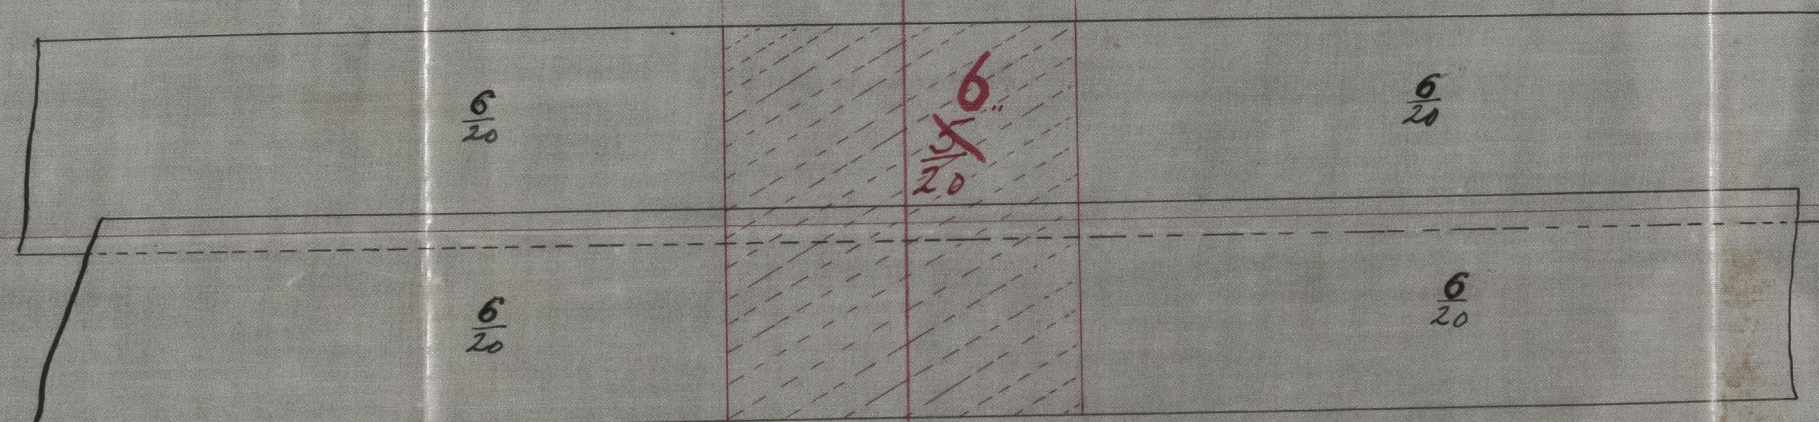

See letter 3/5/87 TB

Deck


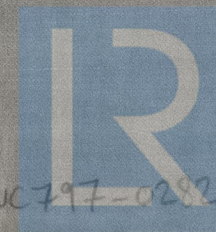


24/4/87

Lloyd's Register Foundation




1/2 1/2

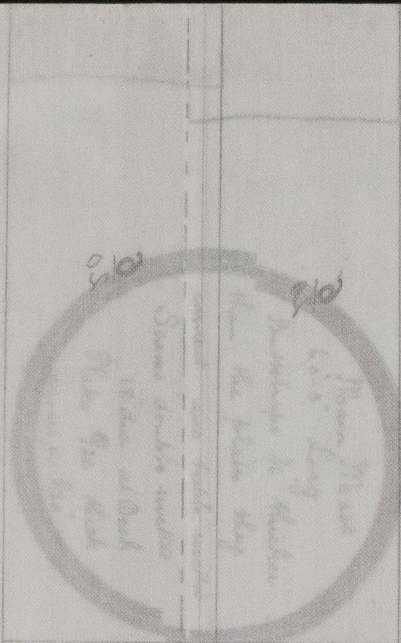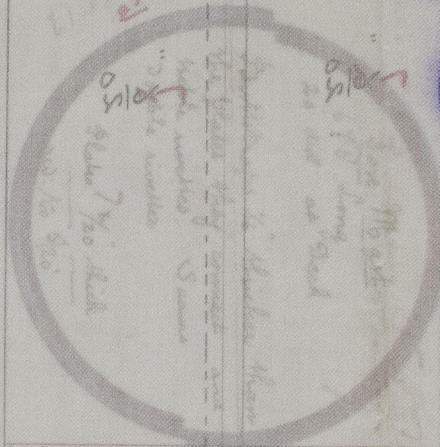

282 N 22

© 2021

Lloyd's Register Foundation

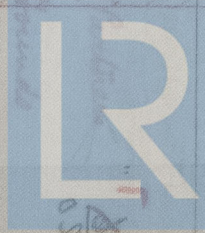

NWC 797-0282









