


S. S. FIRESHIRE

Expansion of shell plating

Port side

Longitudinal Scale $\frac{1}{8}" = 1 \text{ foot}$
Transverse Scale $\frac{1}{4}" = 1 \text{ foot}$

Note! The plates to be taken out are crossed

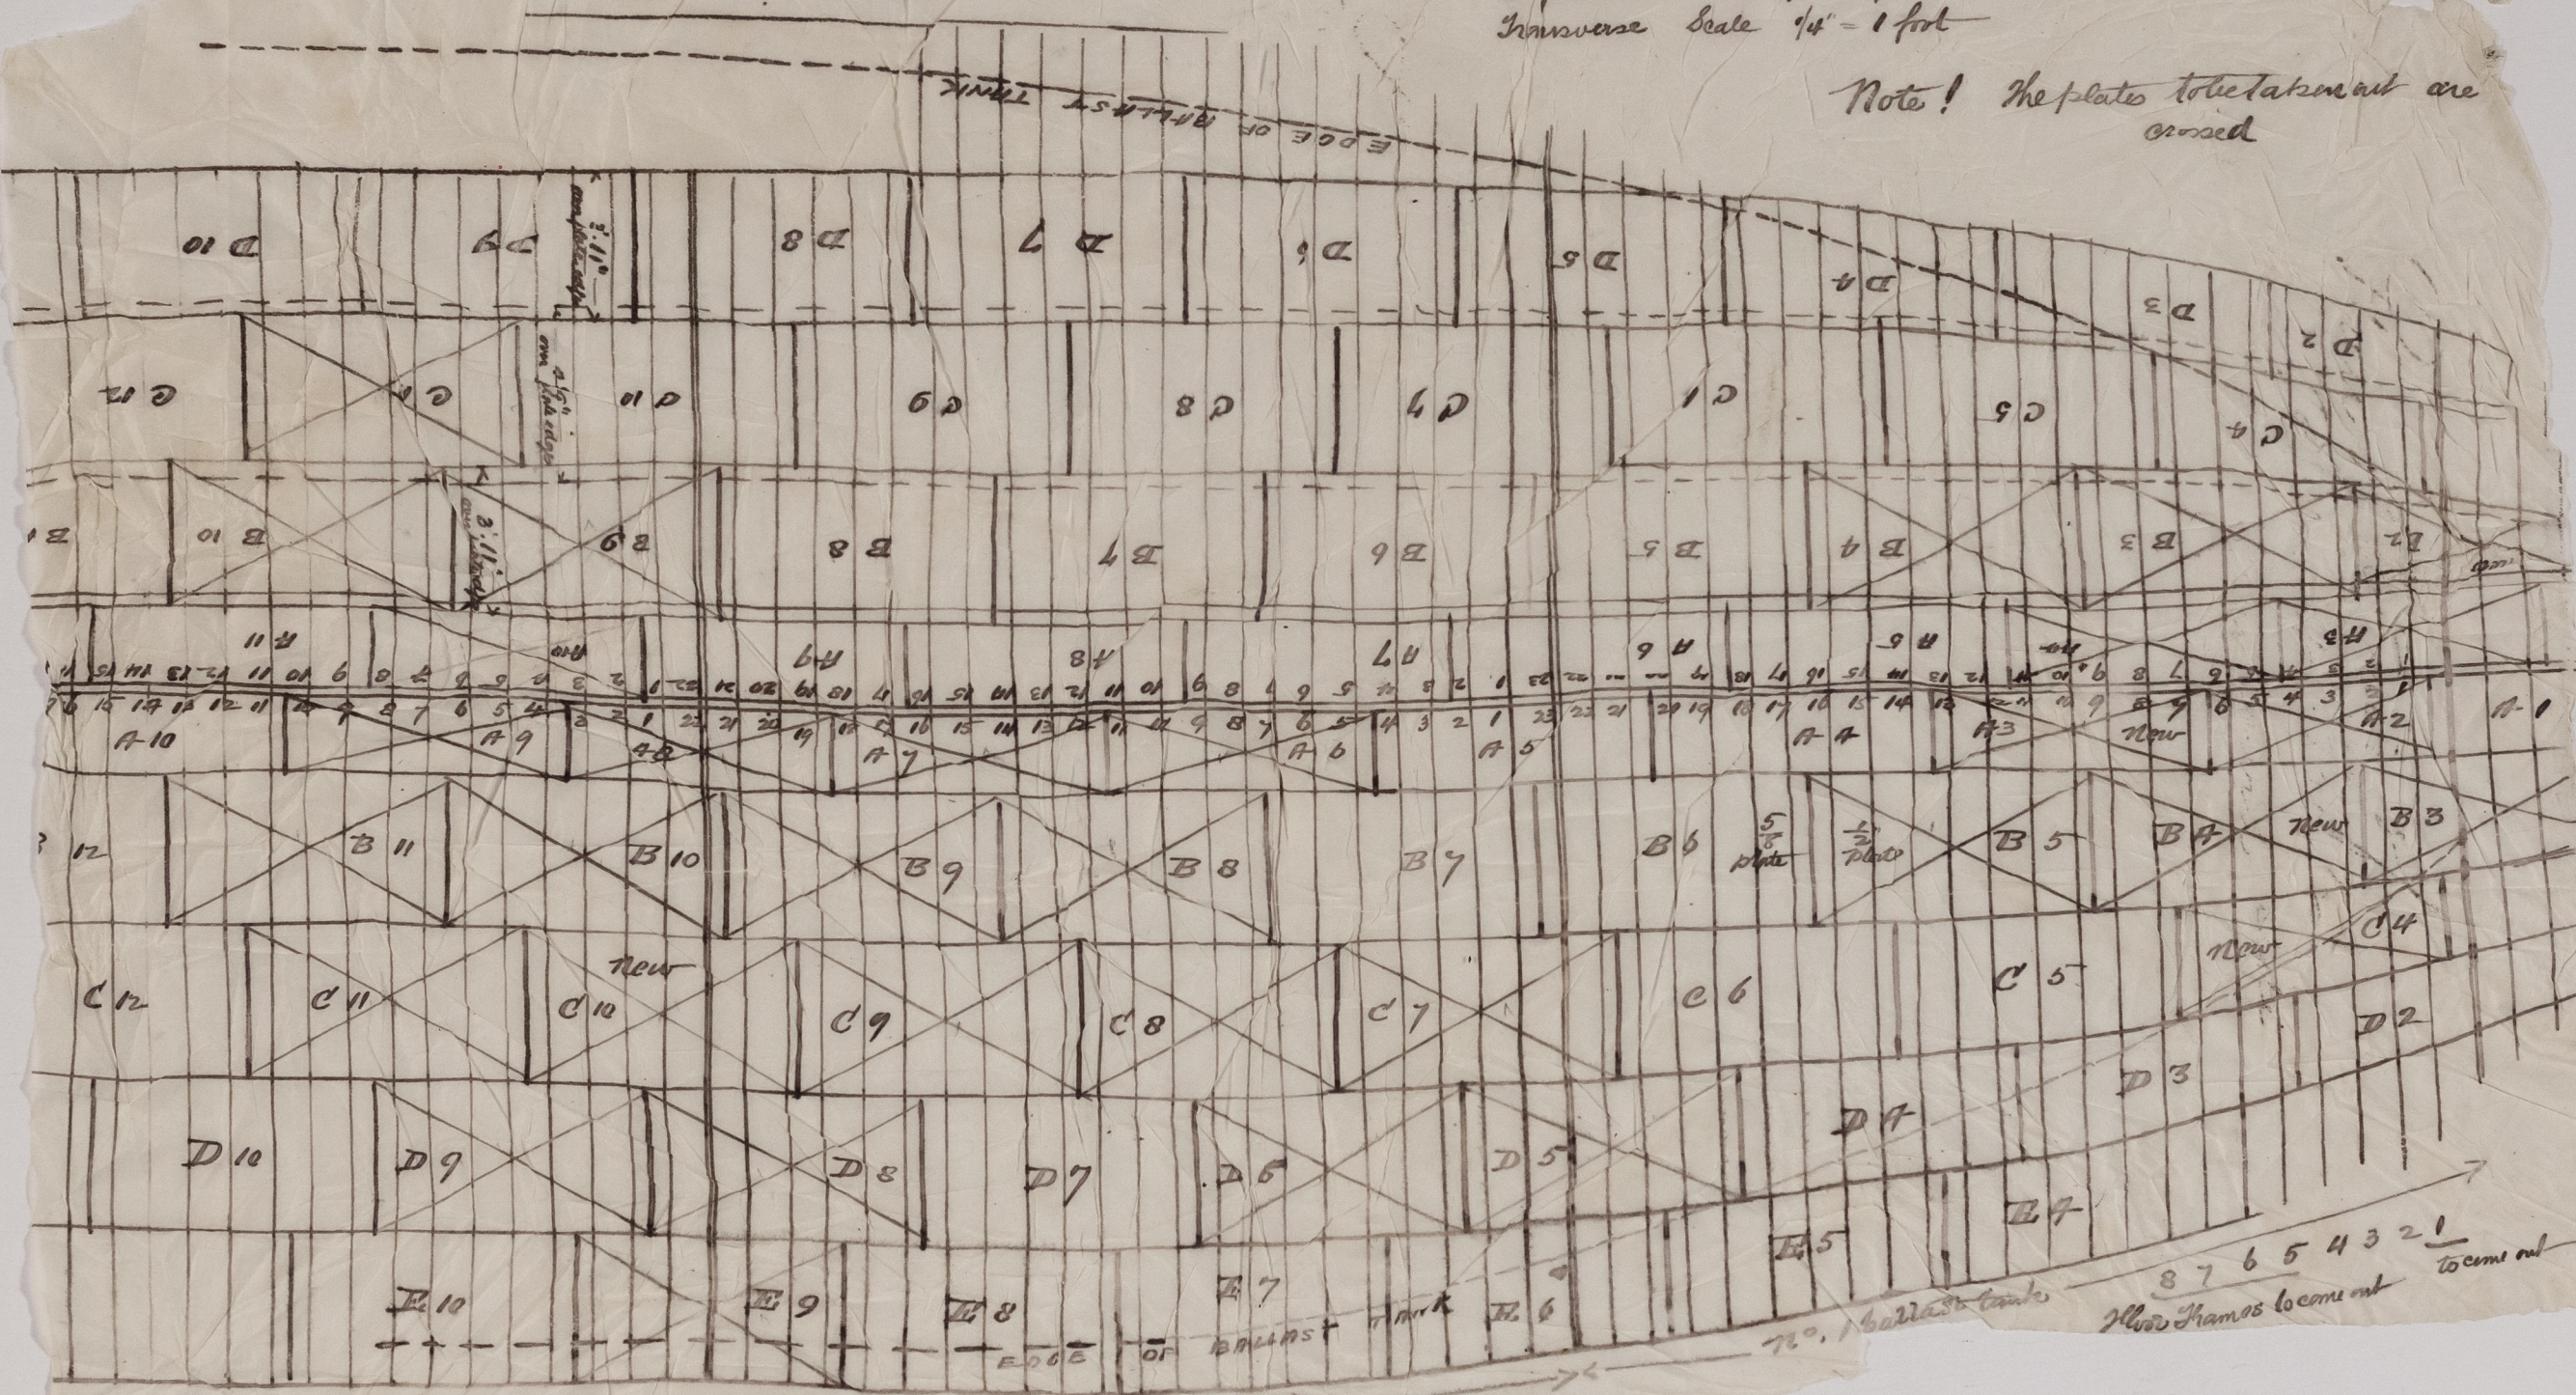

7 6 5 4 3

No. 2 Ballast tank
Starboard side

No. 3
Floor frames to come out
Ballast tank