

246187

Received at

Office,

*Recd.*

# Lloyd's Register of British and Foreign Shipping.

(Report on Vessel No. 20711 Port Newcastle)

## No. 568 a SHIP FORGINGS OR CASTINGS.

I have to report that the undermentioned Iron or Steel Forgings or Castings, manufactured by

Messrs R. & Hawthorn Leslie & Co. of Newcastle

for the Vessel No. 105, being built by Messrs C. J. Swan Hunter

of Newcastle have been inspected by me as set forth below, and found to be, so far as can be seen, sound.

The words FORGINGS or CASTINGS, IRON or STEEL, should be struck out as may be required.

Mark on Forgings.

Lloyd's  
No. 568 a  
Ob. C.



Hugh Cameron

Sunderland

1/6/87

	STERN FRAME.	RUDDER FRAME.	STEM.
Material*	<u>Scrap iron</u>	<u>Scrap iron</u>	<u>Scrap iron</u>
How made	<u>Forged</u>	<u>Forged</u>	<u>Forged</u>
Dimensions	<u>11 x 6 1/2</u>	<u>8 1/2</u>	<u>11 x 2 3/4</u>
Progress on Inspection	<u>Forged Smithed</u>	<u>Forged Smithed</u>	<u>Forged</u>
Dates when Inspected	<u>July 1-3-8-16-25 March 1-7 16-21/87</u>	<u>March 24-29 April 5-19-26 May 5/87</u>	<u>July 25/87</u>

SKETCHES OF FRAMES SHEWING POSITION AND DESCRIPTION OF WELDS OF FORGINGS, OR PARTICULARS OF TESTS APPLIED TO CASTINGS.

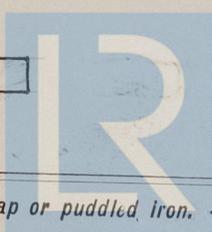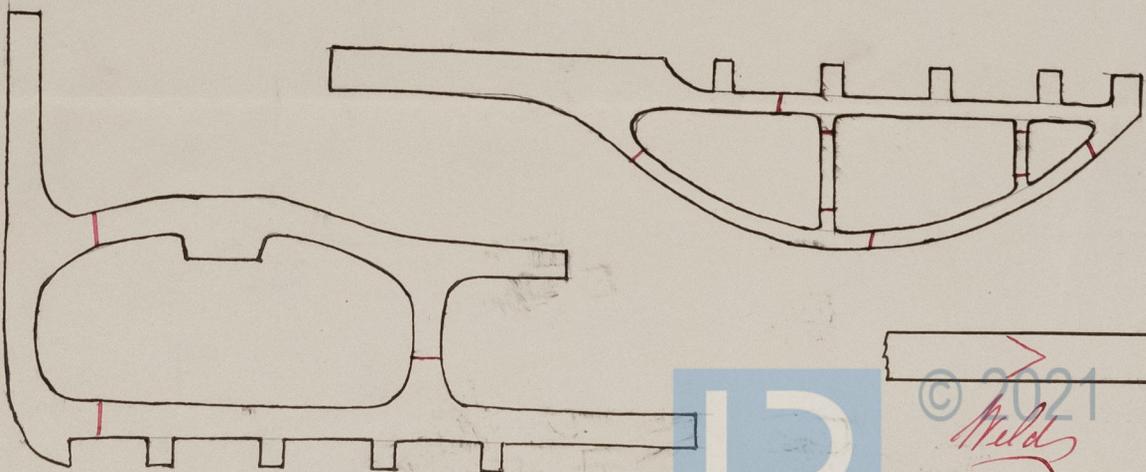

© 2021

*Welds*

Lloyd's Register  
Foundation

\* If of Iron, state whether scrap or puddled iron.

568

NWCF98-0112

Swan & Hunters  
No. 105

*[Faint handwritten text, likely bleed-through from the reverse side of the page]*



© 2021  
Lloyd's Register  
Foundation