

The words FORGINGS or CASTINGS, IRON or STEEL, should be struck out as may be required.

Received at

Office,

# Lloyd's Register of British and Foreign Shipping.

(Report on Vessel No. 21215 Port *Newcastle*)

No. 668a

## SHIP FORGINGS OR CASTINGS.

I have to report that the undermentioned Iron or ~~Steel~~ Forgings or Castings, manufactured by *Imp. Glasgow Forge Co.* of *Glasgow* for the Vessel No. 38, being built by *Imp. W. S. Edwards Sons* of *South Shields* have been inspected by me as set forth below, and found to be, so far as can be seen, *sound*.

Mark on Forgings.

Lloyd's


No. 668a  
S.C.

*Hugh Cameron*

*South Shields*  
22/10/84

	STERN FRAME.	RUDDER FRAME.	STEM.
Material* - - - -	<i>Scrap iron</i>	<i>Scrap iron</i>	<i>Scrap iron</i>
How made - - - -	<i>Forged</i>	<i>Forged</i>	<i>Forged</i>
Dimensions - - - -	<i>8 1/2 x 5</i>	<i>6 1/4 - 3 1/4</i>	<i>8 1/2 x 2 1/2</i>
Progress on Inspection -	<i>Forged Limited</i>	<i>Forged Limited</i>	<i>Forged</i>
Dates when Inspected	<i>Aug 15-19-22-25-30</i> <i>Sep 5-8-14/84</i>	<i>Sep 8-14-16-19-24-30</i> <i>Oct 10-18-21/84</i>	<i>Sep 8/84</i>

SKETCHES OF FRAMES SHEWING POSITION AND DESCRIPTION OF WELDS OF FORGINGS, OR PARTICULARS OF TESTS APPLIED TO CASTINGS.

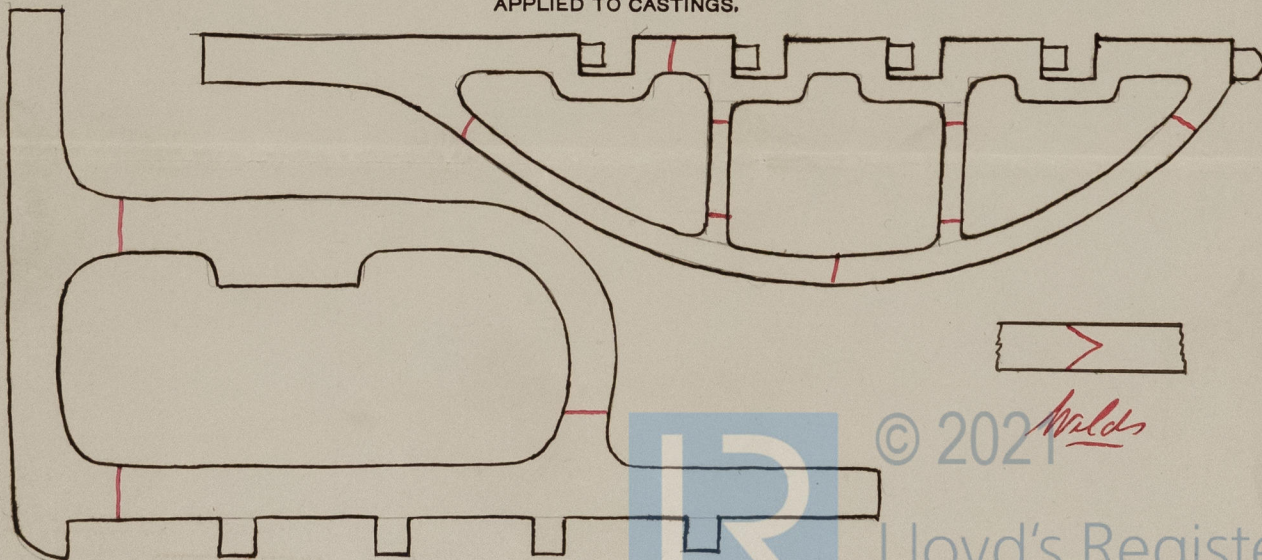



N. P. Edwards & Sons  
No 38.

SHIP FORGINGS OR CASTINGS.



© 2021

Lloyd's Register  
Foundation