


13.2.81

Class A for ship purposes
Iron Plate No. 138
of
Mishkin Section

Length between perpendiculars 108'0"
18'0"
10'0"

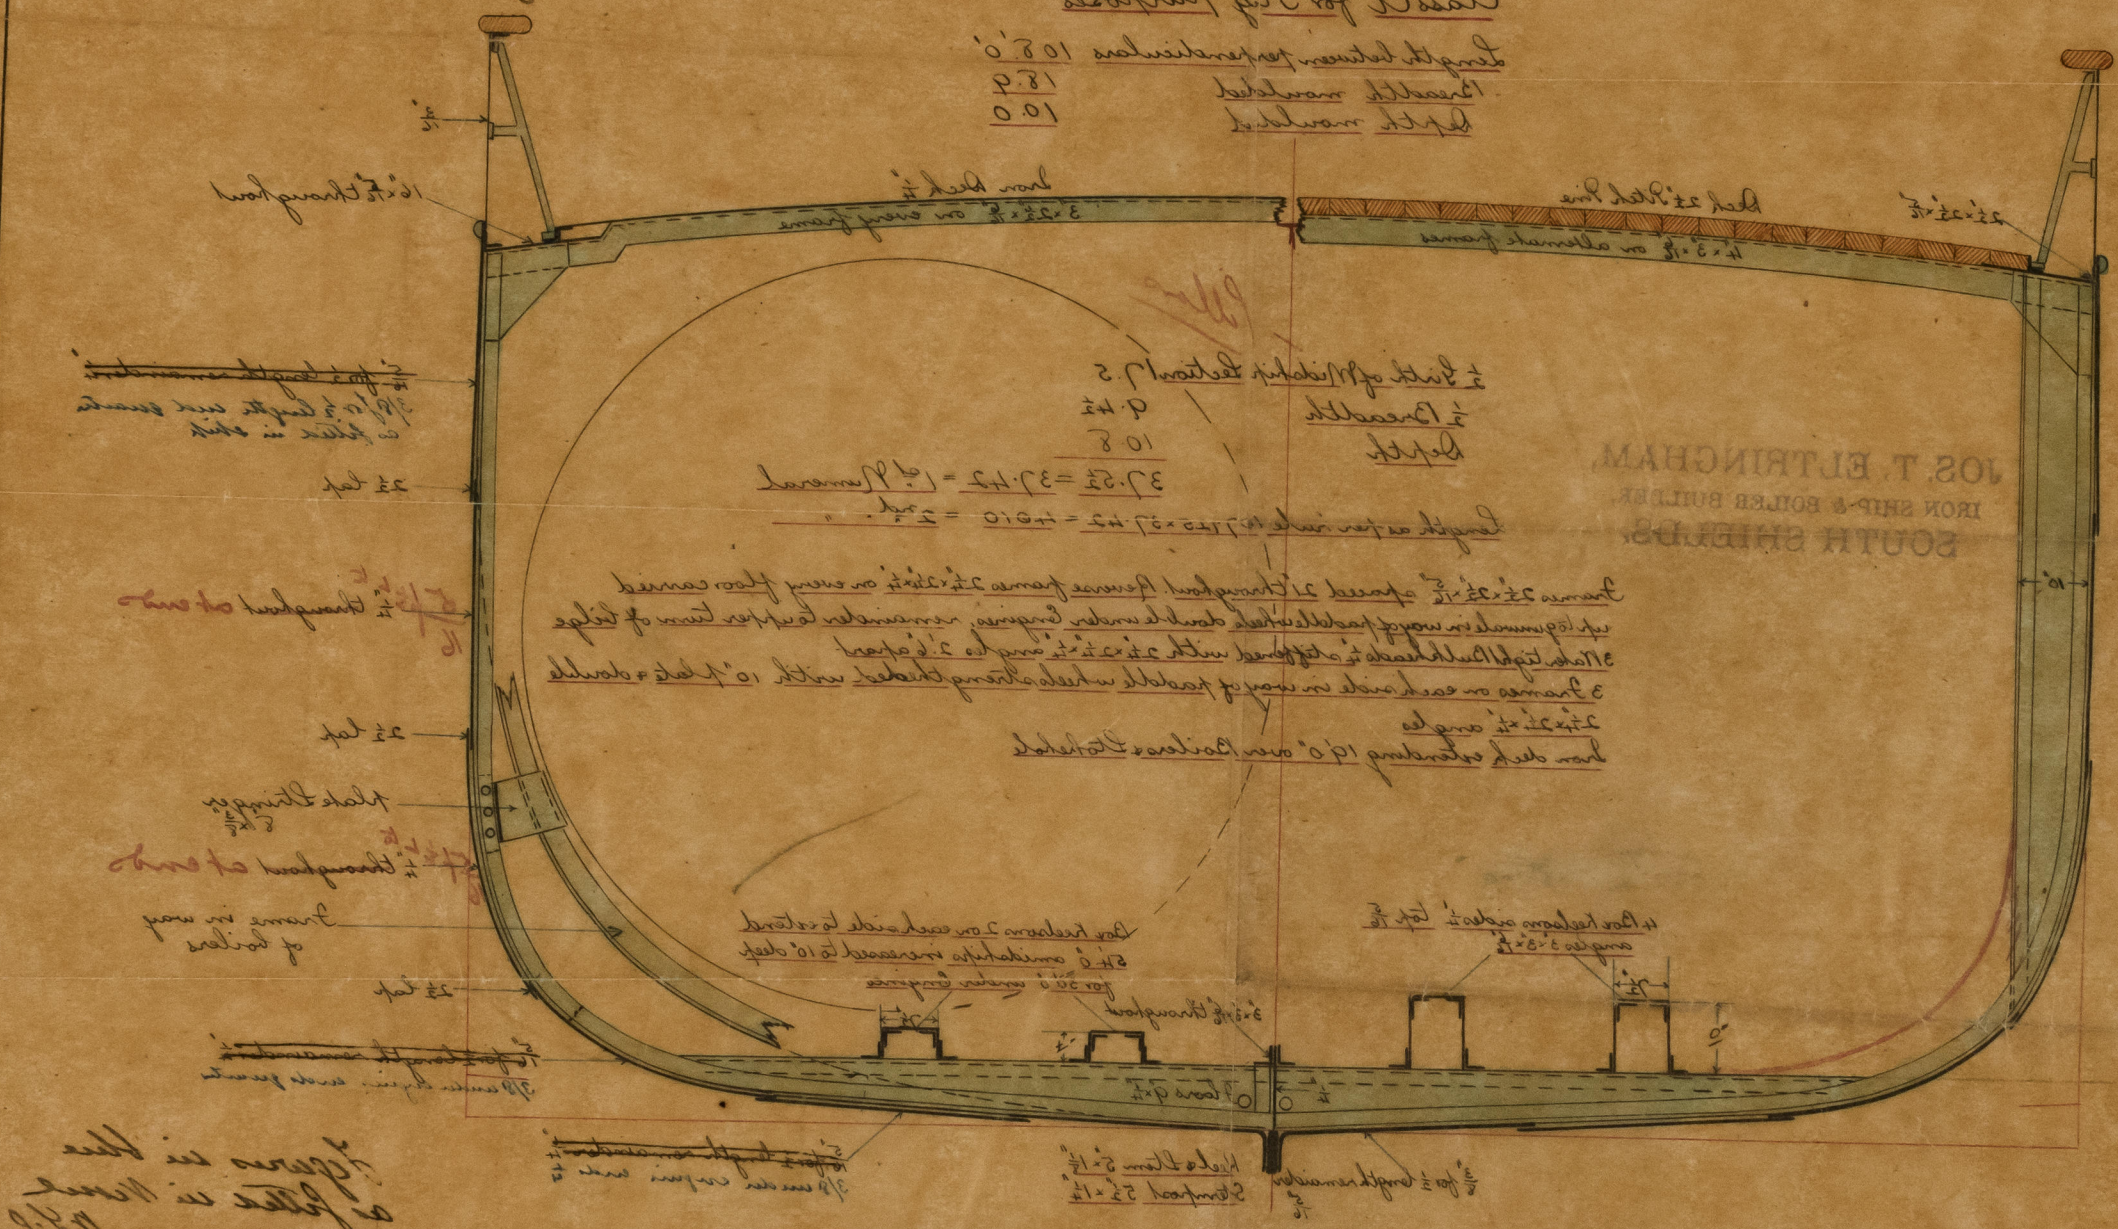

102 T. ELTRINGHAM
IRON SHIP & BOILER BUILDERS
SOUTH SHIELDS

5010-0083105

Figures in the
of plates in
10/2/81

14/2/81



© 2021
Lloyd's Register
Foundation

NWC800-0102

