



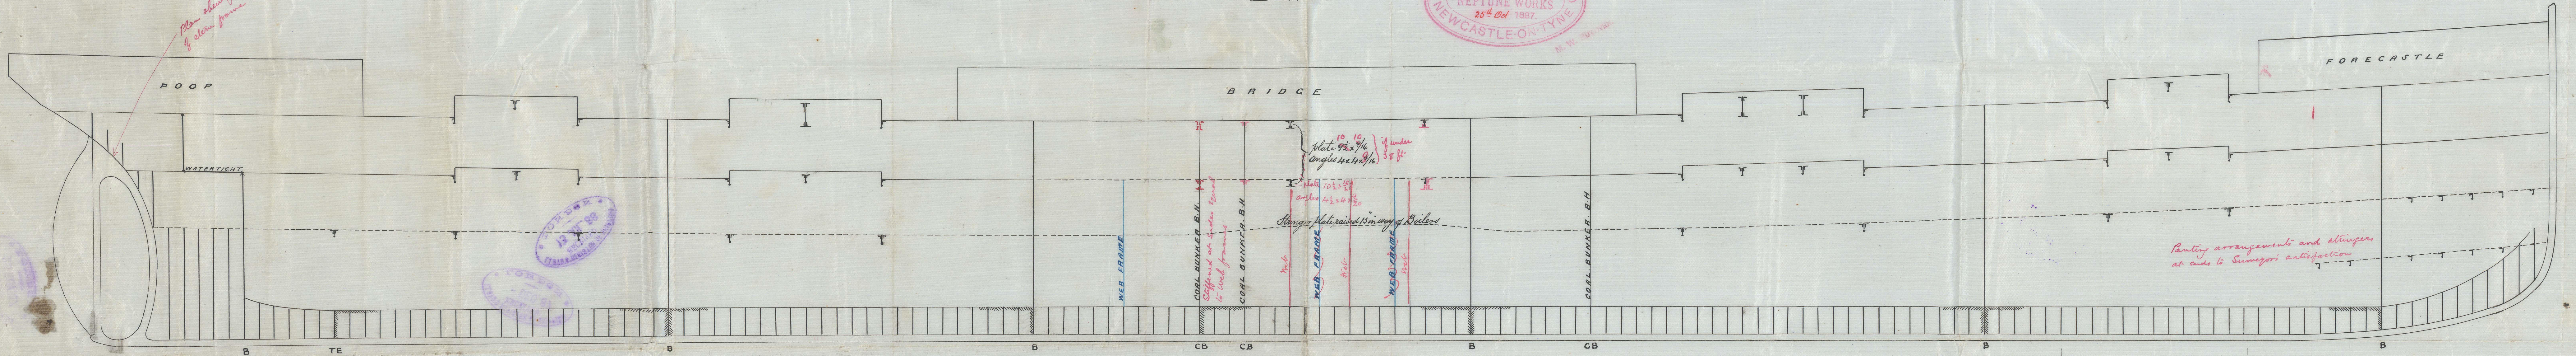

Plan showing connections
of steam frame to be submitted

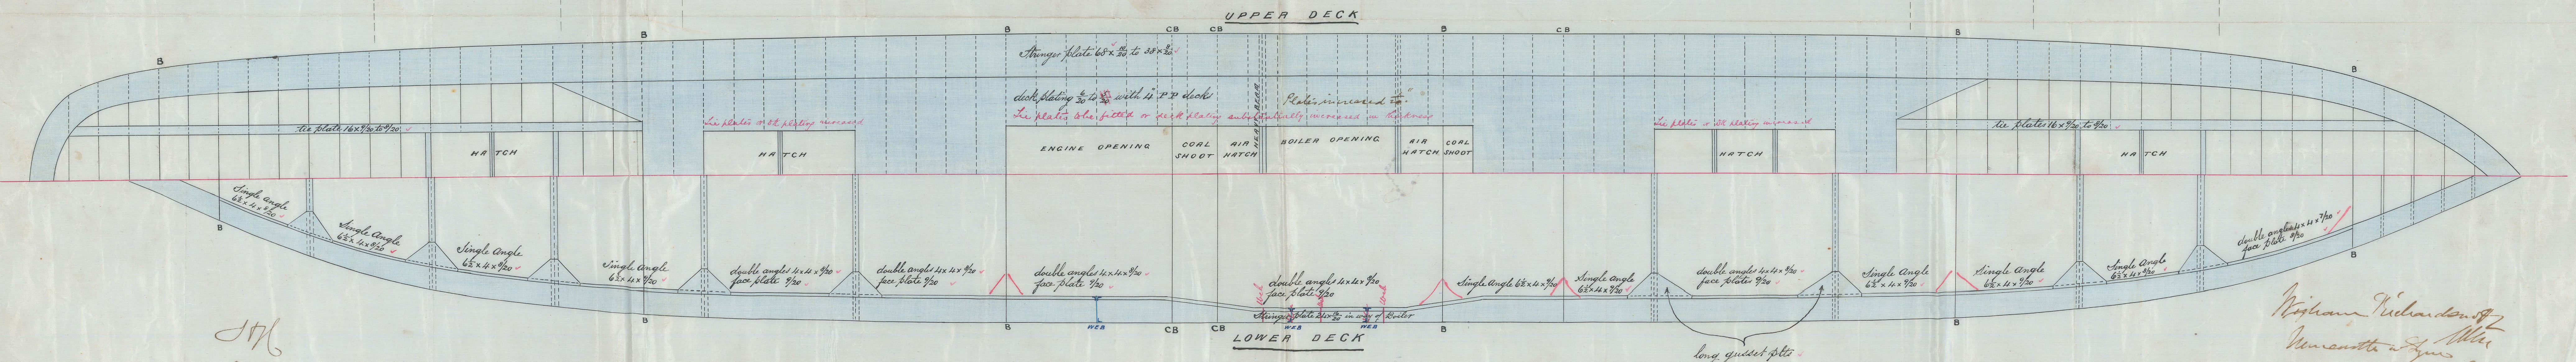

$\leftarrow \frac{1}{2}$ length

 $\frac{3}{4}$ length \rightarrow 

25. Octo 87 -

28/10/84

with lock
Sheet No. 205/3




221

Similar to 218


ELEVATION

SCALE 1/8"


Steel

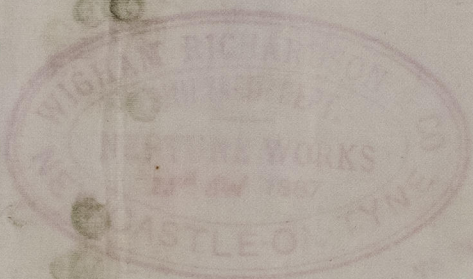

5.15.84
3.11.84

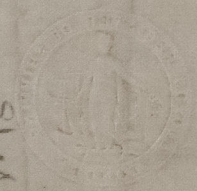



See drawing of structure
of steel frame
with concrete

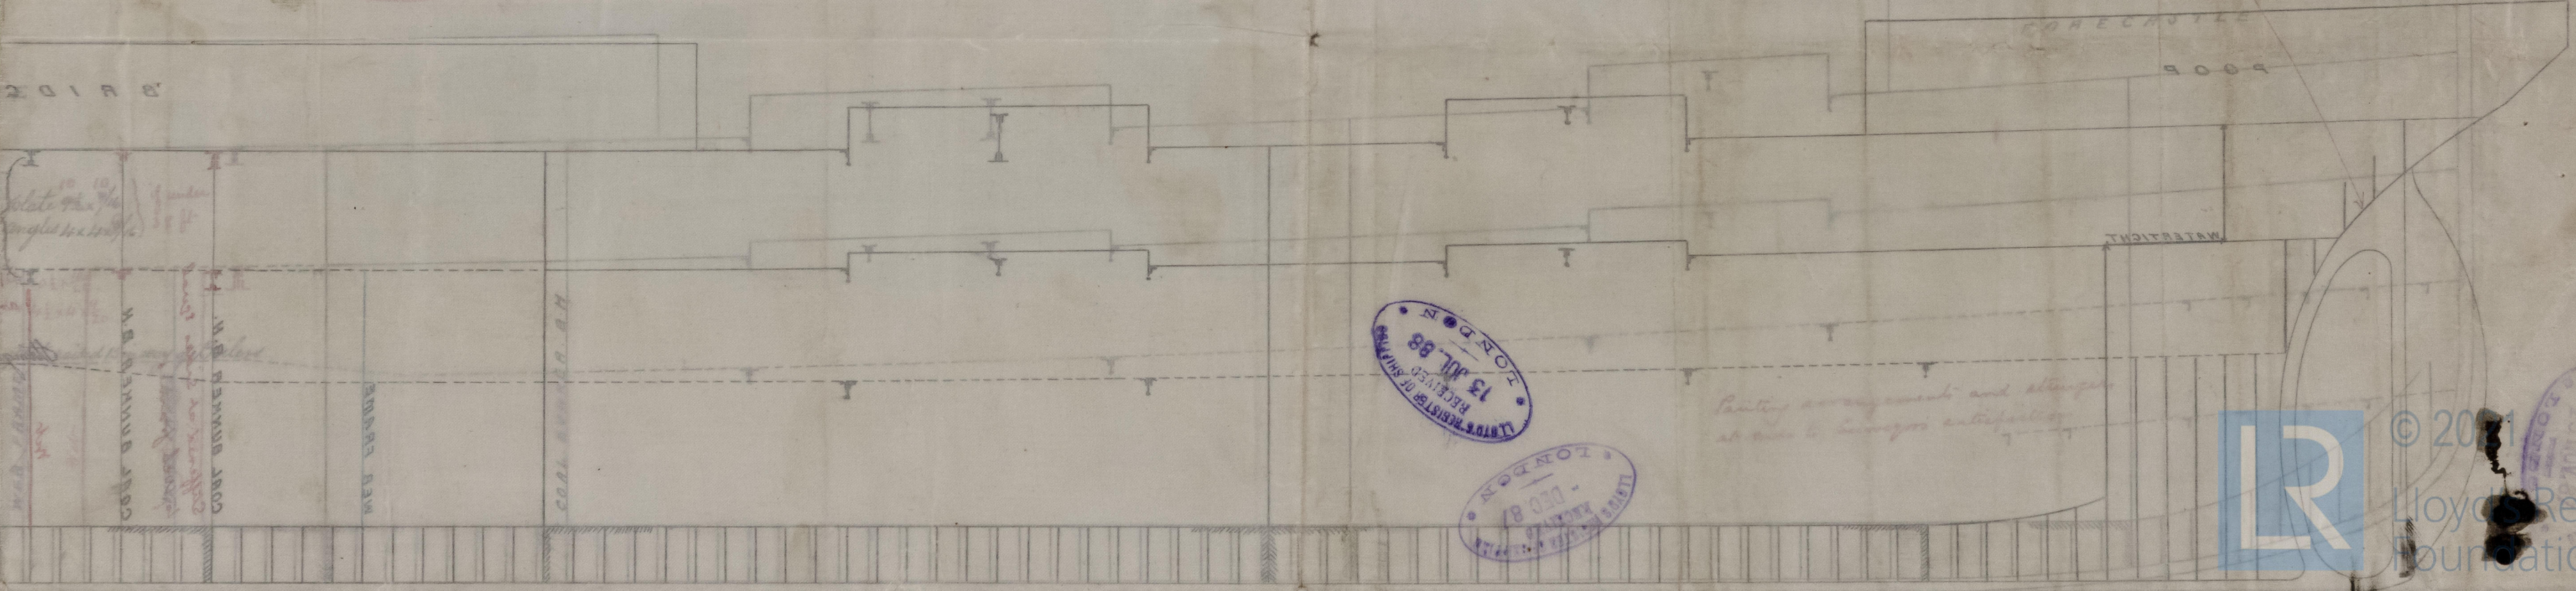

20188

Plate 10 1/4
Angle 1 1/2 x 1 1/2


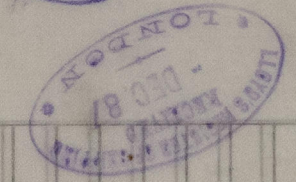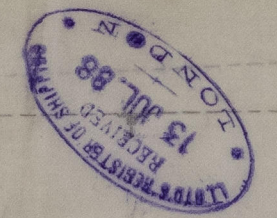

Painting arrangements and alterations



© 2011
 Lloyd's Register
 Foundation



8610-1087MN