

3. 11. 87.
2. 12. 87.

Class. 100. A 1 at Lloyd's 3 decker


STEEL

$$\frac{7}{86.61 \times 323 = 27975}$$

Equipment № 32125 ✓

depths to length 10.9 to UD ✓
 " " " " 14.9 " MD ✓
 Breadths " " 8.1 ✓

Forecastle Beam bulbs 7 x 7 1/6 ✓
 —" —" Angles 3 x 3 x 6 1/6 ✓
 —" Stringer plates 32 x 7 1/6 ✓
 —" —" Angles 3 x 3 x 6 1/6 ✓

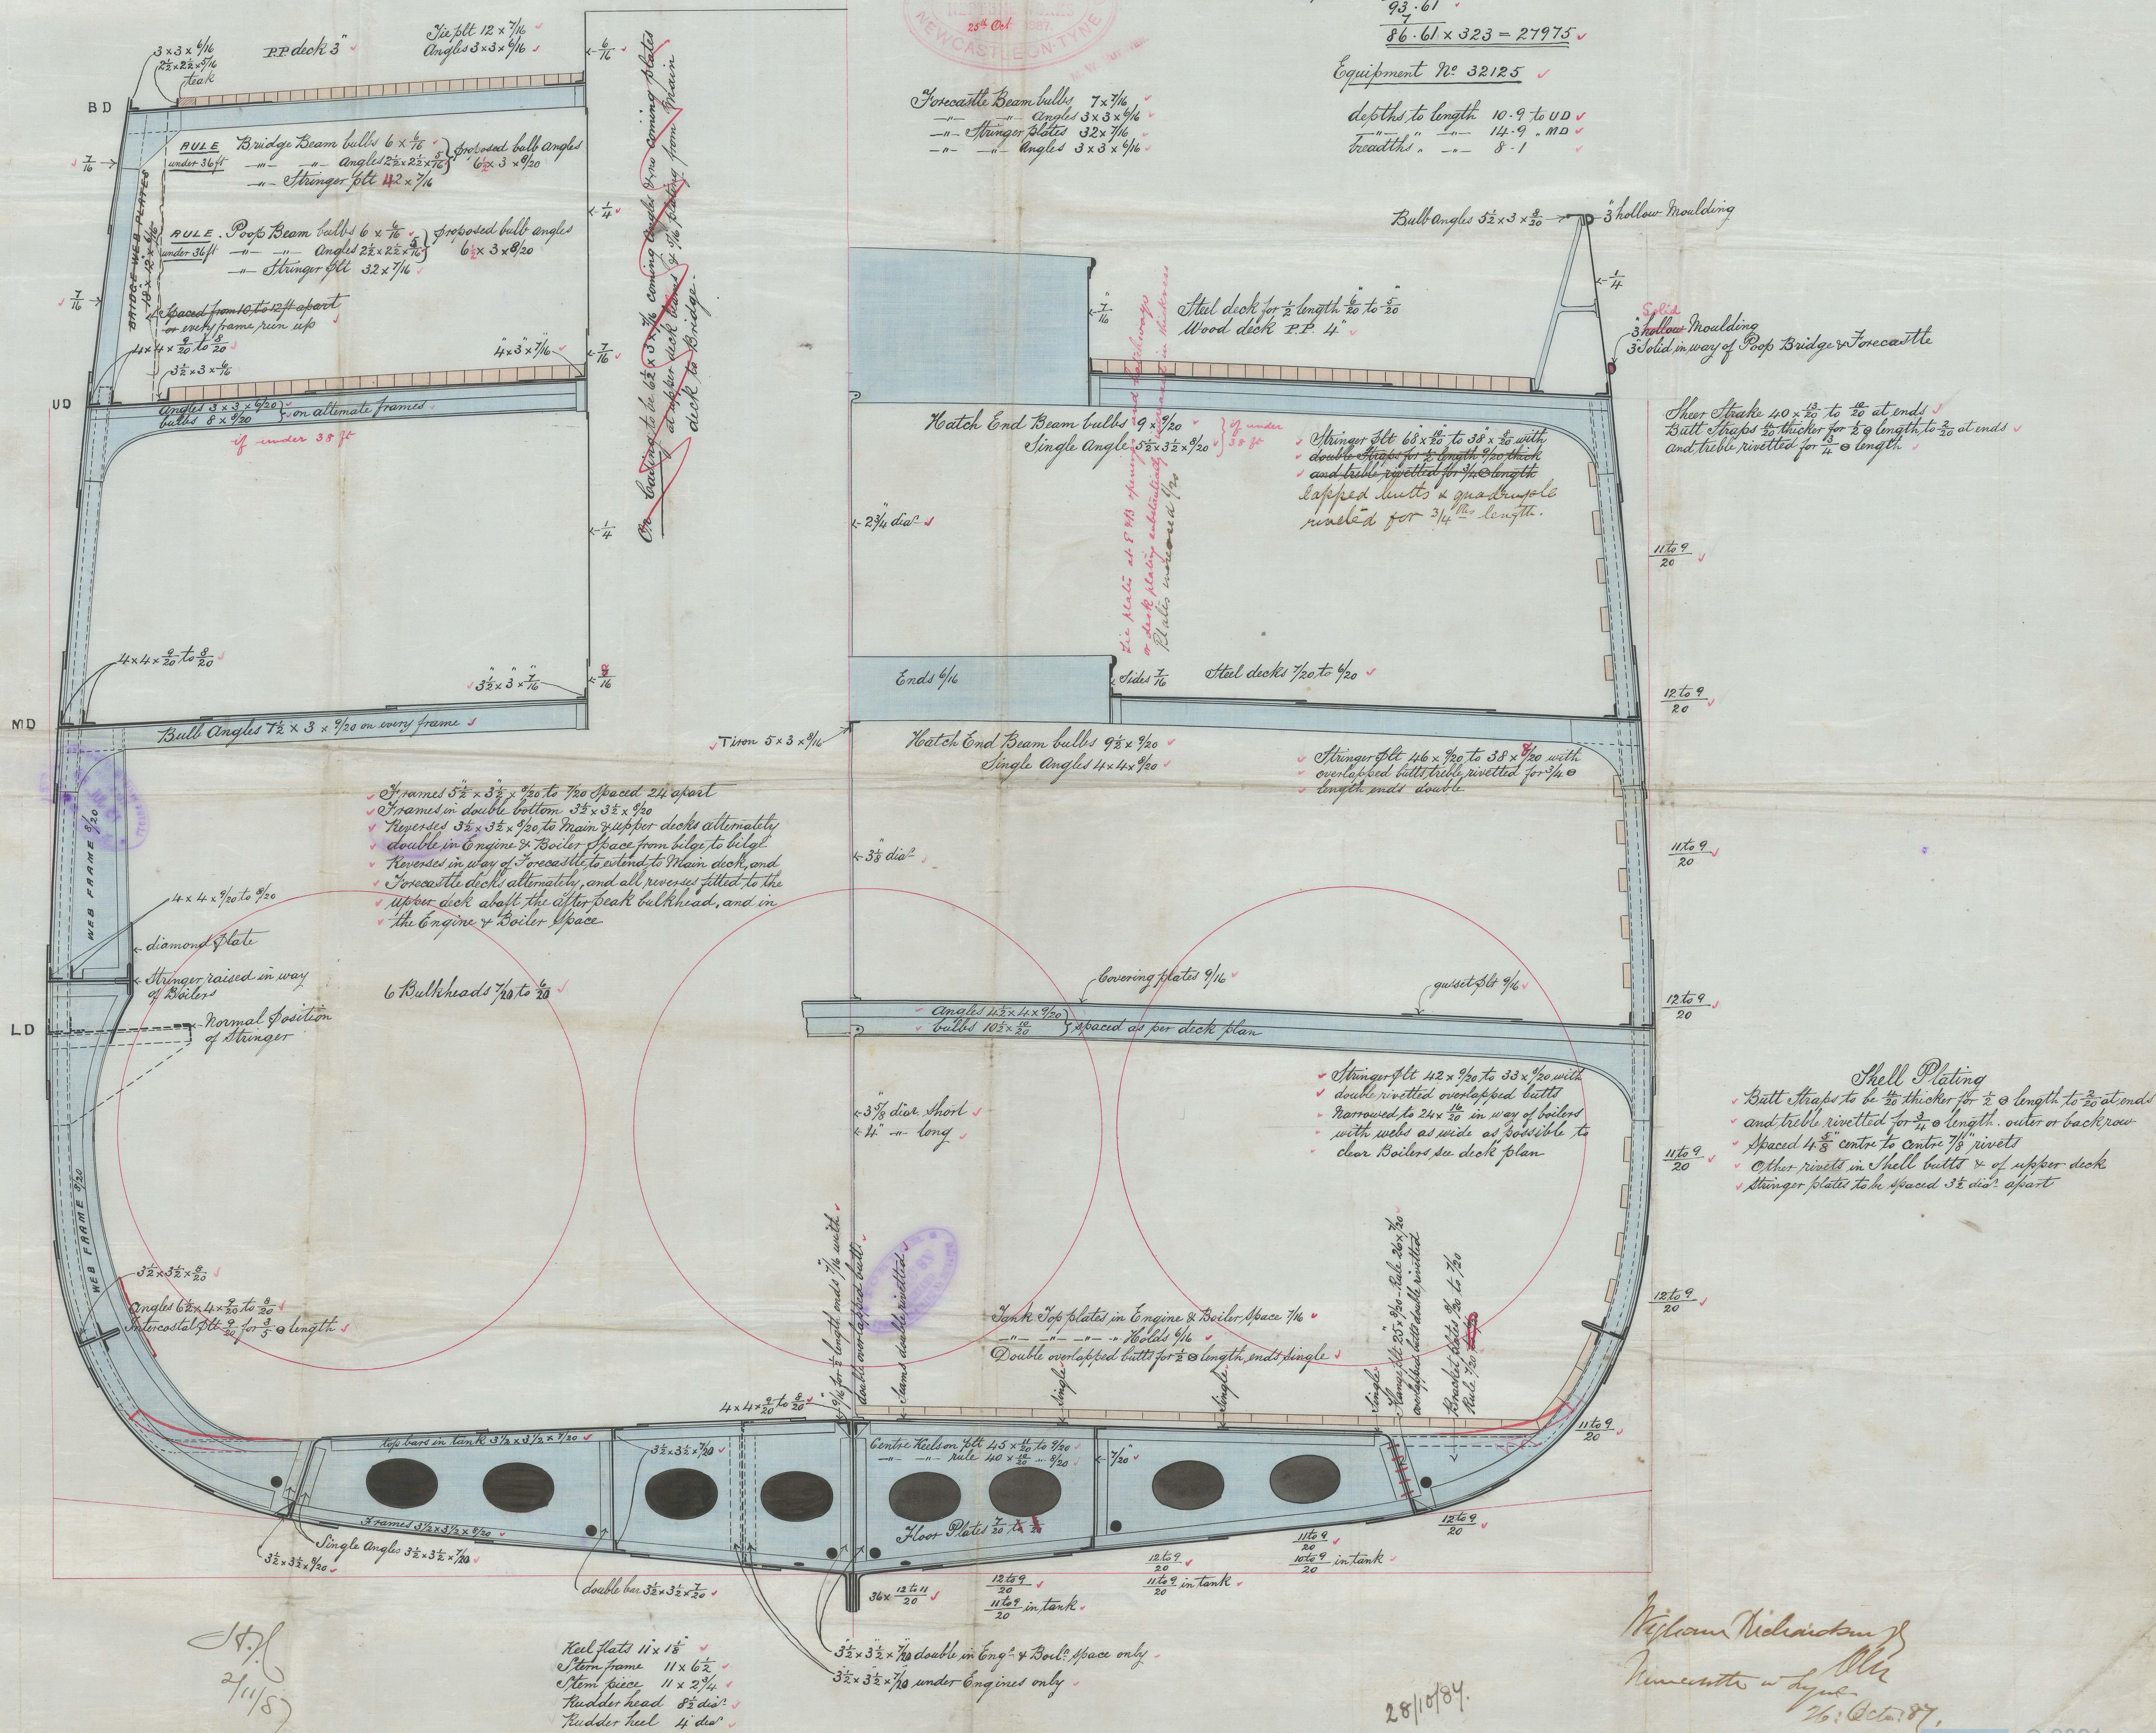

William Richardson of
Newcastle a Lyceum
26. Oct. 18

28/10/84

