


22.12.87
2.2.88


SS N° 102 "Avalon" hve 21742
Sketch showing proposed
strengthening of deck in way of long hatches
Scale 8 inch to one foot

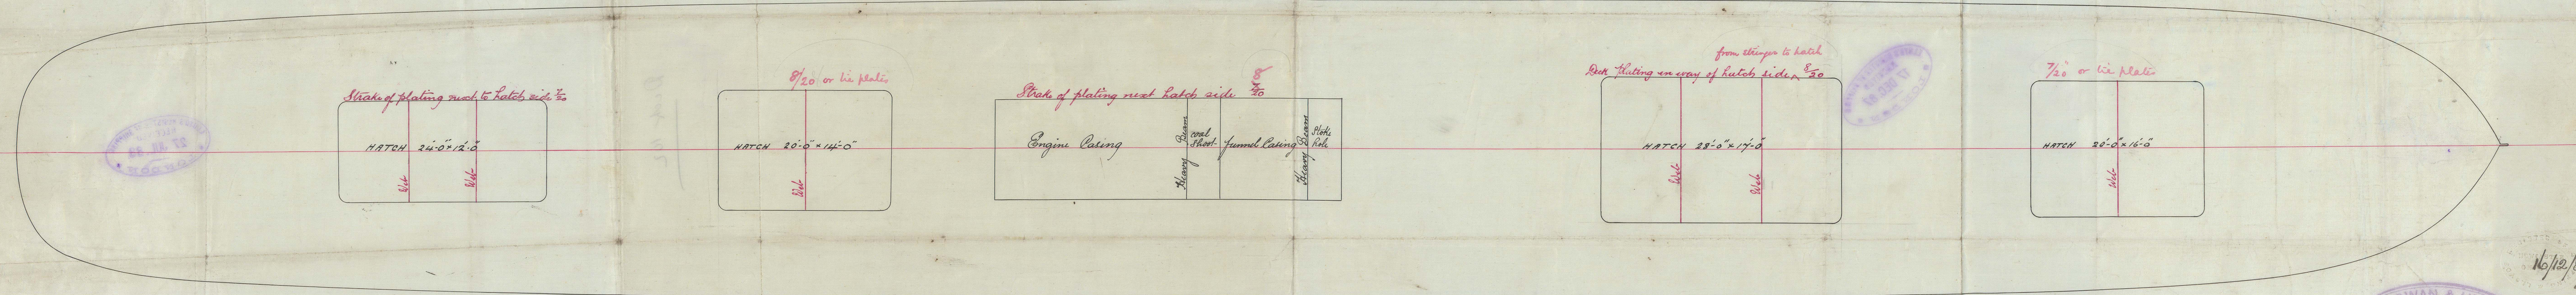

C. S. SWAN & HUNTER
IRON SHIPBUILDERS
DATE Dec^r 15th 1887
N° 6407
WALLINGFORD
NEWCASTLE-ON-TYNE

16/12/87

$\frac{1}{2}$

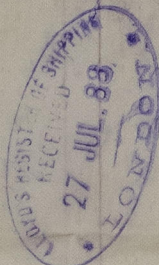

NWC 801-0268

Deck 102

10022-10023

Lloyd's Register
Foundation

10/10
10/10
10/10

2.2.87

LLSIN'S REGISTER
 RECEIVED
 17 DEC. 87
 LONDON

NEWCASTLE-ON-TYNE
 WALKER & HUNTER
 1881
 10407