

4/5/89

Lloyd's Register of British and Foreign Shipping.

(Report on Vessel No. 23135 Port Newcastle)

held

No. 1068a

SHIP FORGINGS OR CASTINGS.

I have to report that the undermentioned Iron or Steel Forgings or Castings, manufactured by Messrs R & H Hawthorn Leslie Co. of Newburn for the Vessel No. 12, being built by Messrs R Stephenson & Co. of Newburn have been inspected by me as set forth below, and found to be, so far as can be seen, sound

The words FORGINGS or CASTINGS, IRON or STEEL, should be struck out as may be required.

Mark on Forgings.

Lloyd's
No. 1068a
Ro Co


Alugh Cameron

Sunderland


3.5.89.

	STERN FRAME.	RUDDER FRAME.	STEM.
Material*	<u>Scrap iron</u>	<u>Scrap iron</u>	<u>Scrap iron</u>
How made	<u>Forged & Scraped</u>	<u>Forged</u>	<u>Forged</u>
Dimensions	<u>10 x 6"</u>	<u>7 3/4" - 8 1/4" with brass lining</u>	<u>10 x 2 3/4"</u>
Progress on Inspection	<u>Forged & Smithed</u>	<u>Forged & Smithed</u>	<u>Forged</u>
Dates when Inspected	<u>Nov 1-13-22 Dec 1-20-24/88</u>	<u>July 20-25-28 March 7</u>	<u>Dec 1/88</u>
	<u>Jan 12-14-19-21/89</u>	<u>11-15-26 April 2/89</u>	

SKETCHES OF FRAMES SHEWING POSITION AND DESCRIPTION OF WELDS OF FORGINGS, OR PARTICULARS OF TESTS APPLIED TO CASTINGS.

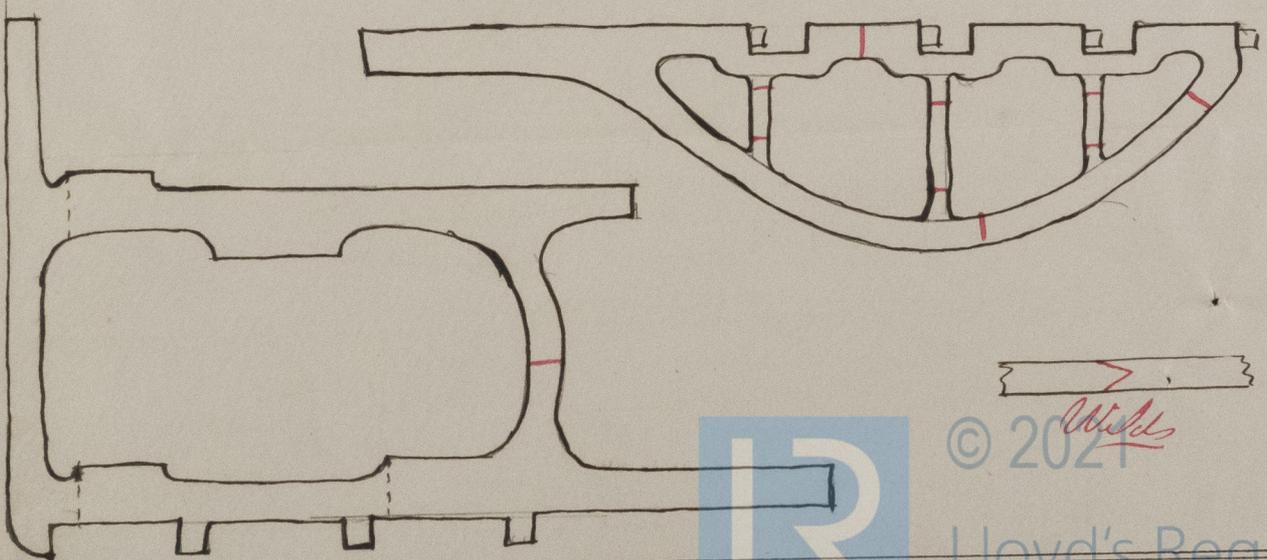

* If of Iron, state whether scrap or puddled iron.

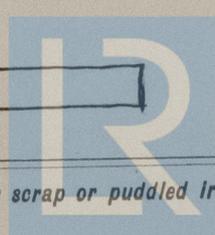

© 2021

Lloyd's Register Foundation




© 2021
Lloyd's Register
Foundation







