


S.S. Kolpinos New Report 123135.

TRACING NO. 714

THU 14 FEB 89

Callian bulkhead
to be watertight to
main deck.

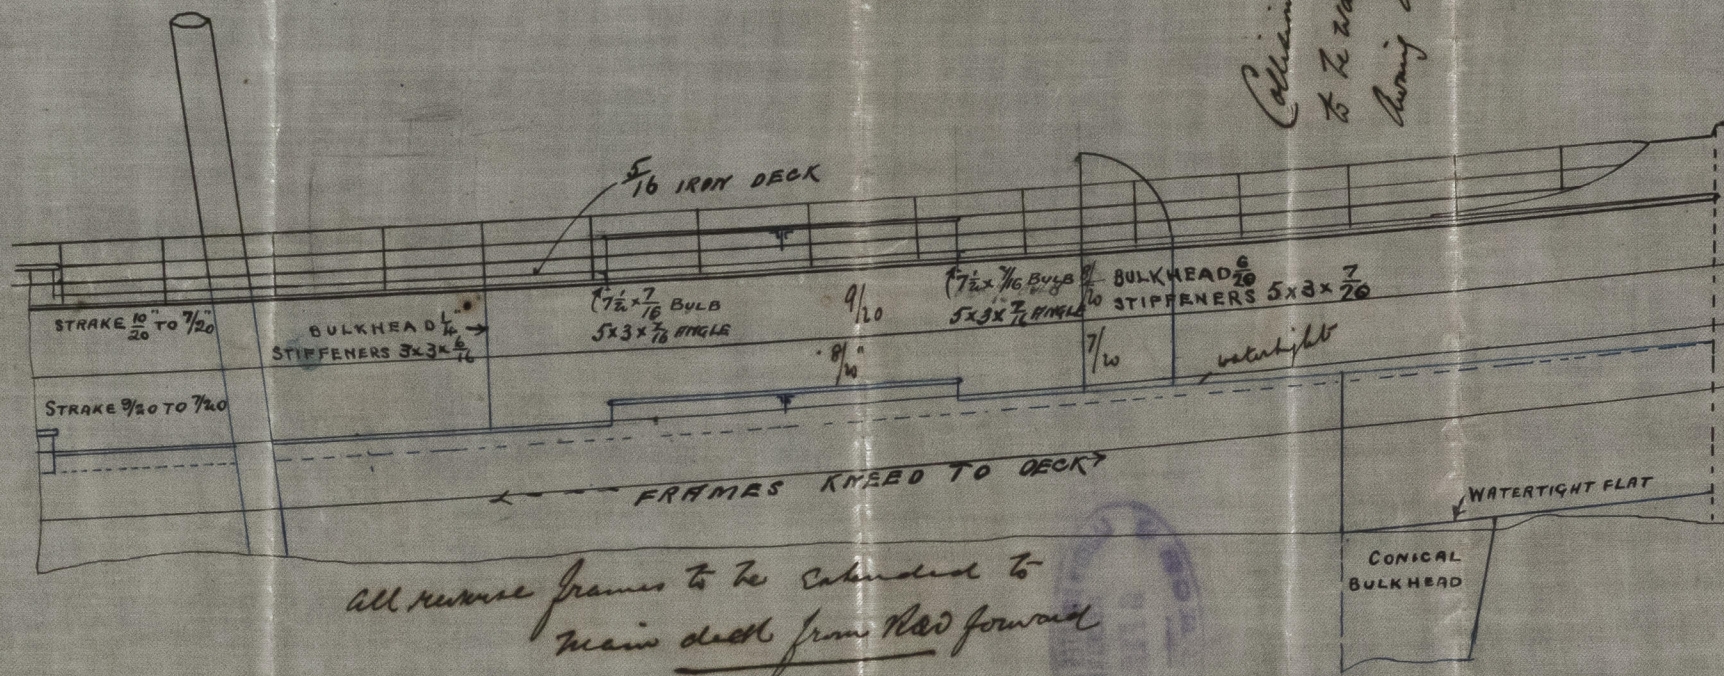



all reverse frames to be extended to
main deck from head forward

SKETCH SHOWING FILLING IN OF WELL



S.S. No 12.

SCALE 1/8" = ONE FOOT

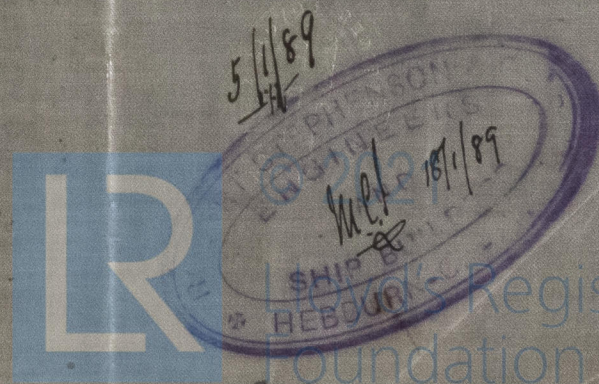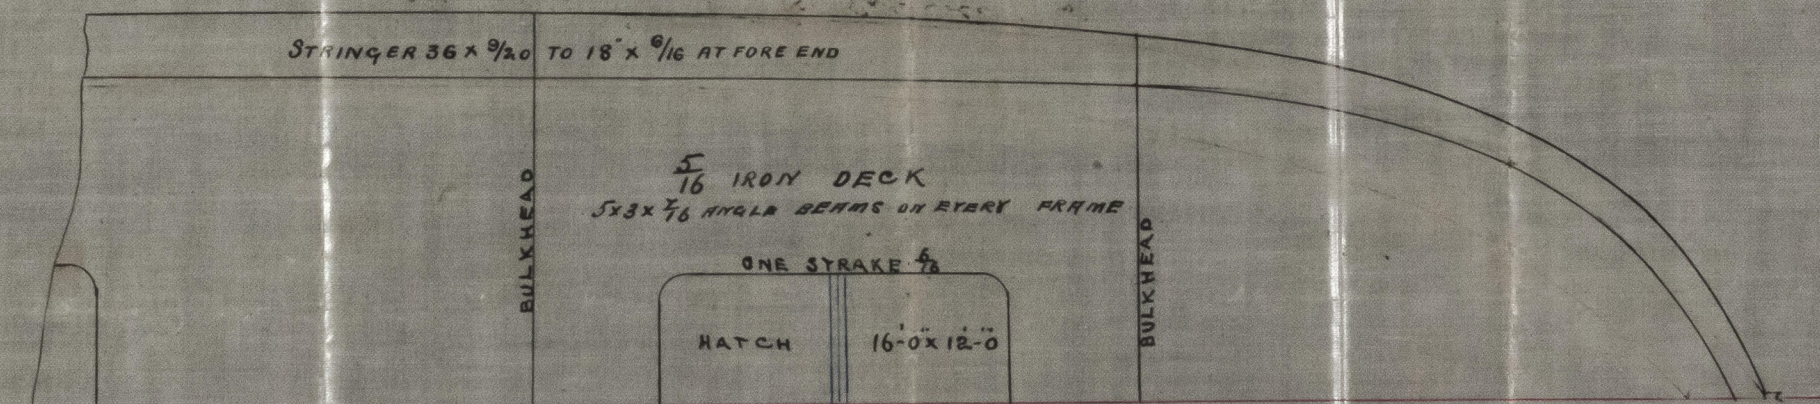

NWC809-0007

