


W. C. Volpino TRADING NO. 650 *Nav Report No 23135*
PUMPING ARRANGEMENT

No 12.S.S.


SCALE $\frac{1}{8}$ " = 1 FOOT.

ROBERT STEPHENSON & CO. LTD.
SHIP
15 OCT 88
YARD
HEBBURN-ON-TYNE

19.11.88
J.M.N. 12.11.88

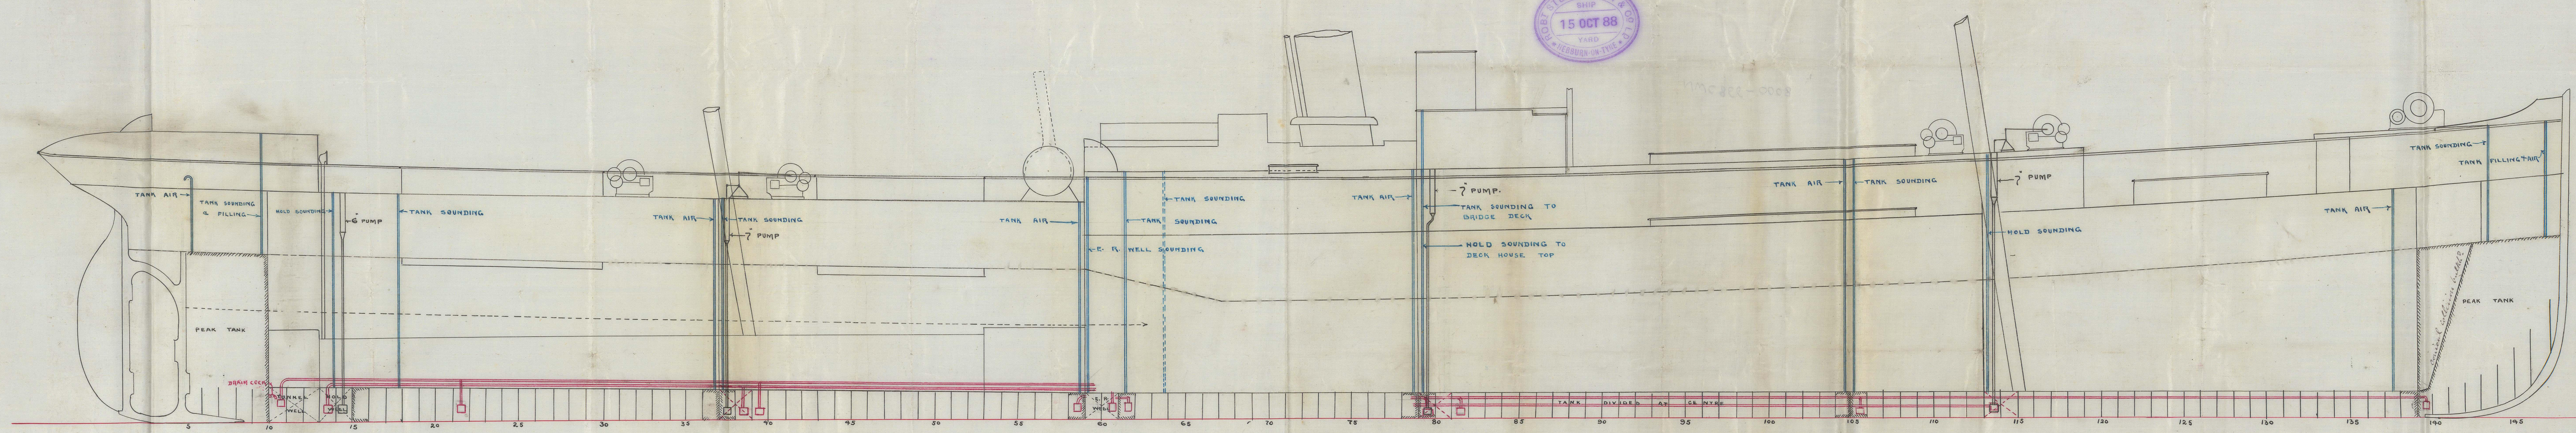


ROBERT STEPHENSON & CO. LTD.
SHIP
18 NOV 88
YARD
HEBBURN-ON-TYNE

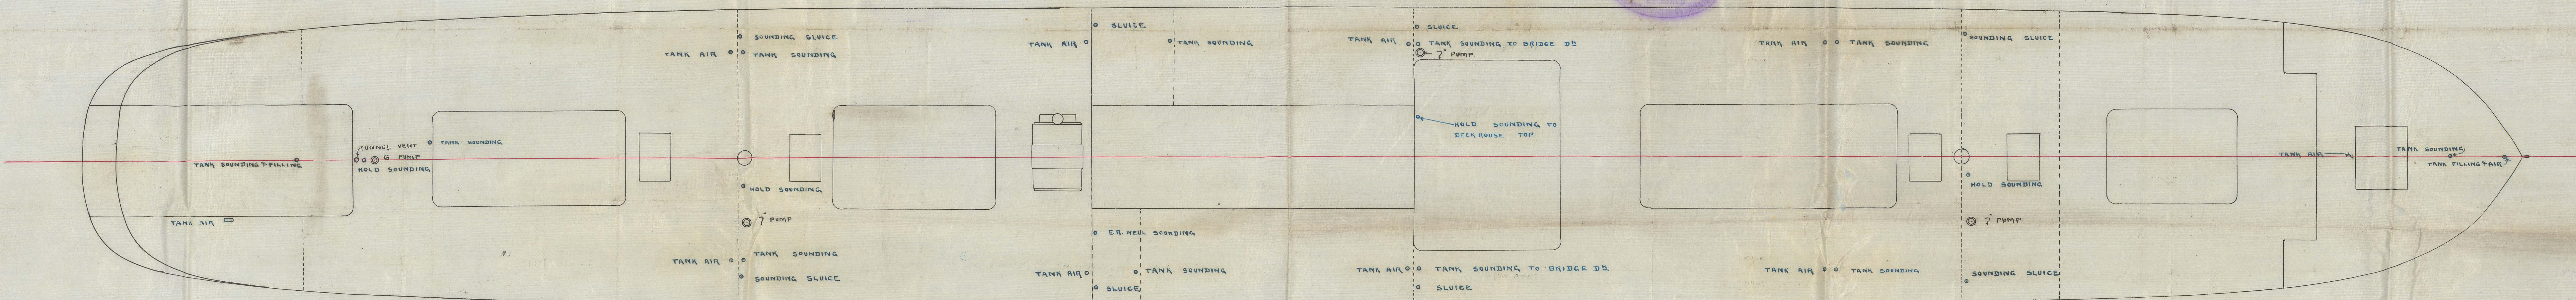


ROBERT STEPHENSON & CO. LTD.
ENGINEERS
AND
SHIP BUILDERS
HEBBURN-ON-TYNE


19.11.88

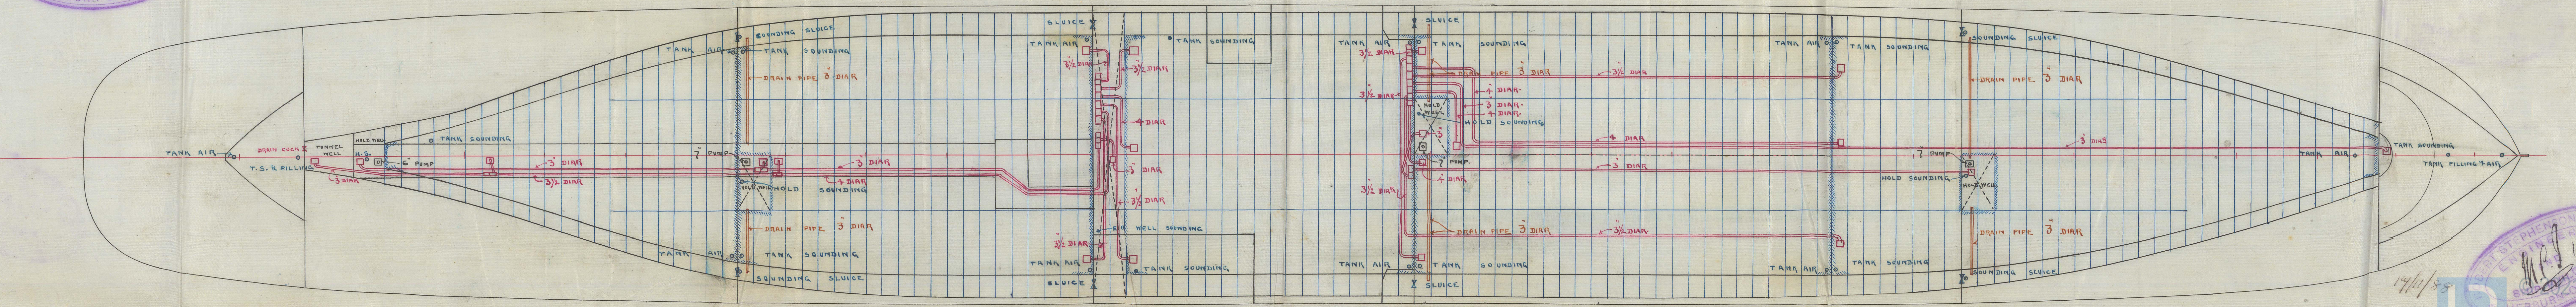

ROBERT STEPHENSON & CO. LTD.
SHIP
19 NOV 88
YARD
HEBBURN-ON-TYNE

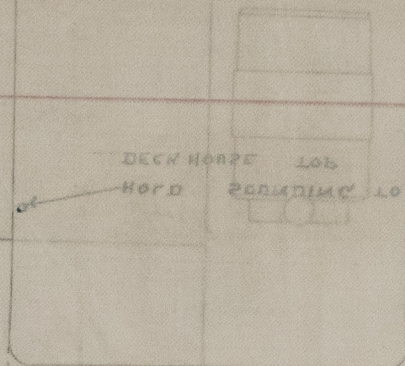

LLOYD'S REGISTER OF SHIPPING
RECEIVED
19 NOV. 83
LONDON

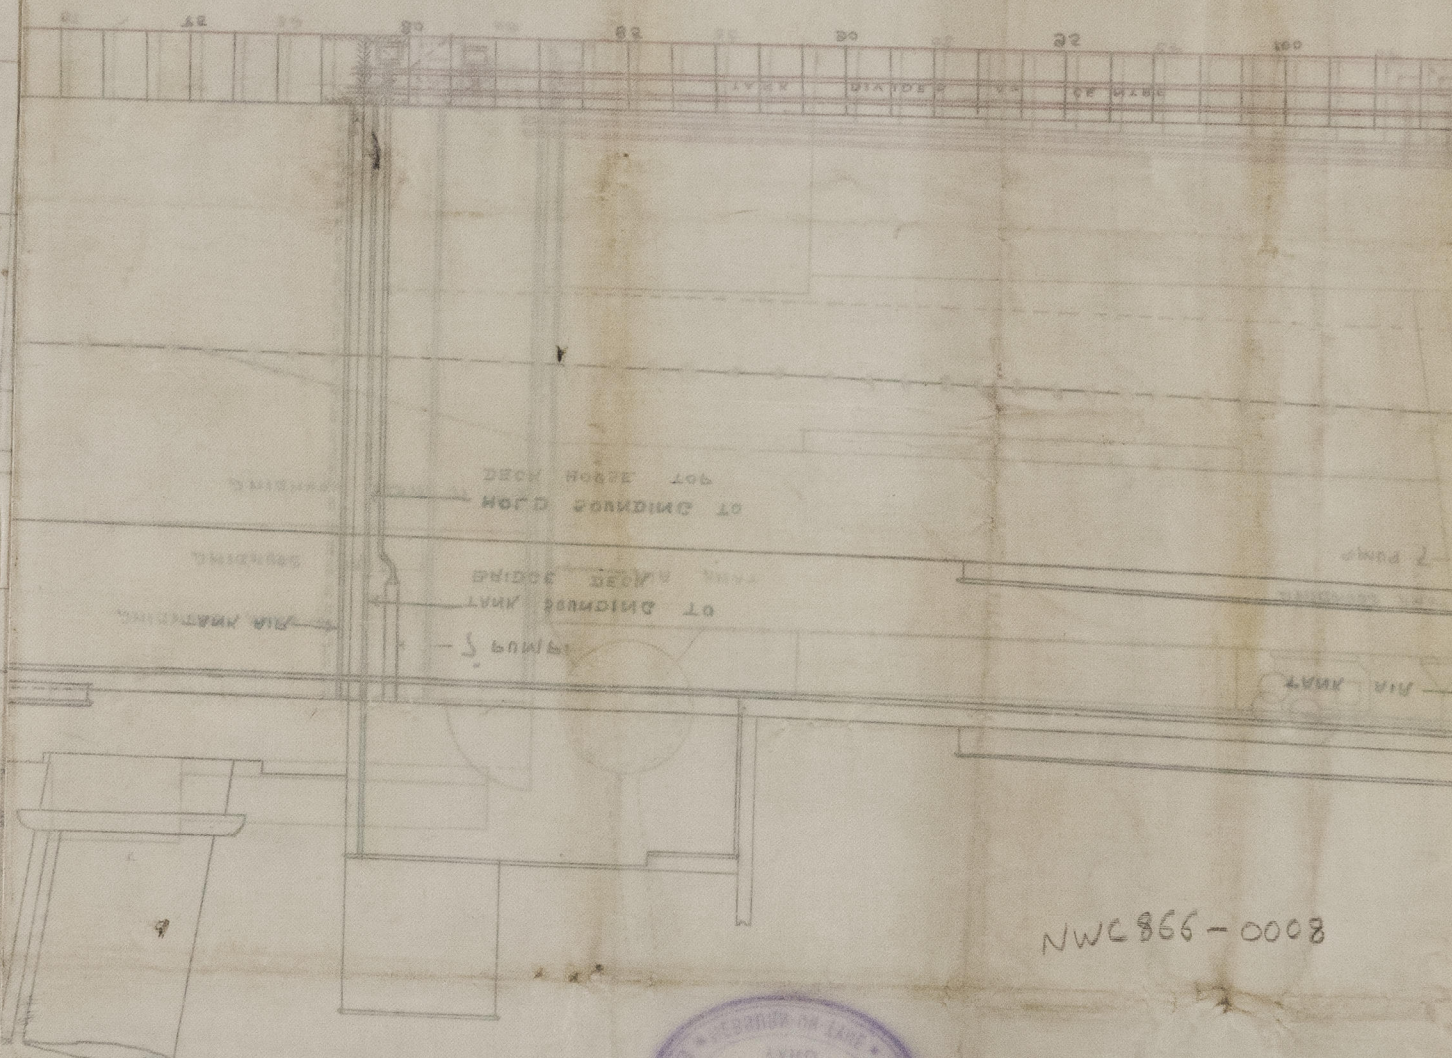

NWC 866-0008

LLOYD'S REGISTER OF SHIPPING
RECEIVED
12 OCT 88
LONDON

SCALE 1" = 100'

No 15.22

IMPROVEMENT



© 2021

Lloyd's Register
Foundation