



TRACING NO. 446

SCALE  $\frac{1}{2}" = 1 \text{ FOOT.}$

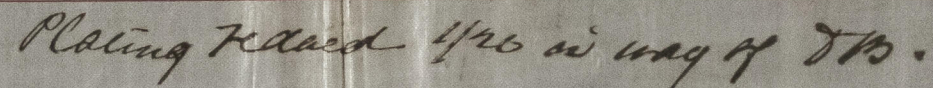

Glancings mit app<sup>8</sup>  
See letter b<sup>d</sup> Sell-100

174

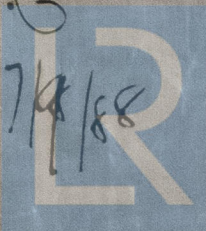

Lloyd's Register  
NW4809-0011