



Received
Acknowledged

TRACING NO. 461
S. S. No 12
ARRANGEMENT OF BEAMS . ETC
SCALE $\frac{1}{8}$ - 1 FOOT

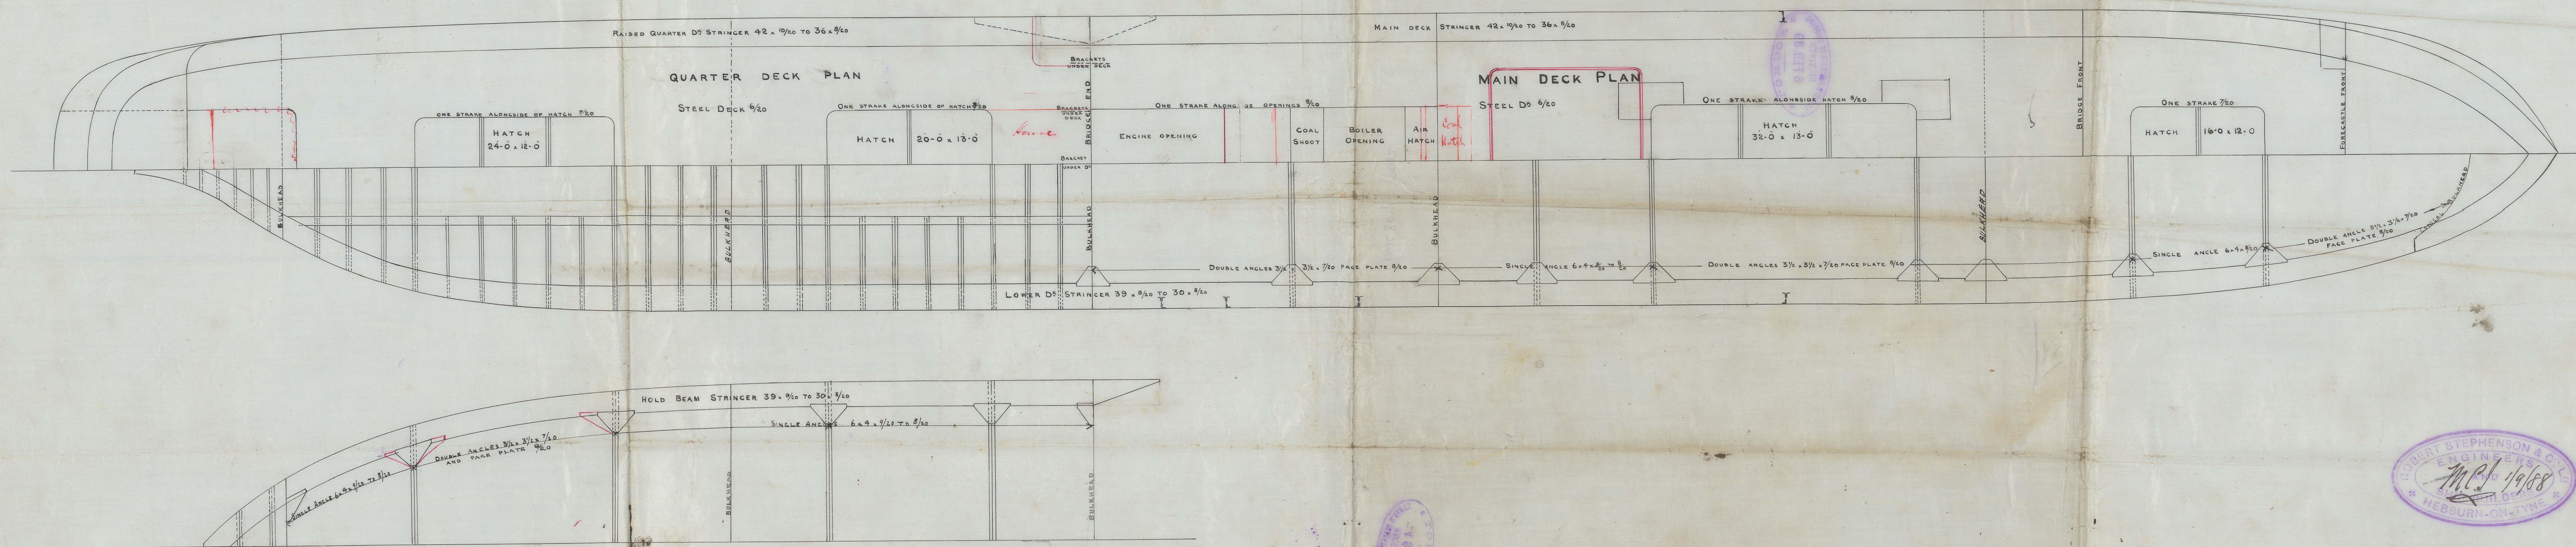

3/9/8

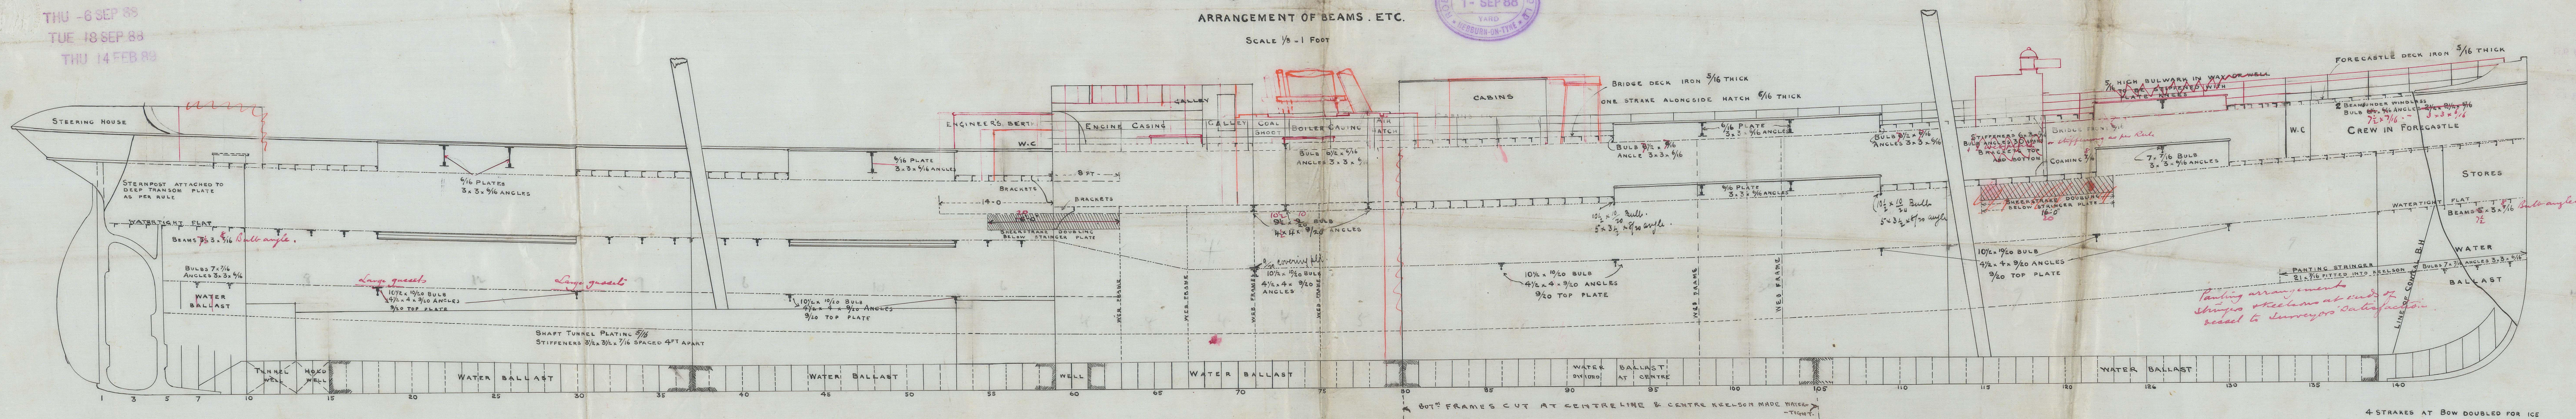