

15/5/89

# Lloyd's Register of British and Foreign Shipping.

*Rele*

(Report on Vessel No. 23137 Port Newcastle)

## No. 1144 a SHIP FORGINGS OR CASTINGS.

I have to report that the undermentioned Iron or Steel Forgings or Castings, manufactured by Stockton Forge Co & R S Bagnall Son of Stockton & Newton for the Vessel No. 114 a, being built by Wm Swan Hunter of Newcastle have been inspected by me as set forth below, and found to be, so far as can be seen, sound.

The words FORGINGS or CASTINGS, IRON or STEEL, should be struck out as may be required.

Mark on Forgings.


Lloyd's  
No. 1144 a  
10 C

*Wm Swan Hunter*


*Sunderland 3.5.89*

	<i>Stockton Forge</i> STERN FRAME.	<i>Stockton Forge</i> RUDDER FRAME.	<i>R S Bagnall Son</i> STEM.
Material*	<i>Scrap iron</i>	<i>Scrap iron</i>	<i>Scrap iron</i>
How made	<i>Forged</i>	<i>Forged</i>	<i>Forged</i>
Dimensions	<i>9" x 5 1/2"</i>	<i>4" x 3 1/2"</i>	<i>19" x 2 1/2"</i>
Progress on Inspection	<i>Forged Smithed</i>	<i>Forged Smithed</i>	<i>Forged</i>
Dates when Inspected	<i>Nov 8-14 Dec 14-19/88 Jan 4-9-15/89</i>	<i>Feb 18 March 6-9-22/89</i>	<i>Dec 18/88</i>

SKETCHES OF FRAMES SHEWING POSITION AND DESCRIPTION OF WELDS OF FORGINGS, OR PARTICULARS OF TESTS APPLIED TO CASTINGS.

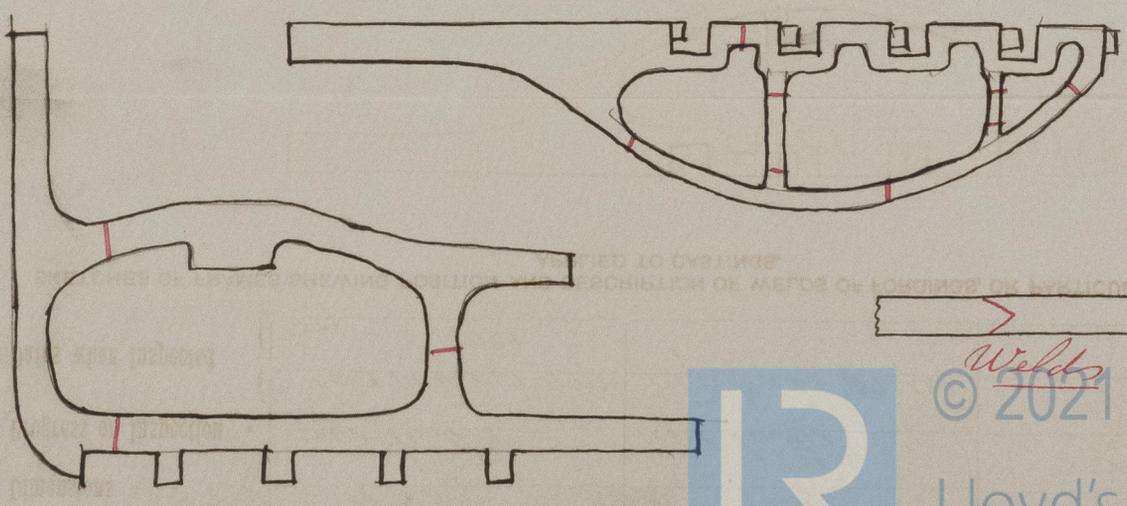

\* If of Iron, state whether scrap or puddled iron.

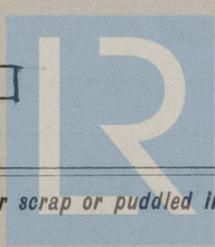

© 2021

Lloyd's Register Foundation








© 2021  
Lloyd's Register  
Foundation