


S. Fifechire


Newcastle No 20711.

9/87

10.2.87.
16.3.87
19.5.87
2/6/87

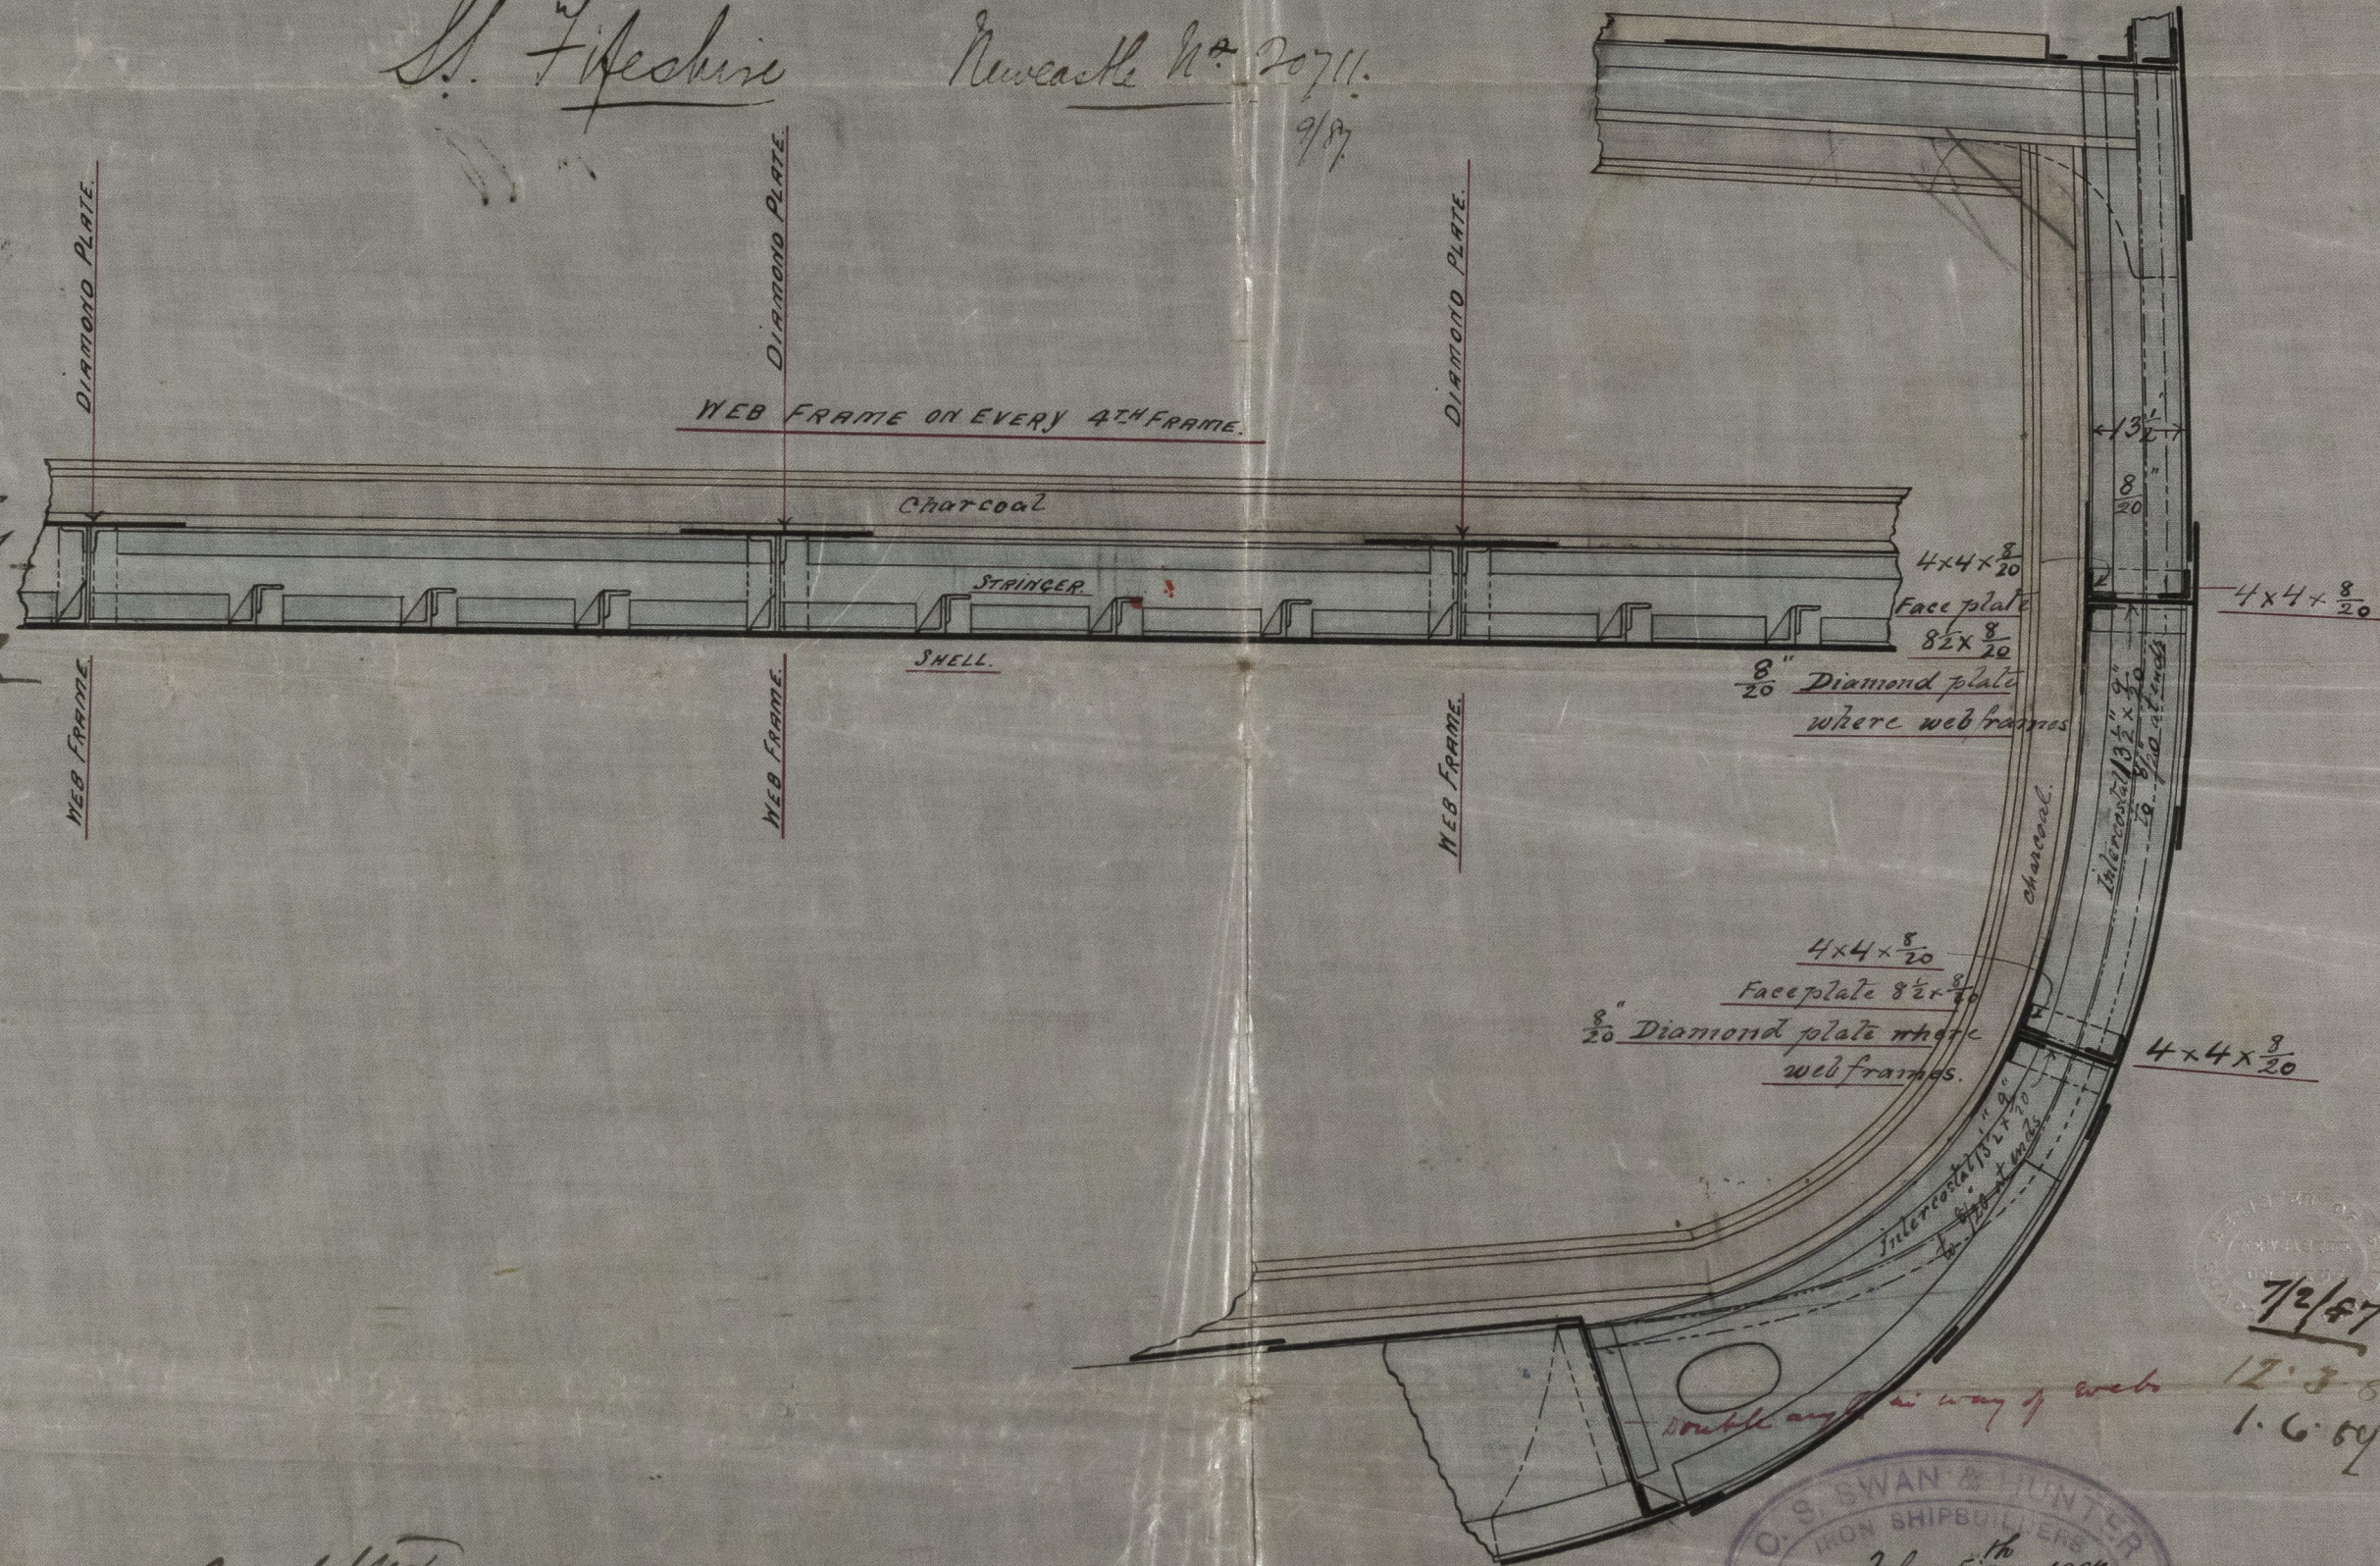

See letter 10/7/87

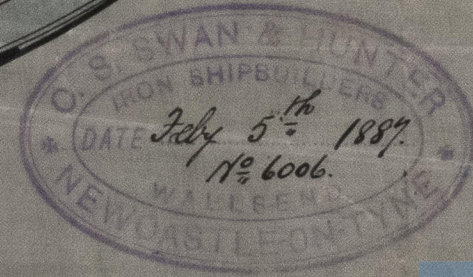

7/2/87
12.3.87
1.6.87



© 2021

Lloyd's Register
Foundation