

# Lloyd's Register of British and Foreign Shipping.

(Report on Vessel No. 23164 Port Newcastle)

Steel

## No. 1089A. SHIP FORGINGS OR CASTINGS.

The words FORGINGS or CASTINGS, IRON or STEEL, should be struck out as may be required.

I have to report that the undermentioned Iron or Steel Forgings or Castings, manufactured by Messrs Hawthorn Leslie & Co. of Widburn for the Vessel No. 287, being built by Messrs Hawthorn Leslie & Co. of Widburn have been inspected by me as set forth below, and found to be, so far as can be seen, sound

Mark on Forgings.


**Lloyd's**  
No. 1089A  
L.R. Co.

*Wm Cameron*

*Sunderland 9/4/89*

	STERN FRAME.	RUDDER FRAME.	STEM.
Material*	<i>Scrap iron</i>	<i>Scrap iron</i>	<i>Scrap iron</i>
How made	<i>Forged</i>	<i>Forged</i>	<i>Forged</i>
Dimensions	<i>11' x 7'</i>	<i>9' - 4 1/2"</i>	<i>11' x 3'</i>
Progress on Inspection	<i>Forged &amp; Smithed</i>	<i>Forged &amp; Smithed</i>	<i>Forged</i>
Dates when Inspected	<i>Oct 1-9-12. Nov 1-13-20/88</i>	<i>Feb 12-20 25-28 March 7</i> <i>11-15. May 28 June 3-17 22 July 2/89</i>	<i>Oct 1/88</i>

SKETCHES OF FRAMES SHEWING POSITION AND DESCRIPTION OF WELDS OF FORGINGS, OR PARTICULARS OF TESTS APPLIED TO CASTINGS.

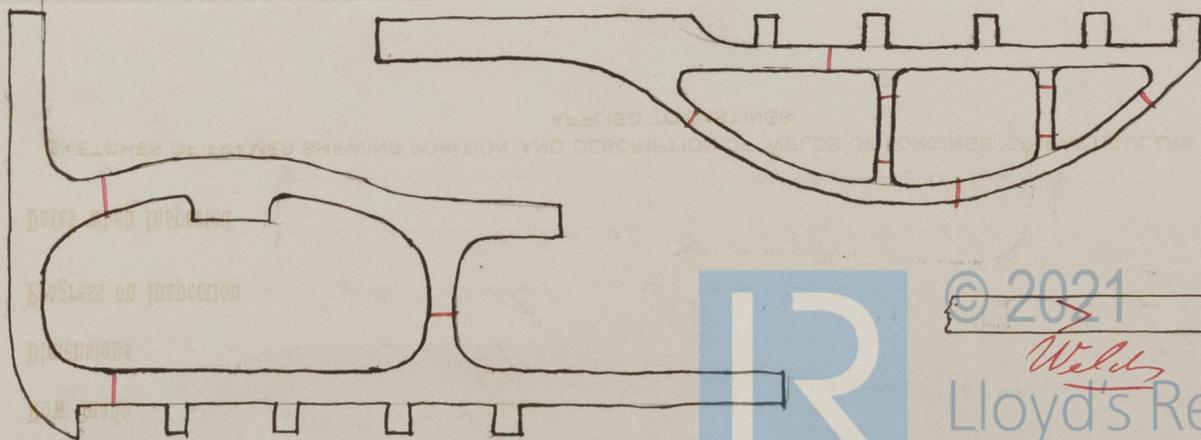

1089

Hawthorn Leslie

N<sup>o</sup> 287

J



© 2021

Lloyd's Register  
Foundation