

Asst Engineer "McClelland" No 2308H
Asst Engineer "McClelland" No 2308H


No 235.

ELEVATION AND DECK


SCALE 1" = 10'

CLASS 100A, LLOYD'S, 3 DECK RULE

STEEL

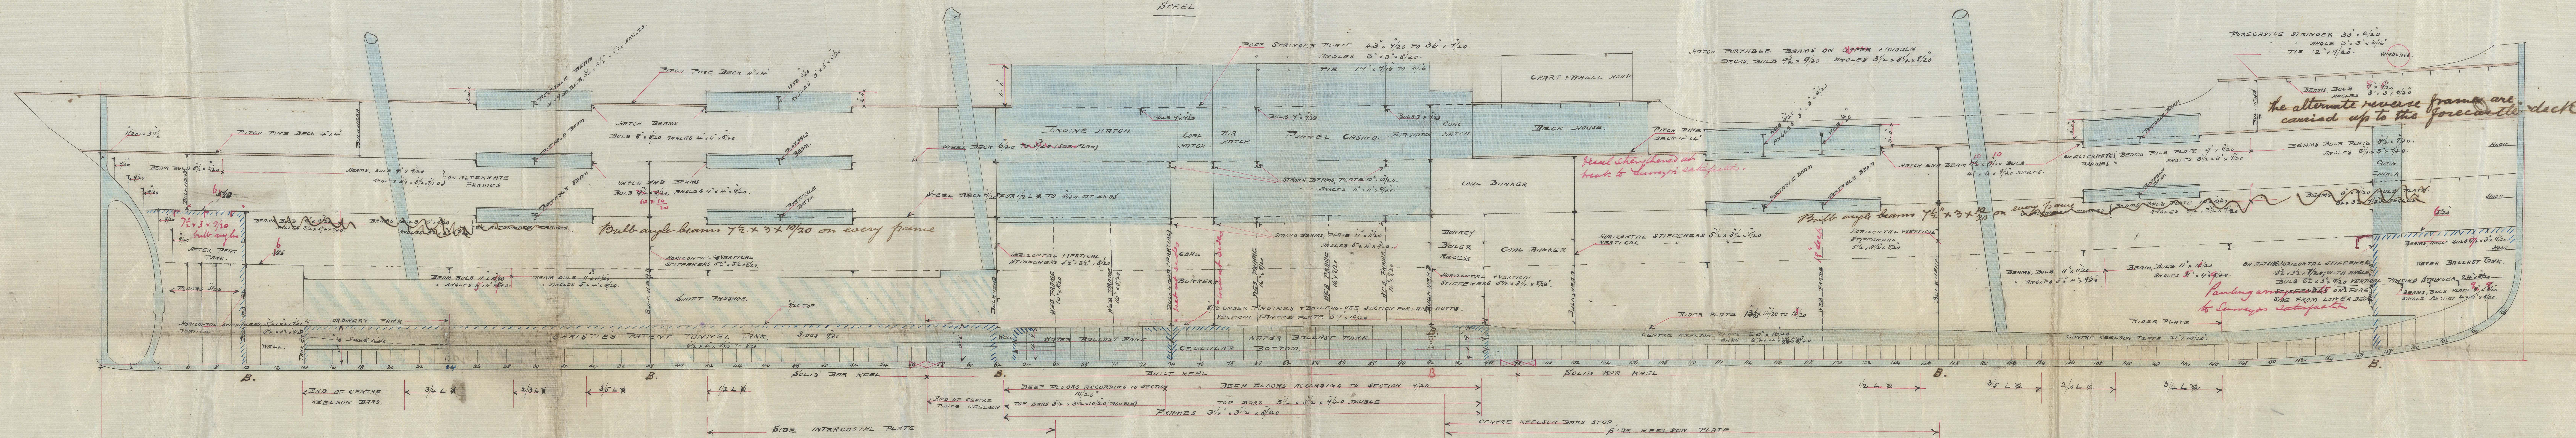

UPPER DECK PLAN.

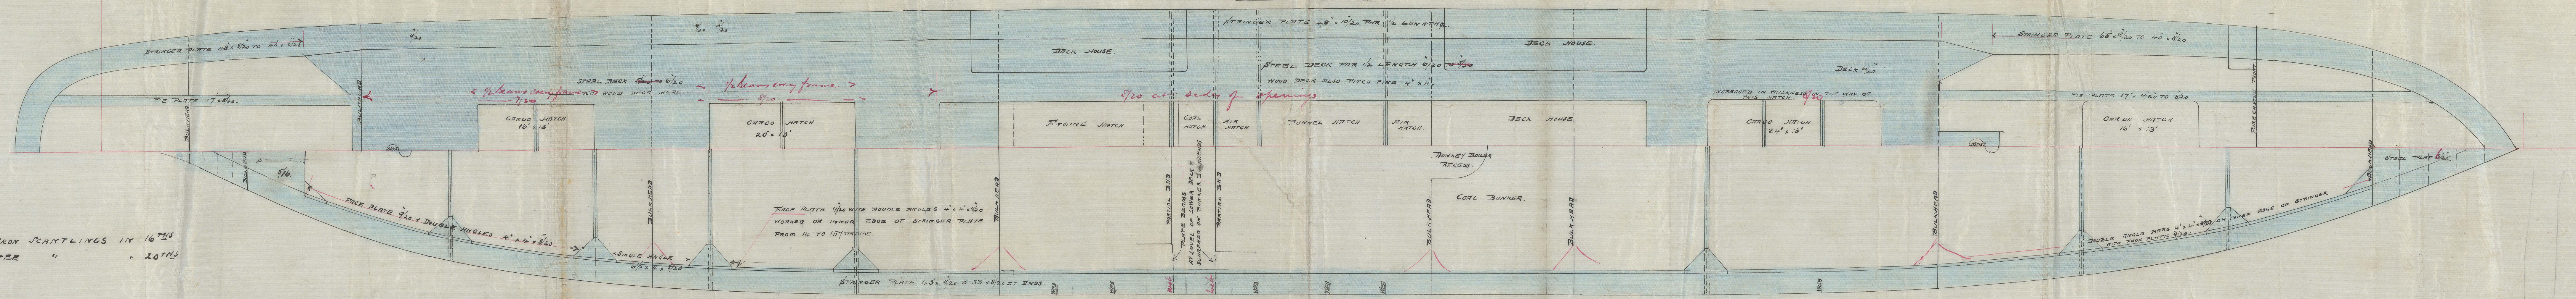

LOWER DECK PLAN.

11.3 IRON SCANTLINGS IN 16" 25
 STEEL " " 20" 15

11/1/89



11/1/89

235-

NWC810-0260



TOMES JACK STAIN




PLAN OF DECK 2

100' x 100'

ELEVATION AND DECK 2

No 522

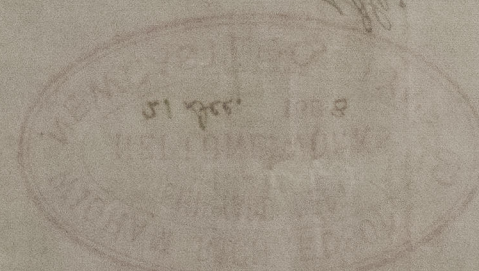




© 2021

Lloyd's Register Foundation

