

## Lloyd's Register of British and Foreign Shipping.

(Report on Vessel No. 235743 Port Newcastle)No. 89

## SHIP FORGINGS OR CASTINGS.

The words FORGINGS or CASTINGS, IRON or STEEL, should be struck out as may be required.

I have to report that the undermentioned Iron or ~~Steel~~ Forgings or ~~Castings~~, manufactured by Messrs J March & Co of Dunston for the Vessel No. 236, being built by Messrs W Richardson of Newcastle have been inspected by me as set forth below, and found to be, so far as can be seen, Sound


Mark on Forgings.

Lloyd's  
No. 1314A  
96

John C CraigNewcastle11/10/89

	STERN FRAME.	RUDDER FRAME.	STEM.
Material* - - - -	/	<u>Scrap Iron</u>	
How made - - - -		<u>Forged</u>	
Dimensions - - - -		<u>7 3/4 - 3 3/4</u>	
Progress on Inspection -		<u>Forged &amp; Smithed</u>	<u>Not Seen</u>
Dates when Inspected {		<u>July 12-19-24 Aug 1-8-10</u> <u>15-27 Sept 2-6-11/89</u>	

SKETCHES OF FRAMES SHEWING POSITION AND DESCRIPTION OF WELDS OF FORGINGS, OR PARTICULARS OF TESTS APPLIED TO CASTINGS.

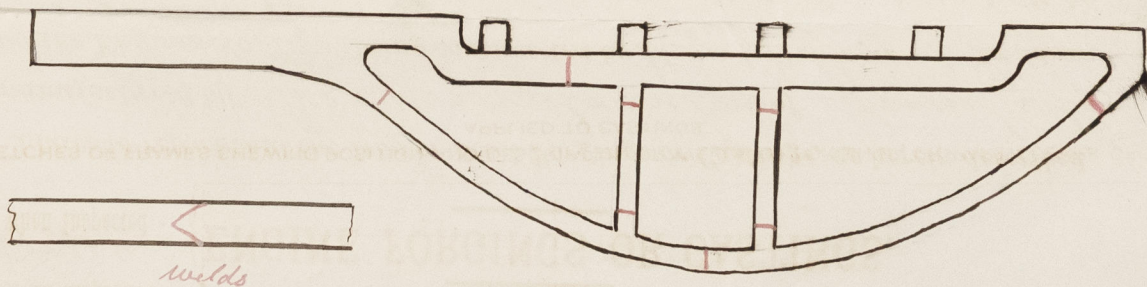

© 2021

Lloyd's Register  
Foundation



W Richardson & Co

Nº 236

SHIP FORGINGS OR CASTINGS.





© 2021

Lloyd's Register  
Foundation