

Newcastle Freeboard Report No 22525 'Fenore'

No 236


ELEVATION & DECKS

SCALE 1/8" = 1 FOOT

TO CLASS 100 A1 LLOYD'S SPAR DECK RULE



THU 28 FEB 89
SAT 16 MAR 89

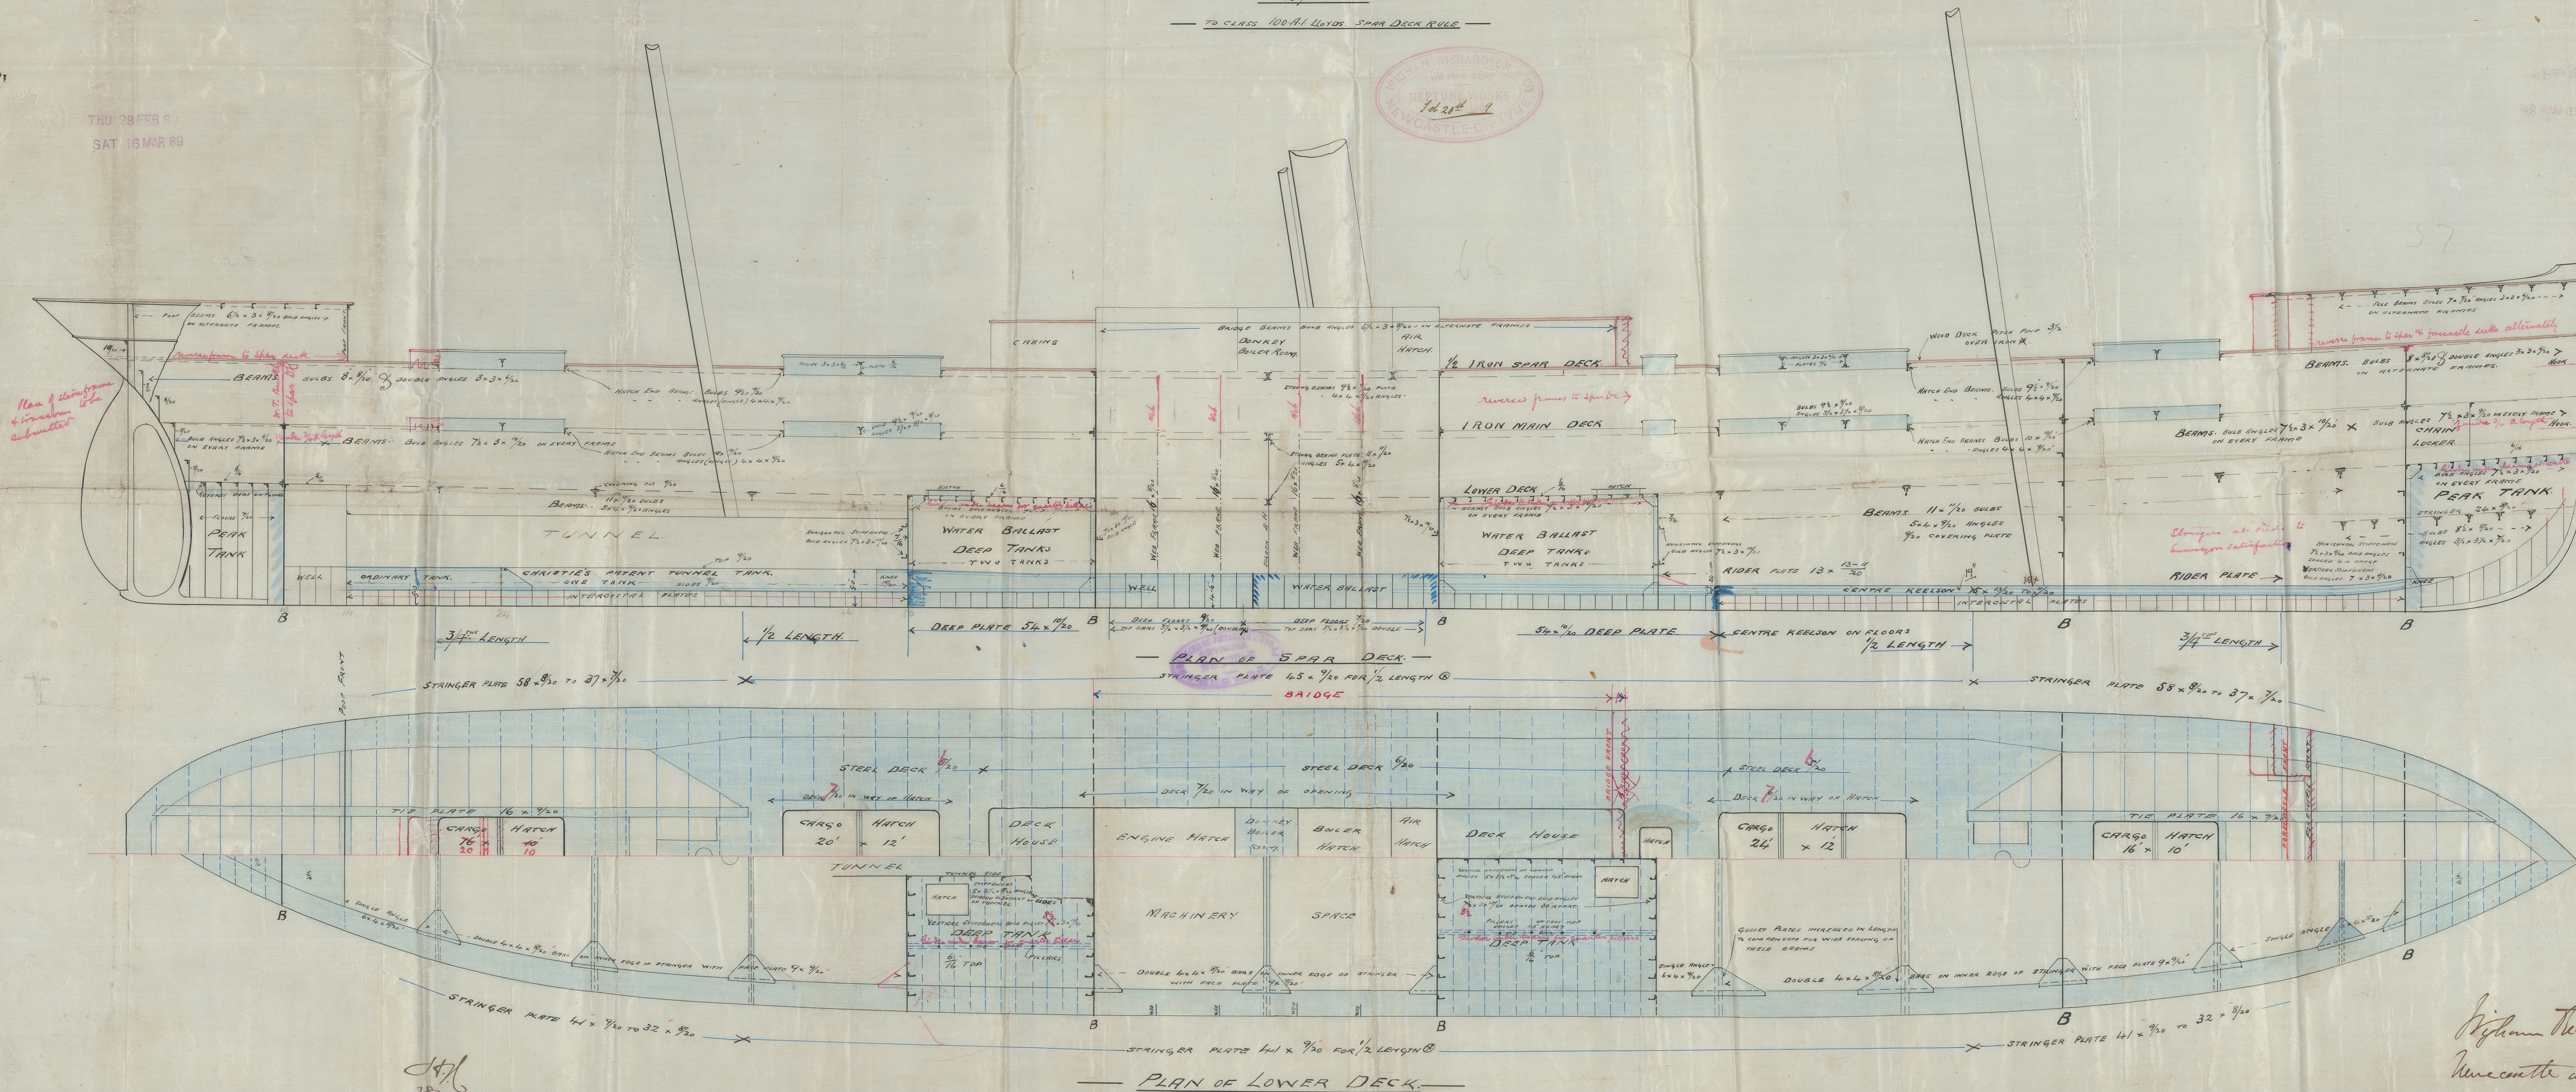

Wigham Richardson & Co. Ltd.
Newcastle-on-Tyne
20/2/89
12th Feb 1889








NWC 811-0227



PLAN OF LOWER D

28/2/89
 28/2/89



© 2021
 Lloyd's Register
 Foundation

NWC 811-0227