

No 236

MIDSHIP SECTION

Scale 1" = 1 FT.  
CLASS 100 A1 LLOYDS  
SPAR DECK RULE

**DIMENSIONS**  
LENGTH B.P. 318.0"  
BREADTH M. 41.0"  
DEPTH M. 30.0"  
DEPTH OF HOLD 28.92"  
EQUIPMENT NUMBER 32499

FORECASTLE STRINGER 30 x 7/16  
TIE PLATES 12 x 7/16  
BARS 3 x 3 x 7/16  
POOP STRINGER 30 x 7/16  
TIE PLATES 12 x 7/16  
BARS 3 x 3 x 7/16

LLOYDS NUMERALS


38.67 = 1/2 GIRTH = 38.67  
20.50 = 1/2 BREADTH = 20.50  
23.17 = DEPTH = 23.17  
316.33 x 82.34 = 1<sup>ST</sup> NUMBER 81.84 x 314.33  
26046 = 2<sup>ND</sup> NUMBER = 26,888

PROPORTIONS

13.6 = DEPTHS TO LENGTH 13.8  
7.7 = BREADTHS TO LENGTH 7.7

APPROXIMATE TONNAGE UNDER DECK

FOR FREEBOARD 28.00 TONS  
SHEER FOR - 6.0"  
KEY - 2.0"  
APPROXIMATE LENGTH OF POOP 28.0"  
BRIDGE 68.0"  
FORECASTLE 35.0"

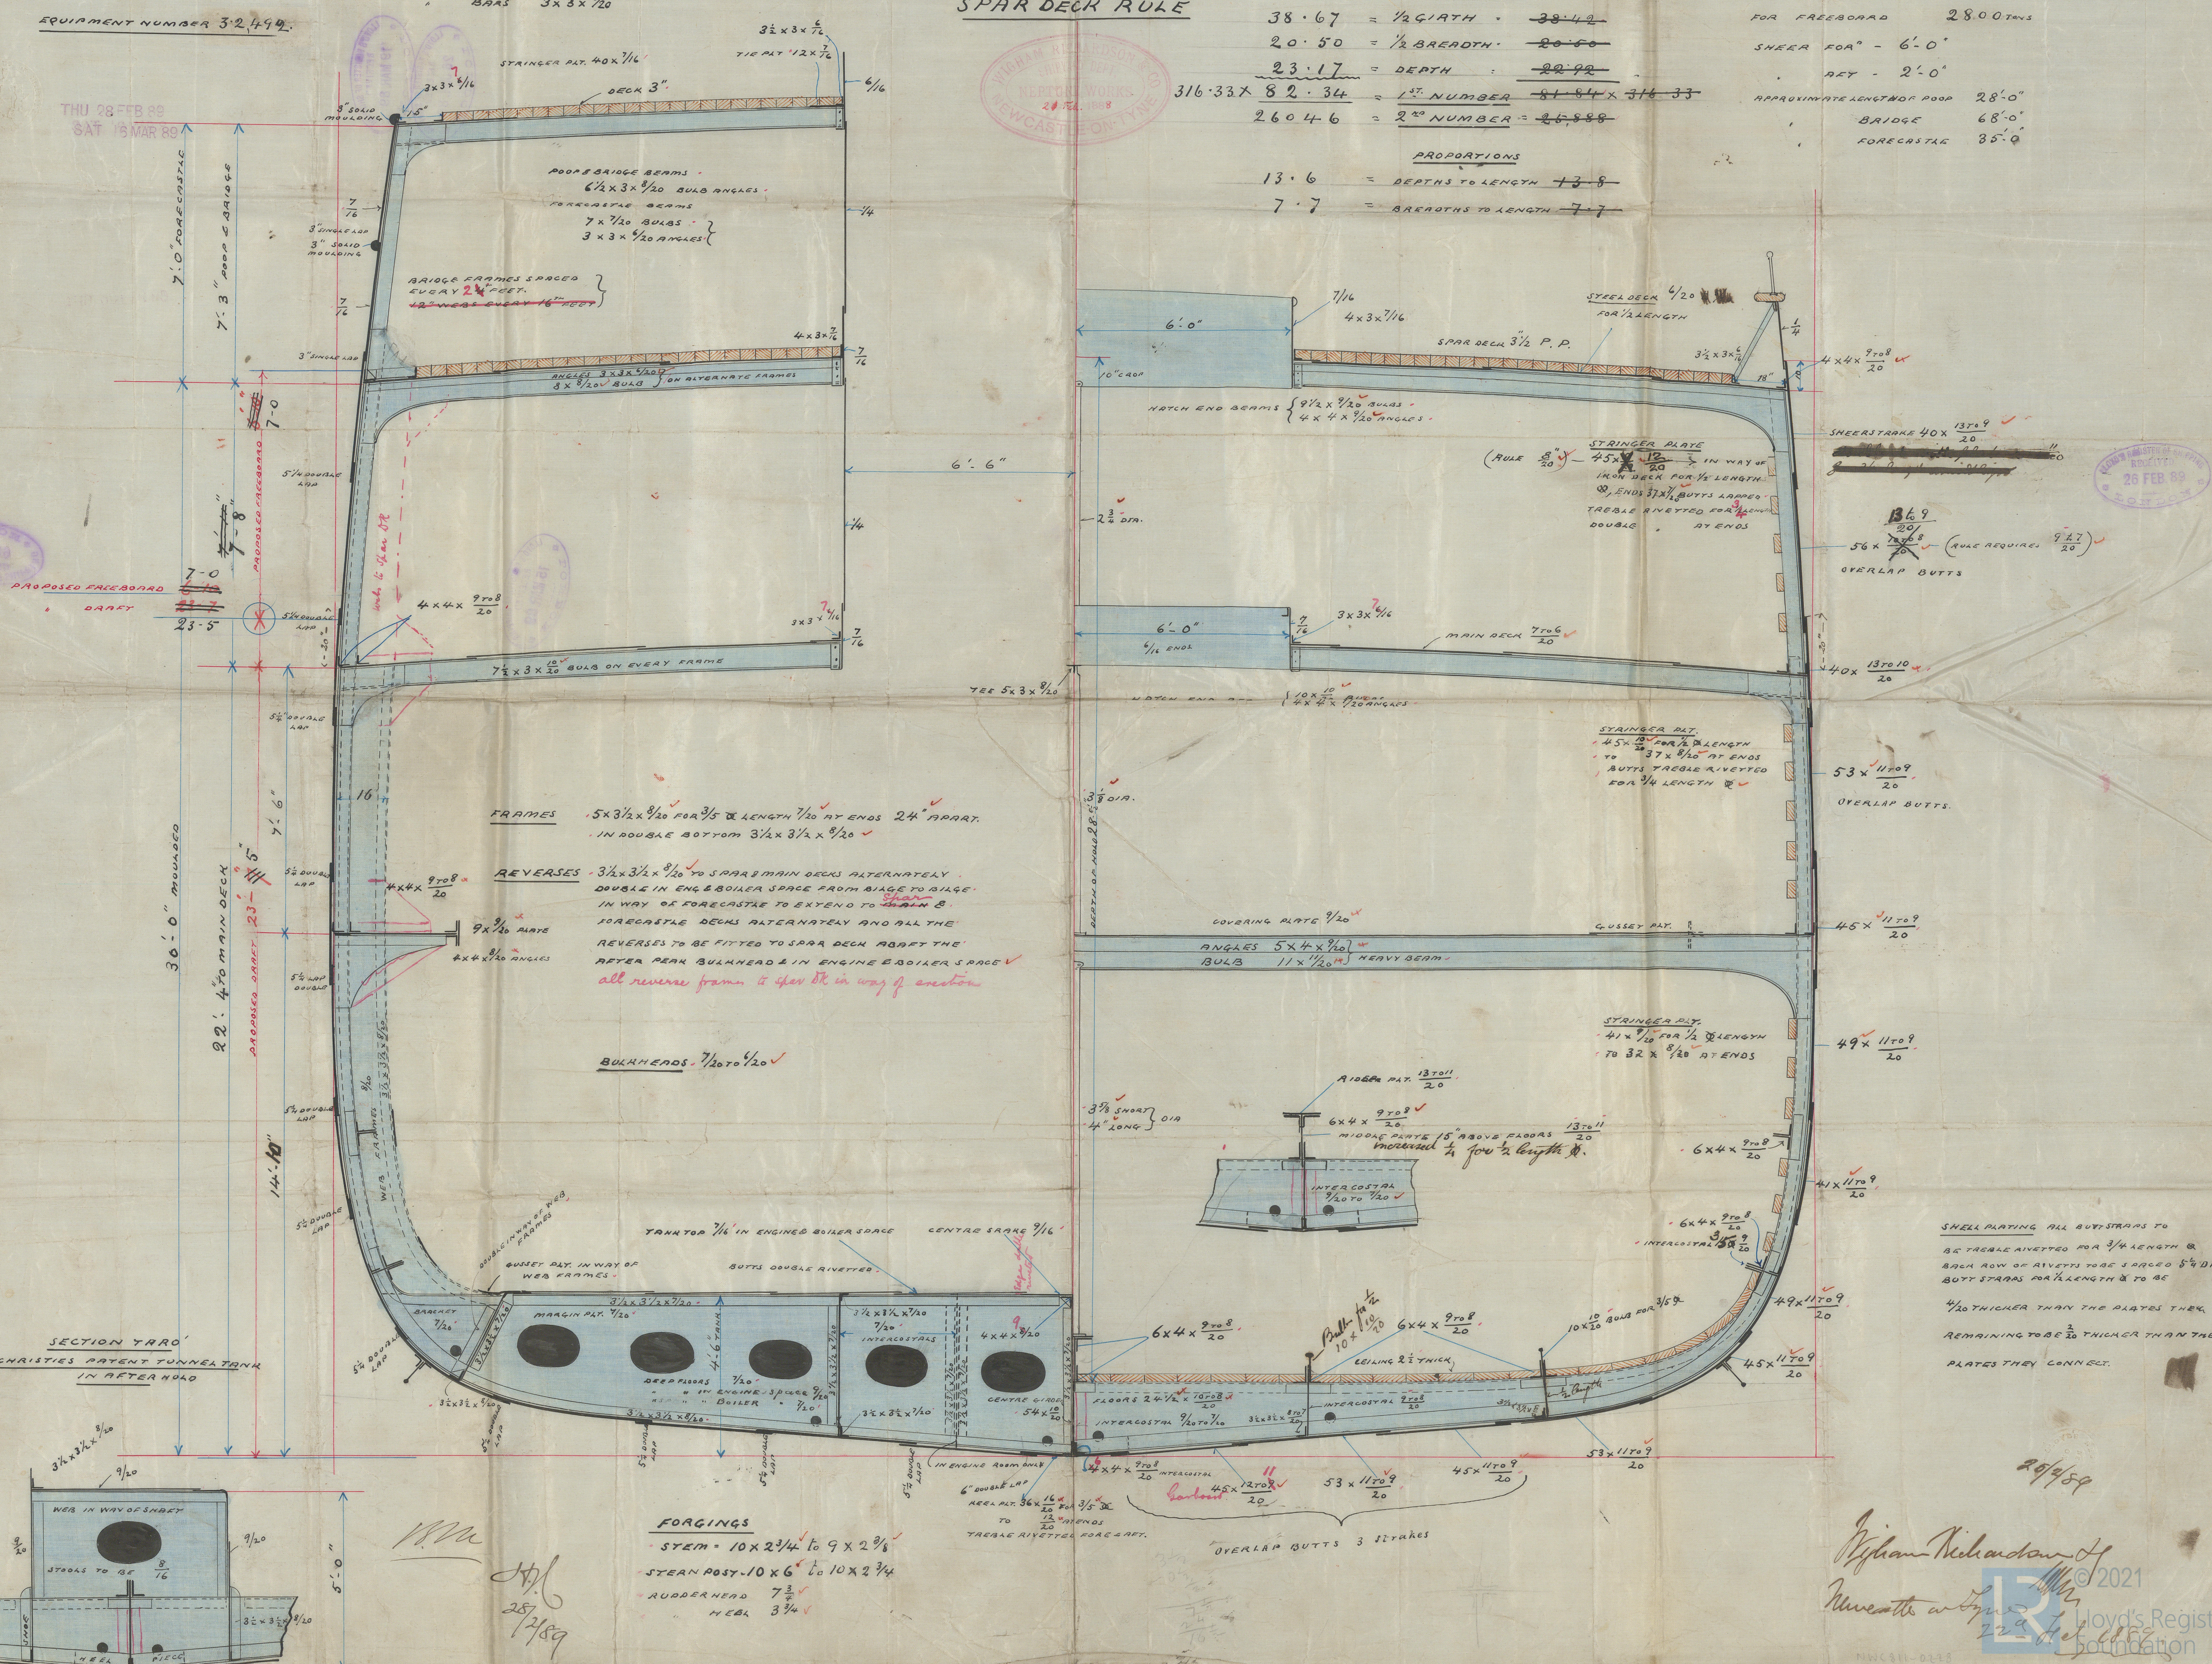



LLOYD'S REGISTER OF SHIPPING  
RECEIVED  
2-DEC. 89  
LONDON

REMARKS  
DECK 28'-2 1/2"  
DECK 30'-0"  
DECK 31'-0"  
REMARKS 318'-0"

DIMENSIONS

LLOYD'S REGISTER OF SHIPPING  
RECEIVED  
15 MAR 89  
LONDON

LLOYD'S REGISTER OF SHIPPING  
RECEIVED  
15 MAR 89  
LONDON

2220-11828

REMARKS 30 x 1/2"

3 x 3 x 1/2"

2220-11828

2220-11828

316-3

