

Lk 20/8/88

Three Steel boilers for Engines No 2116 + 2132


for a working pressure of 160 lbs per square inch. Test 320 lbs in

All material of steel, except tubes & girders



Holes drilled in place where practicable

-1 inch scale.

16.8.88

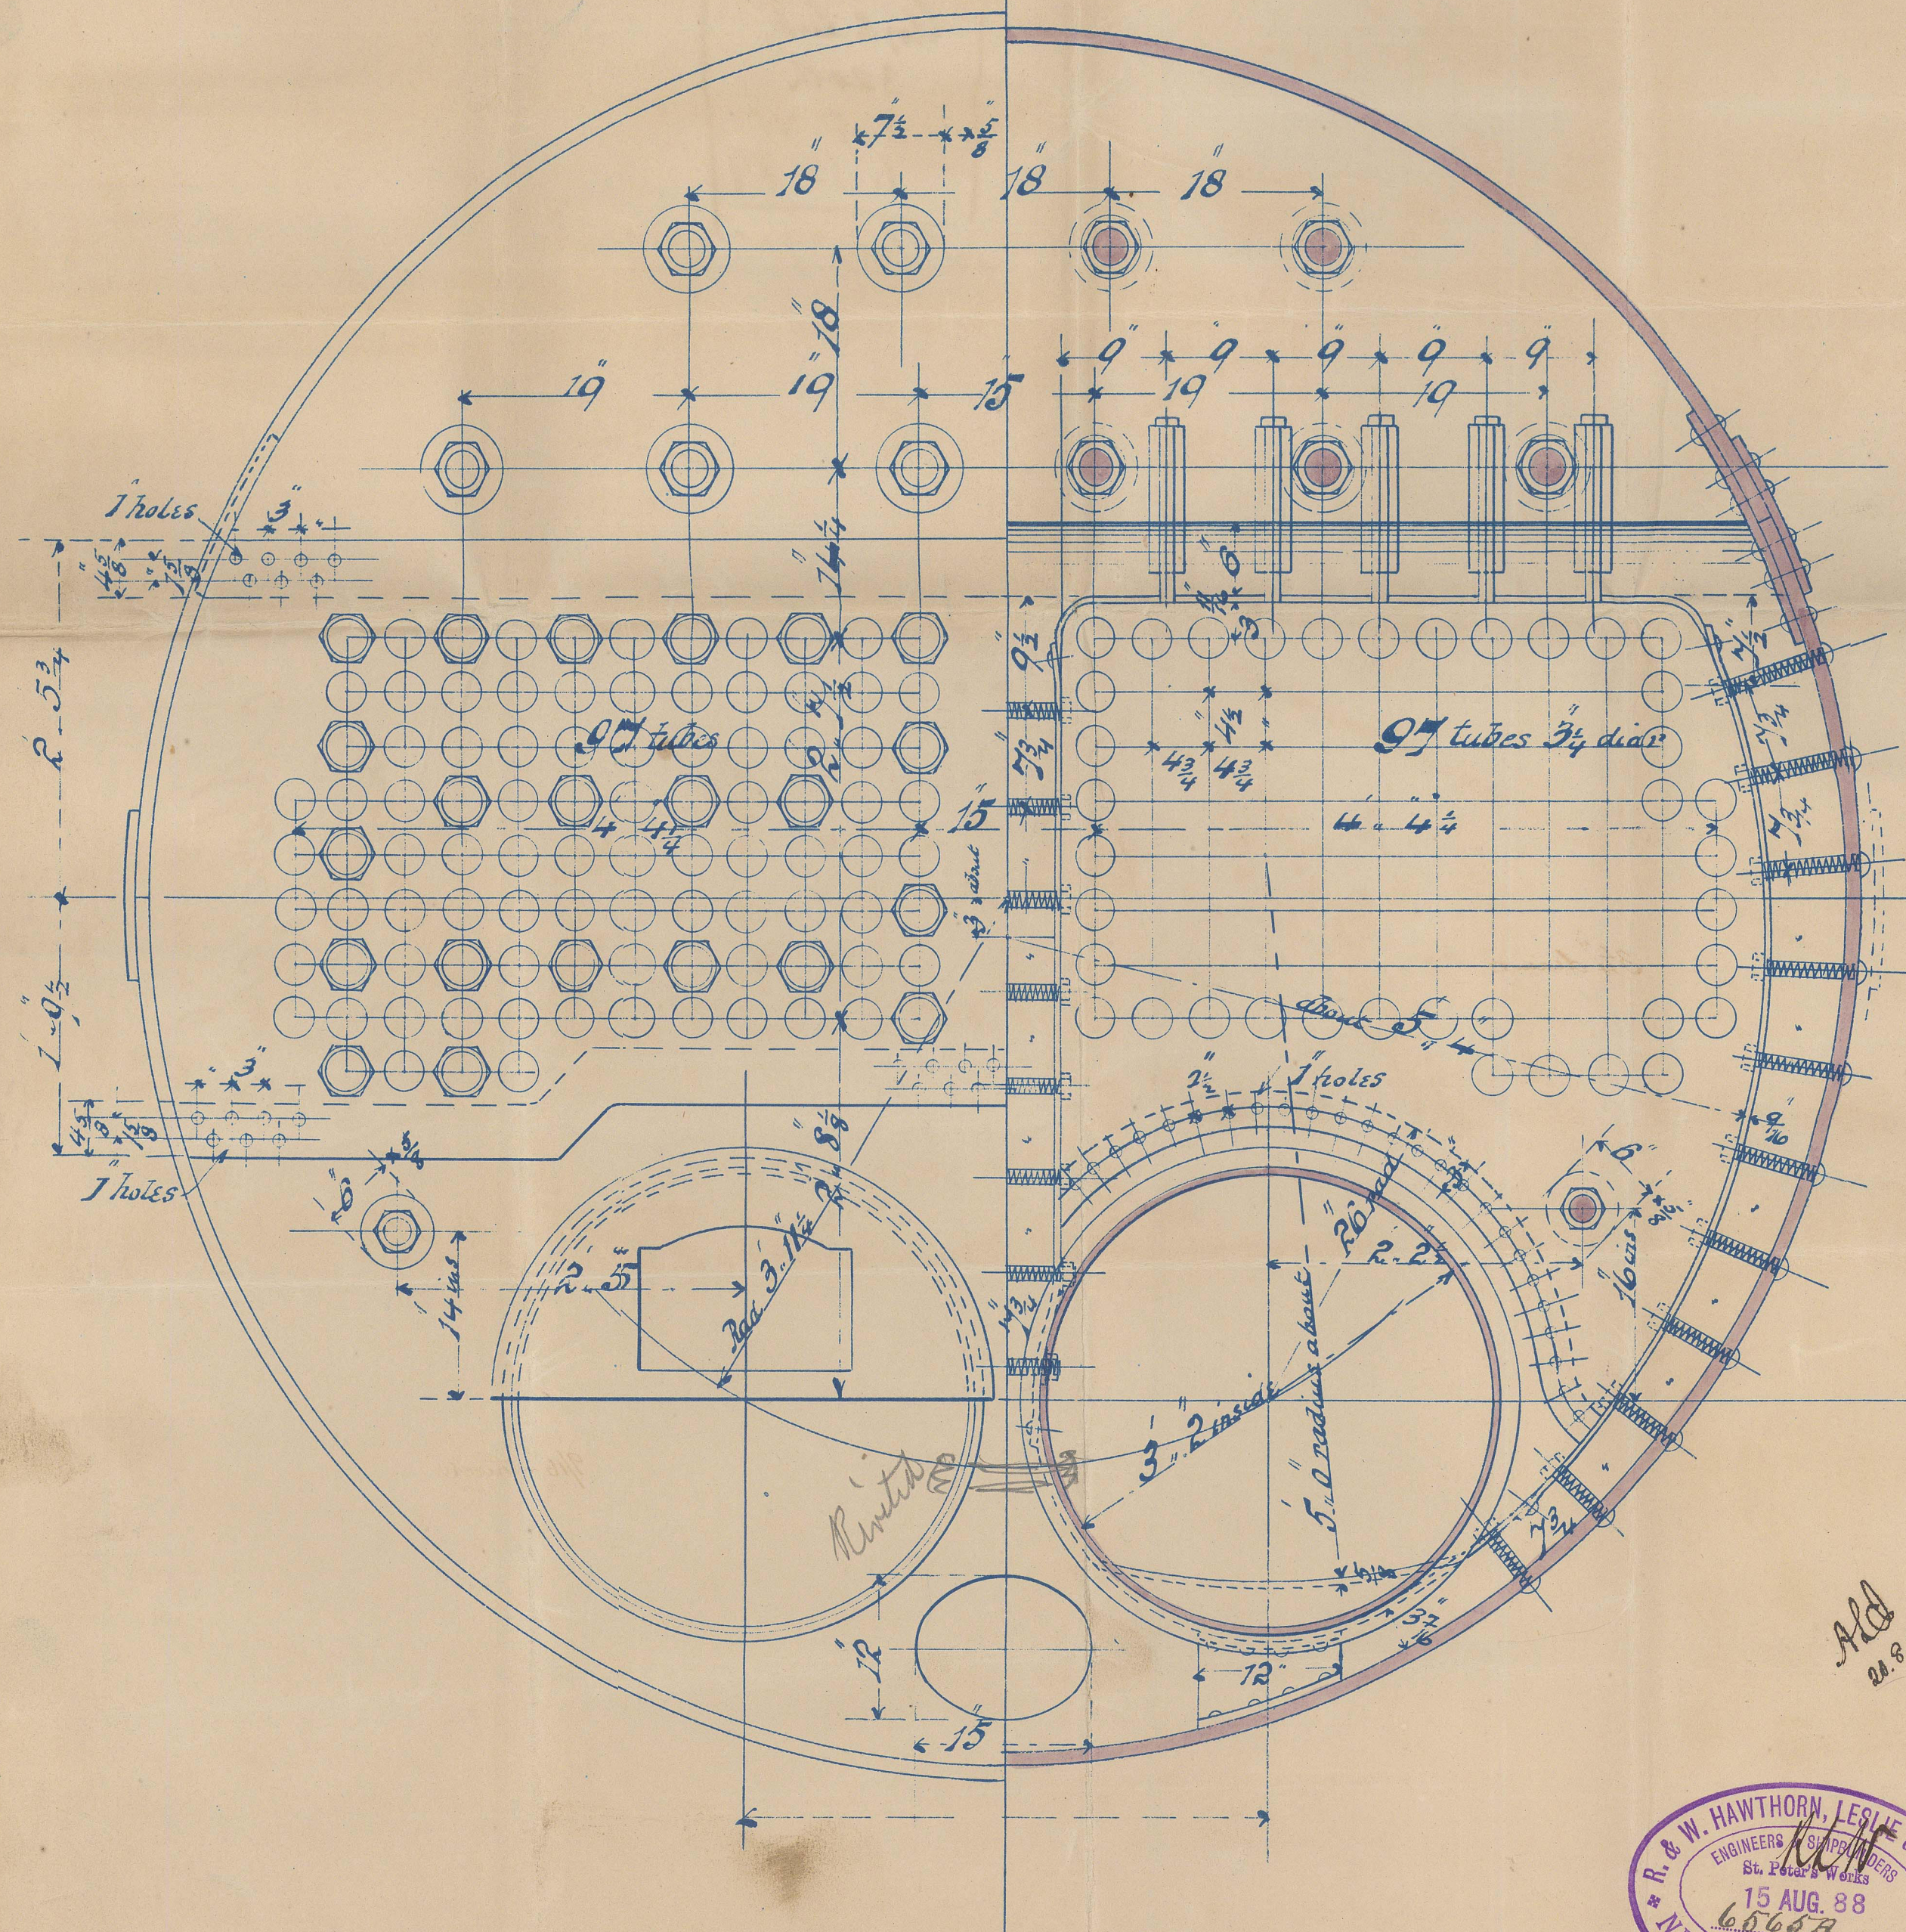

Ad  
24.8.88.

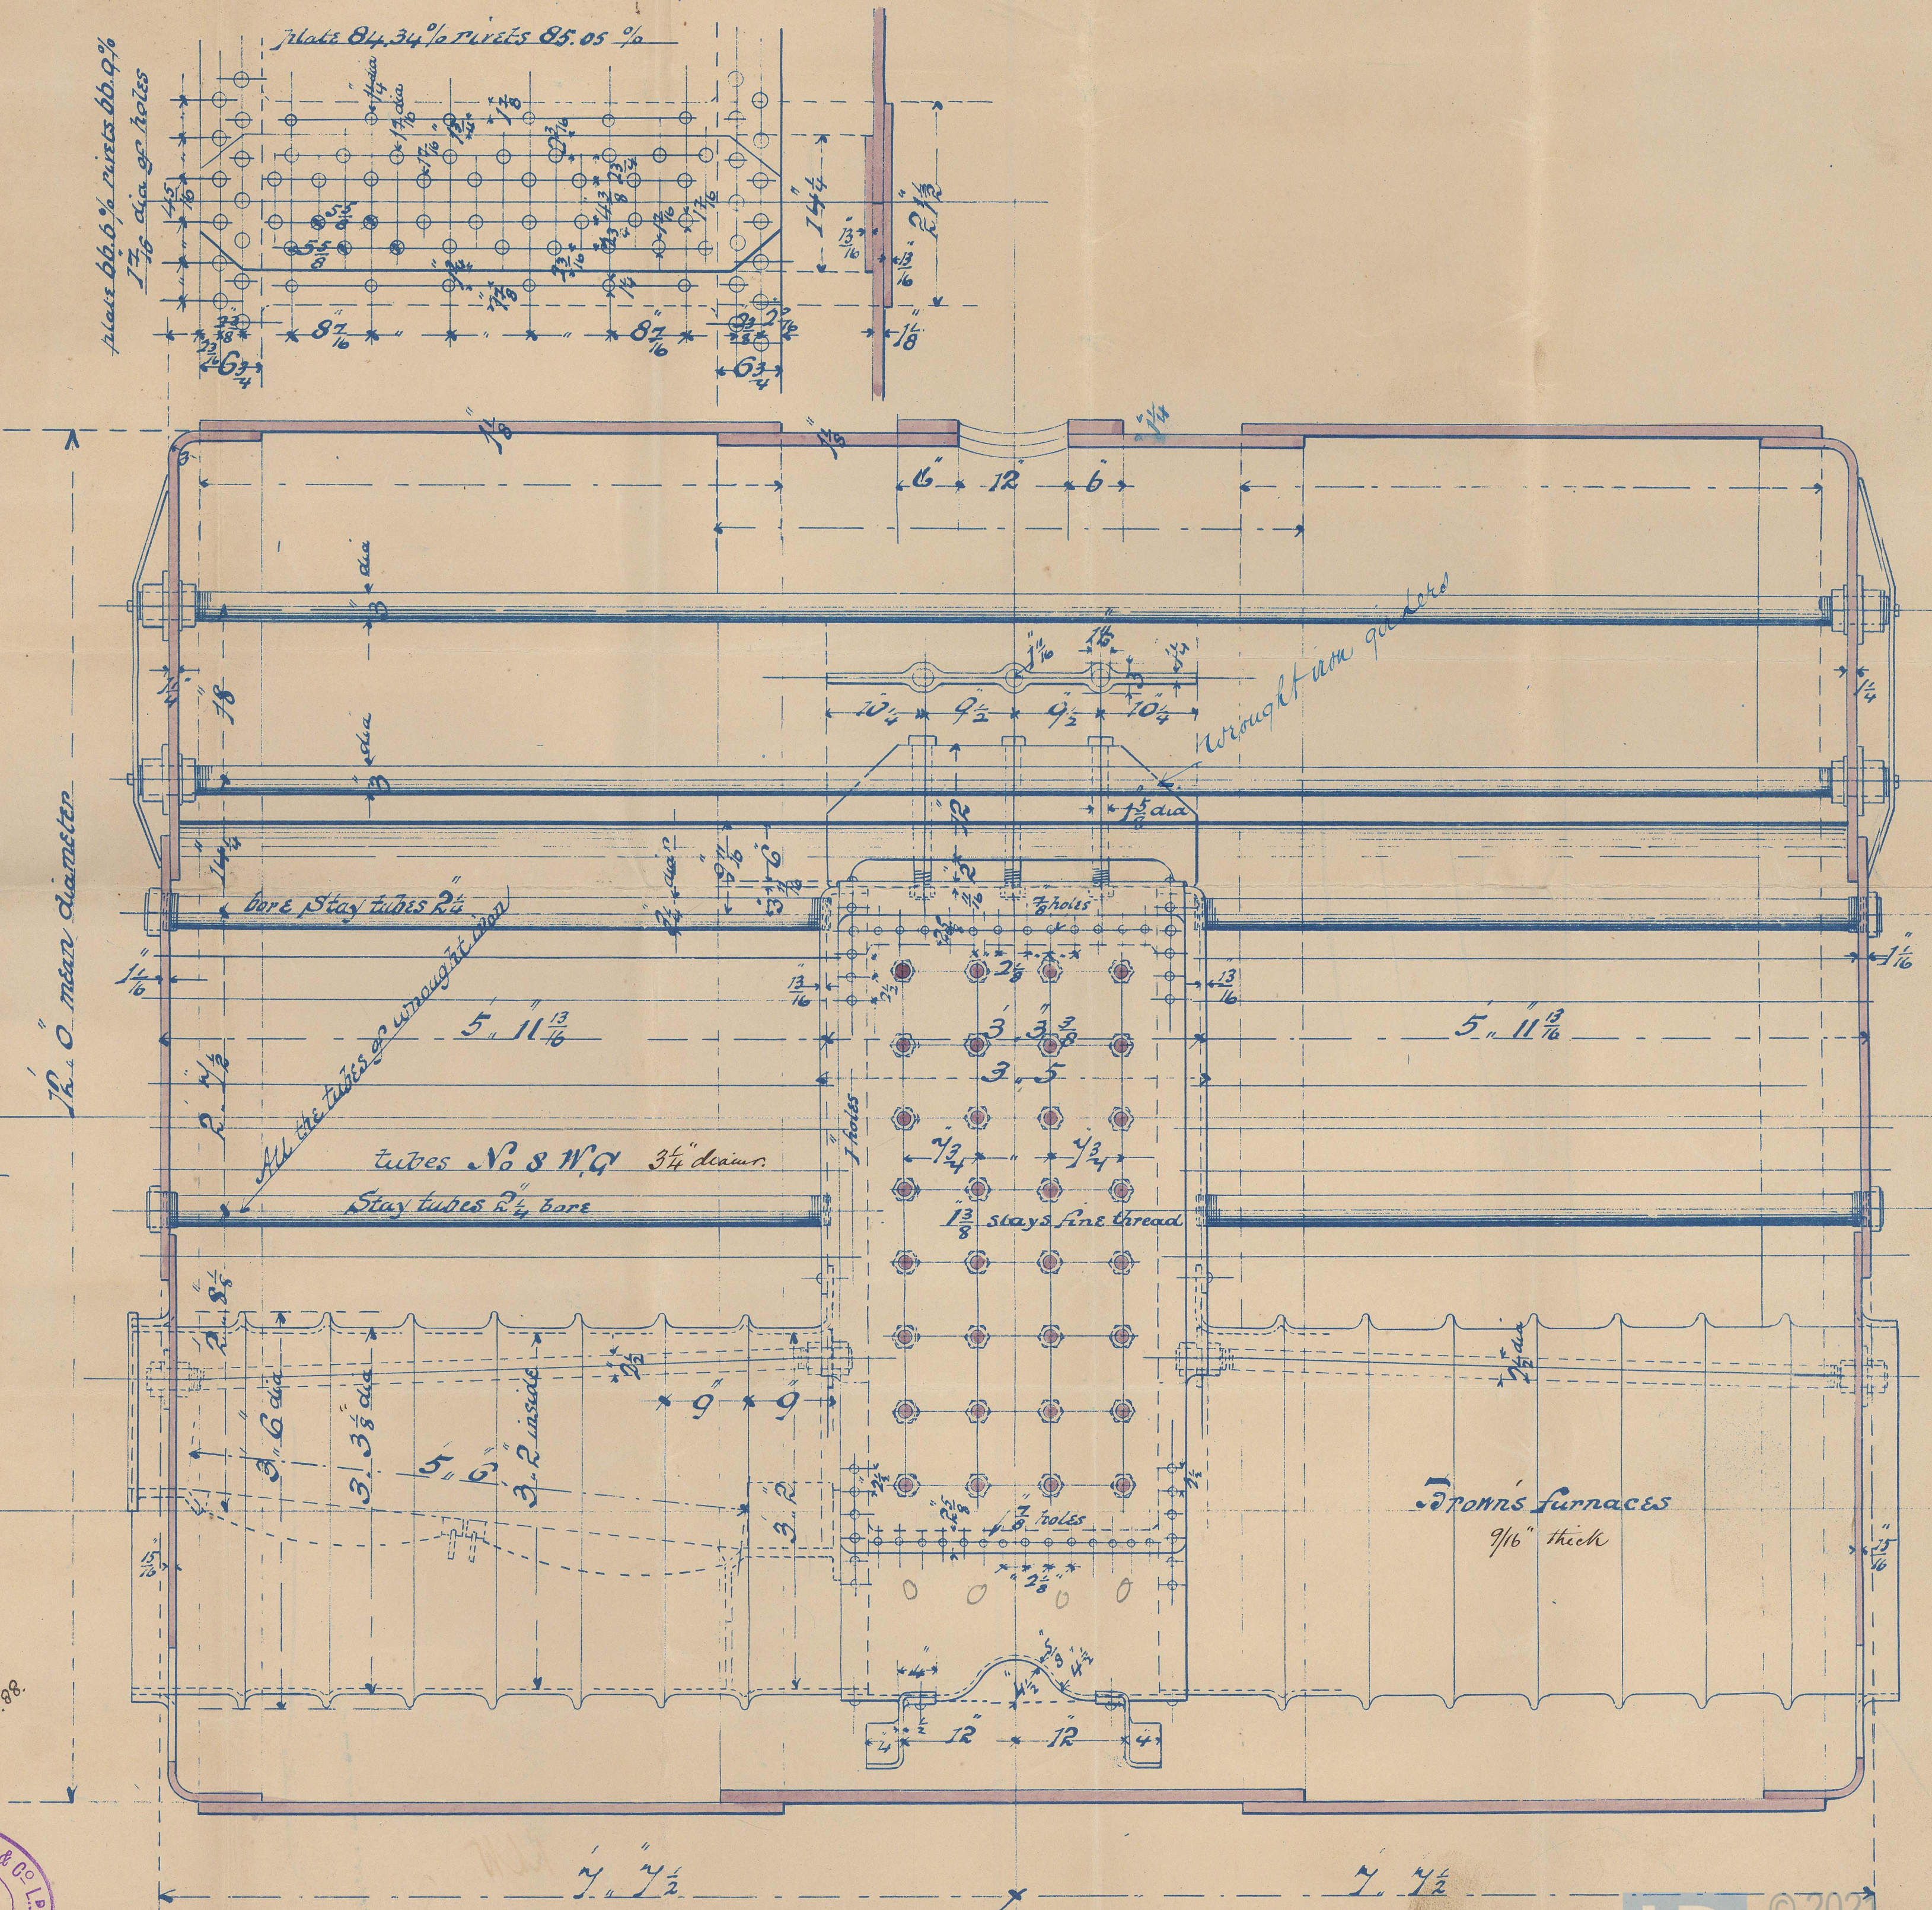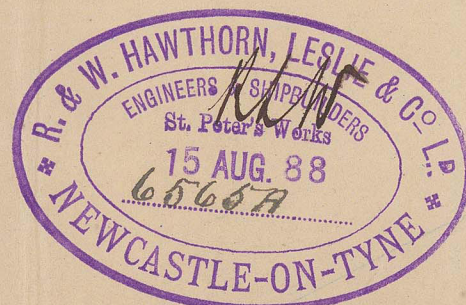



B.M. Hawthorn 287  
C. R. 2116 } 293  
2132 }

Hairshire "S.S."

No 2725  
Hops Ltd  
3200  
J F W  
2-2-89

Two Report No 2316H

Thoray shire "S.S."

No 3062  
Hops Ltd  
3200  
J F W  
6.12.89

2132

Two <sup>2</sup>bury Report No 23887



NW0813



© 2021

Lloyd's Register  
Foundation