

See letter to Rev.  
2/8/88.

MON 5 NOV 88  
8/8/84  
WED 6 NOV 89


# Midship Section for a Screw Steamer.

To be classed 100 A.1 Three Decked Steel.  
Long full poop and Top Gallant Forecastle.

Nº 287 Ship  
+ Nº 288 Ship  
+ Nº 293

Scale 1/2" = one Foot.

23<sup>rd</sup> JULY/88

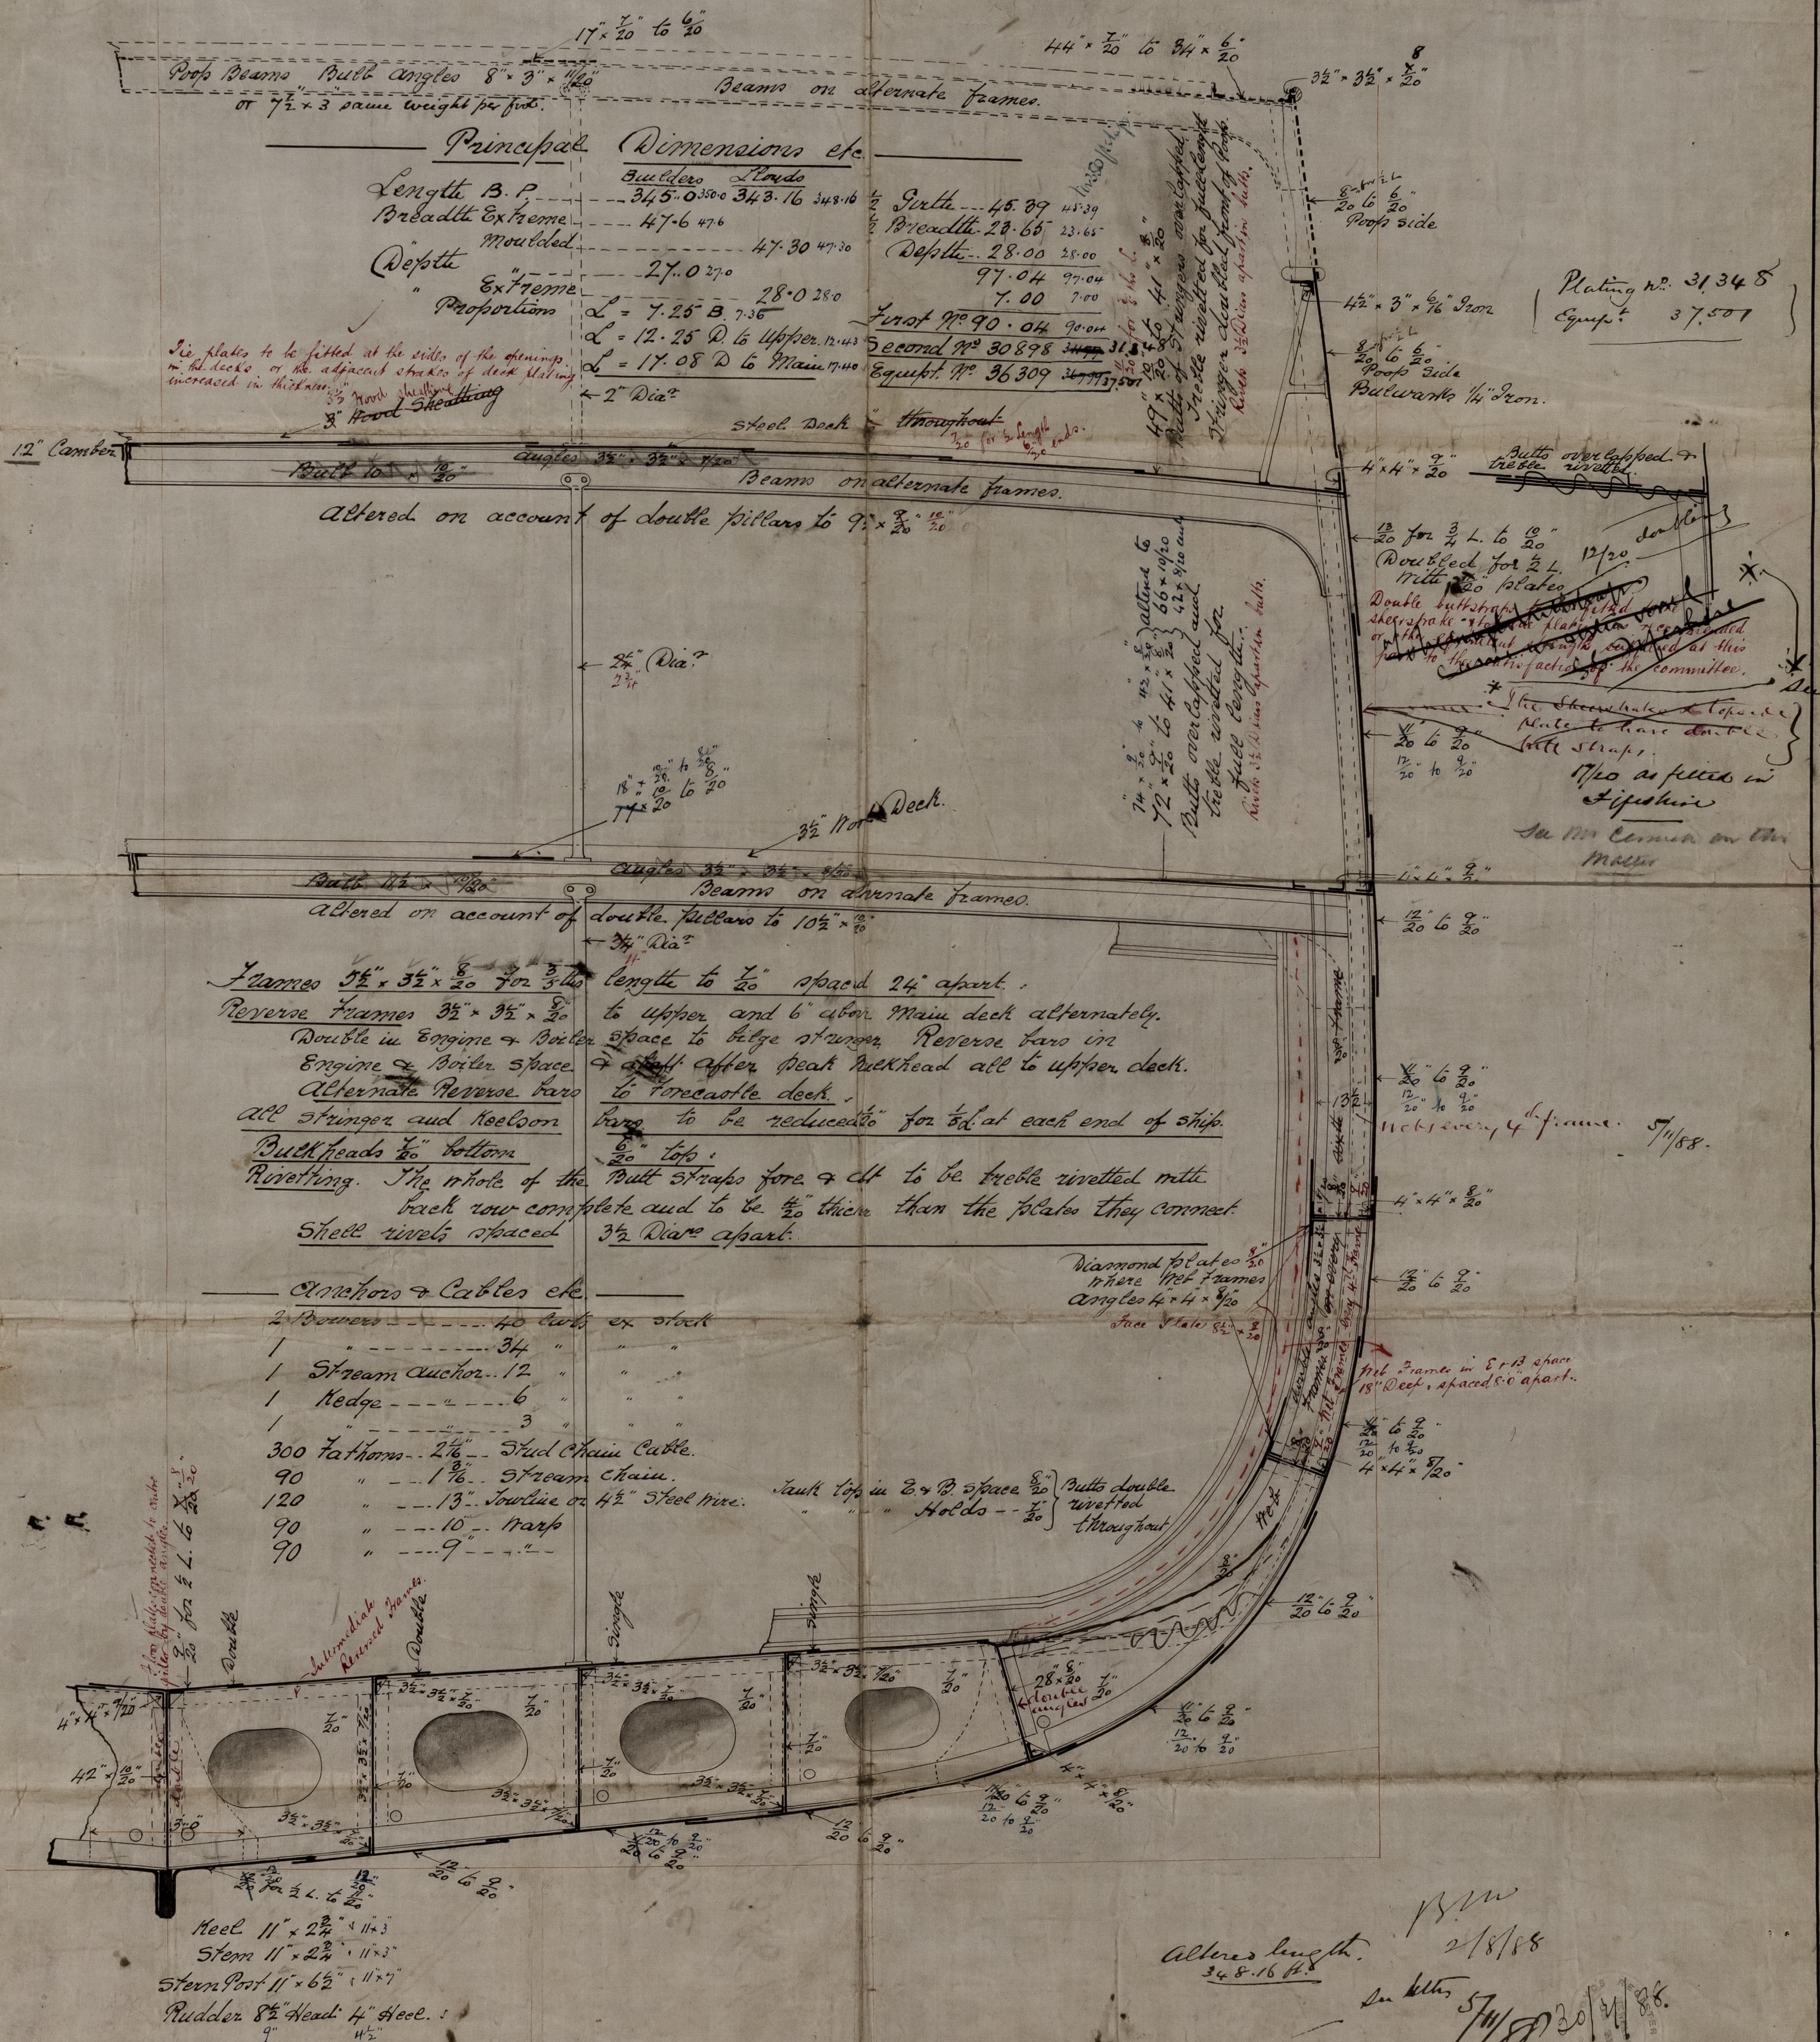




RECEIVED  
11 OCT 83  
LLOYD'S REGISTER

Morayshire  
Nwe - 23857

RECEIVED  
11 OCT 83  
LLOYD'S REGISTER

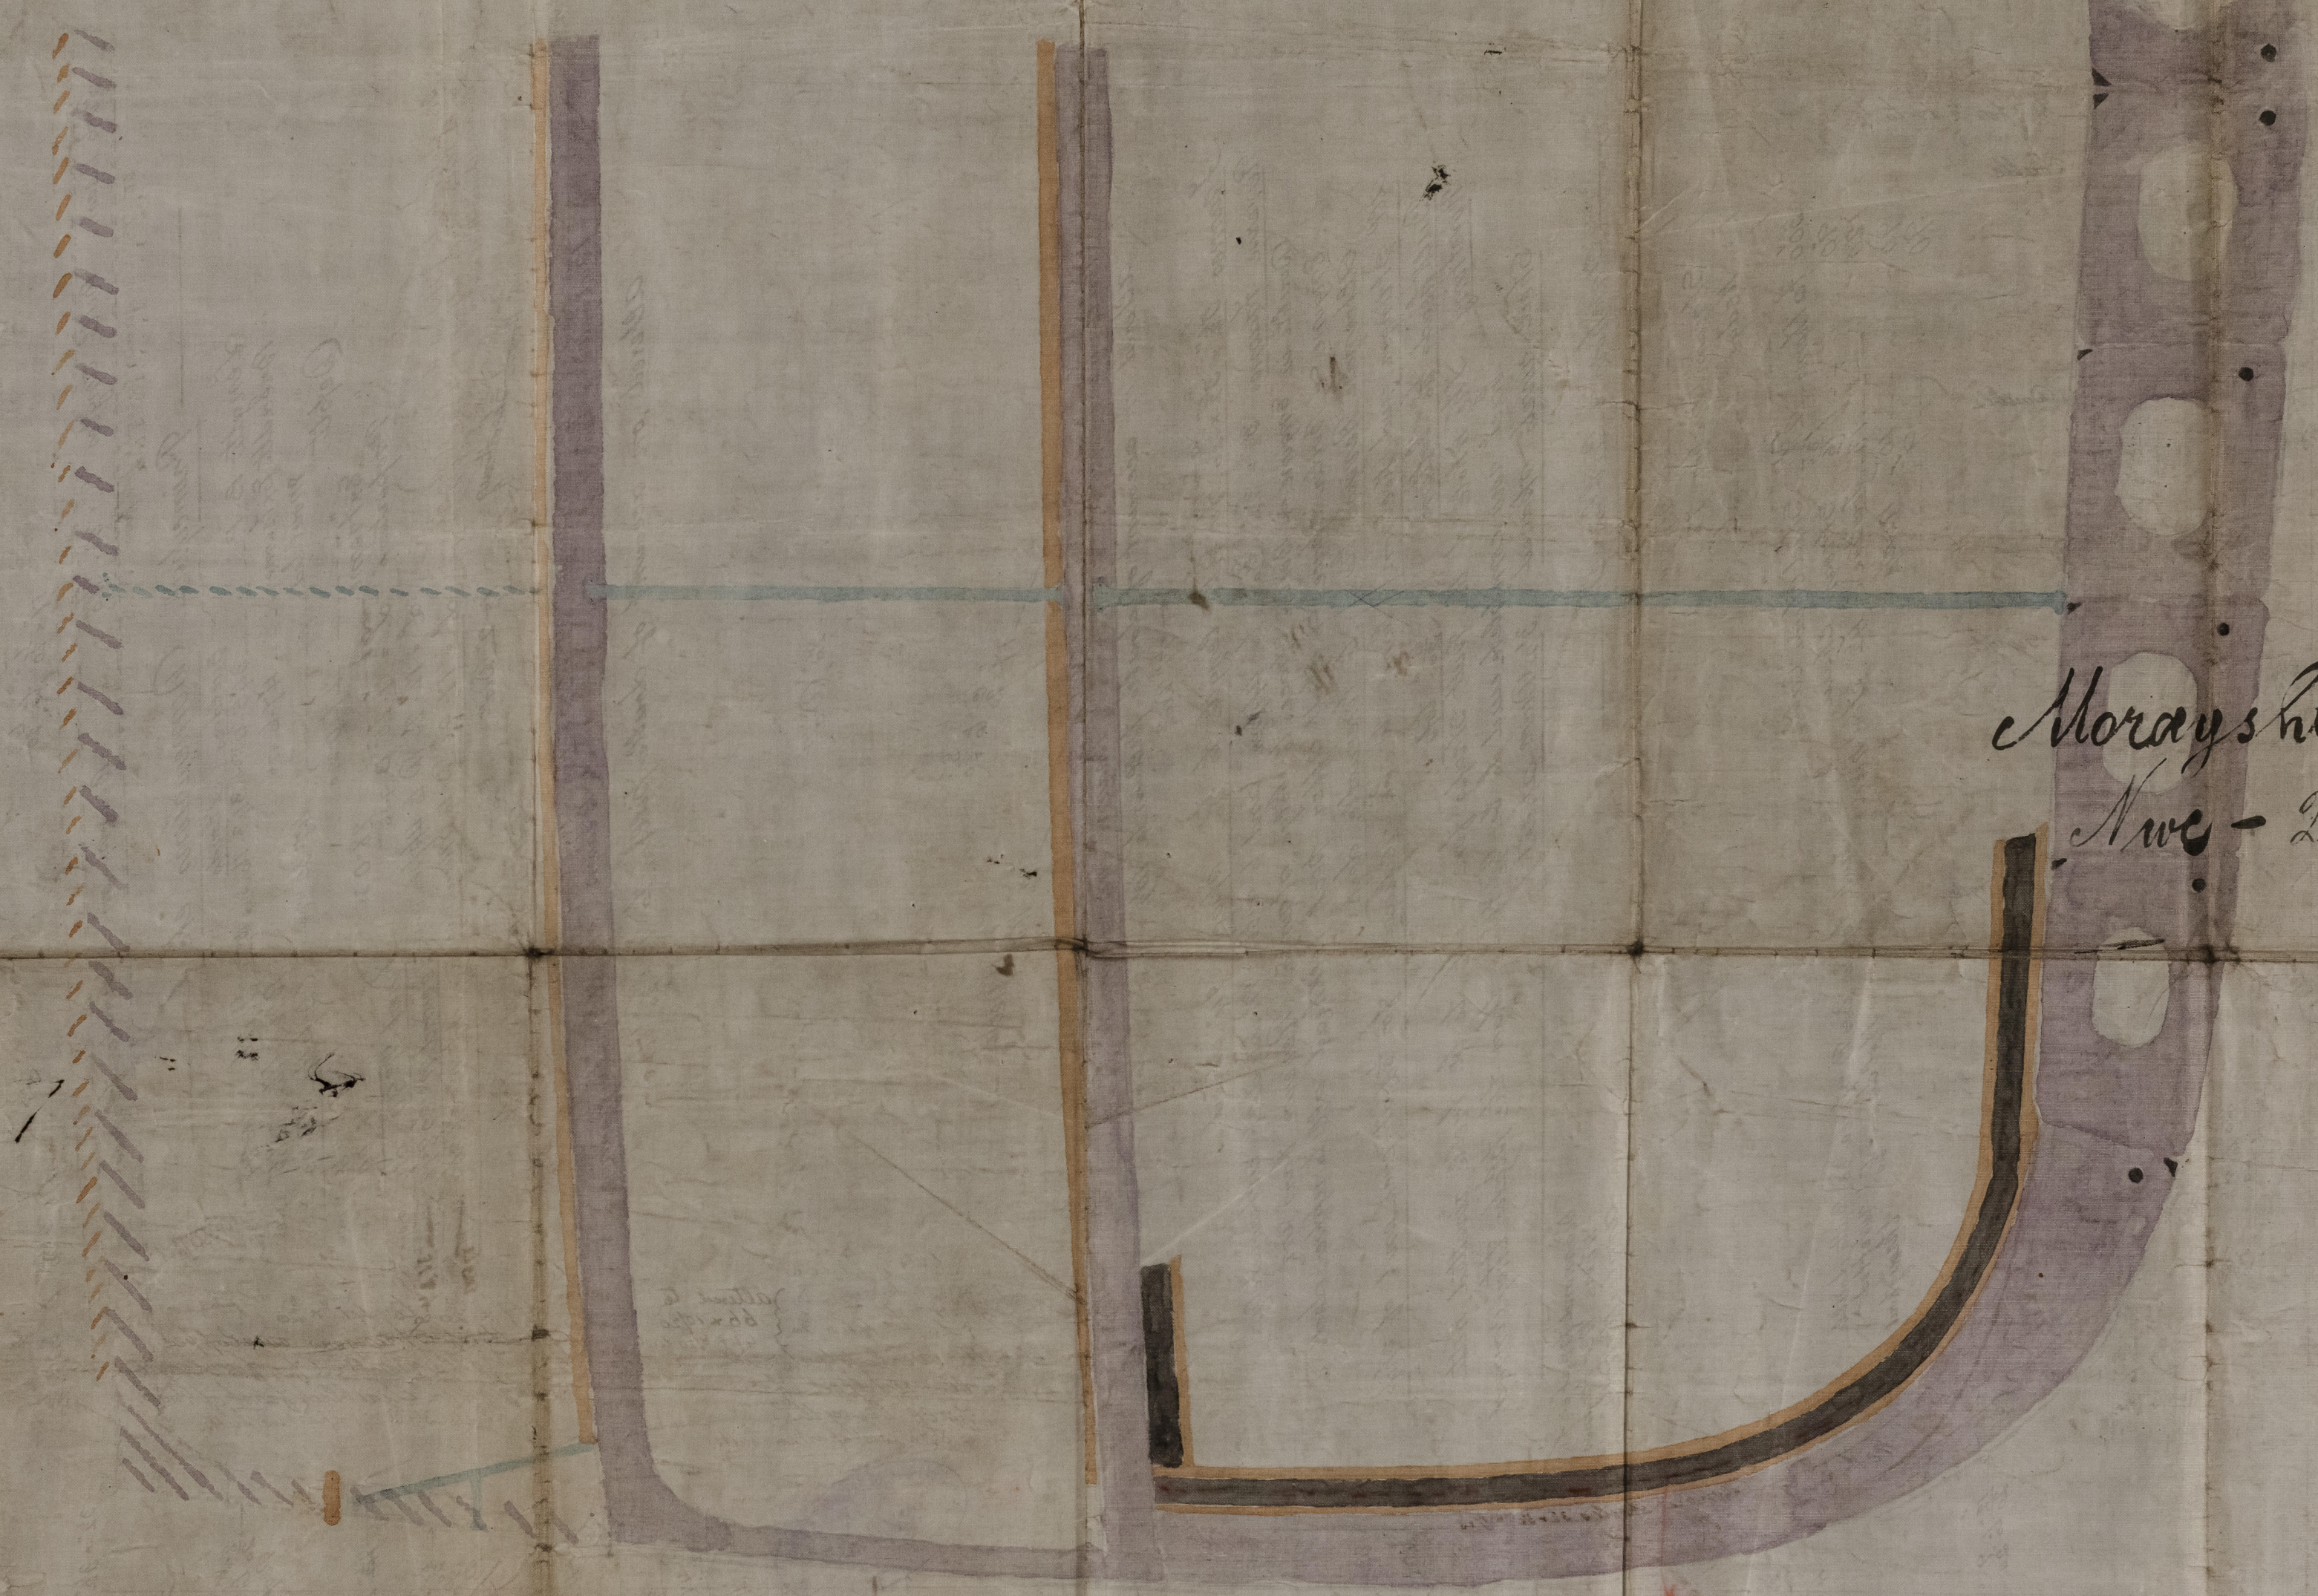

18/84

10/5/83

RECEIVED  
29 OCT 83  
LLOYD'S REGISTER