

THU 2 MAY 89
MON 18 MAY 89

Midship Section No 238.

Length between perpendiculars 300'-0"
Breadth Moulded 40'-0"
Depth Moulded 23'-0"

Scale 1/2" = 1 Foot.
To Class 100. A.1. Lloyds.
Raised Quarter Deck
Steel Scantlings.



SS Horby Grange
Nov. 23895.

Lloyds No.
1/2 Moulded Breadth 20.0
1/2 Birth 39.91
Depth 23.83
53.744 = 1st No.
298.34
24983.36 = 2nd No.

Proportions
Breadth to Length 1/4.46
Depth to Main Dk 12.51
Equipment No.
24983 + 3123 = 28106

Register Tonnage Under Deck
about 1950

Detail Sketch of Diamond Plate
1/2" Scale

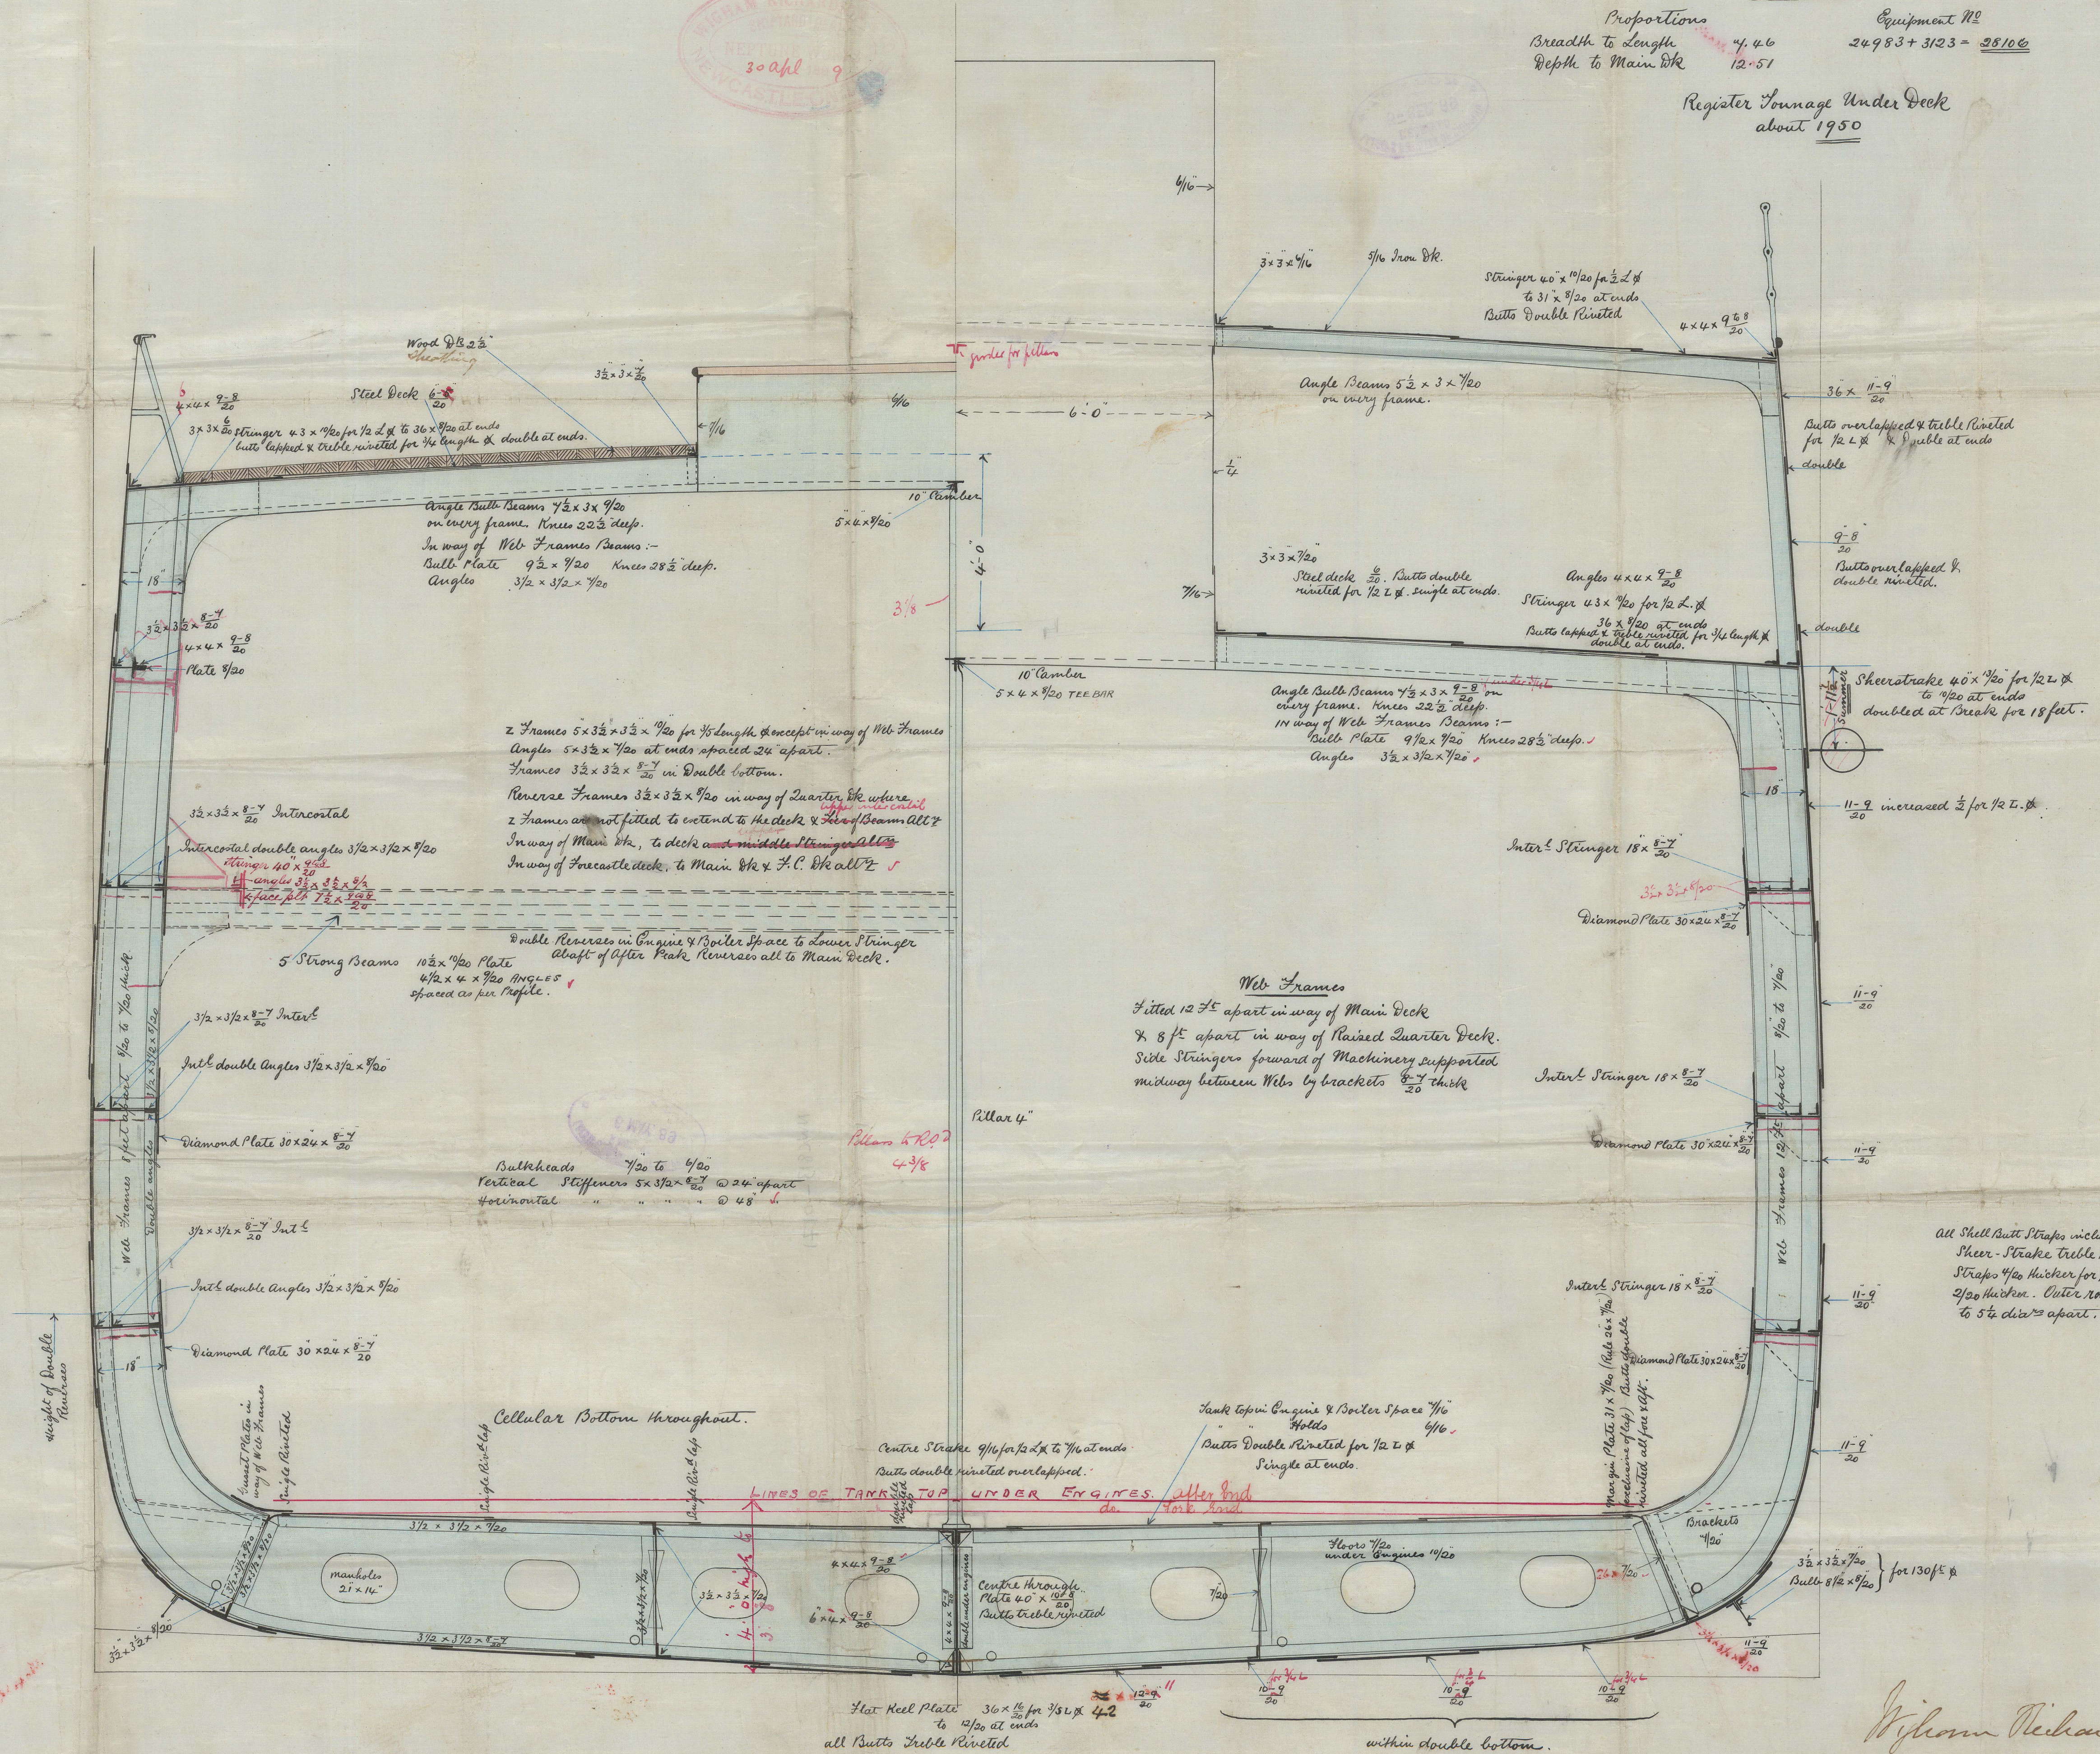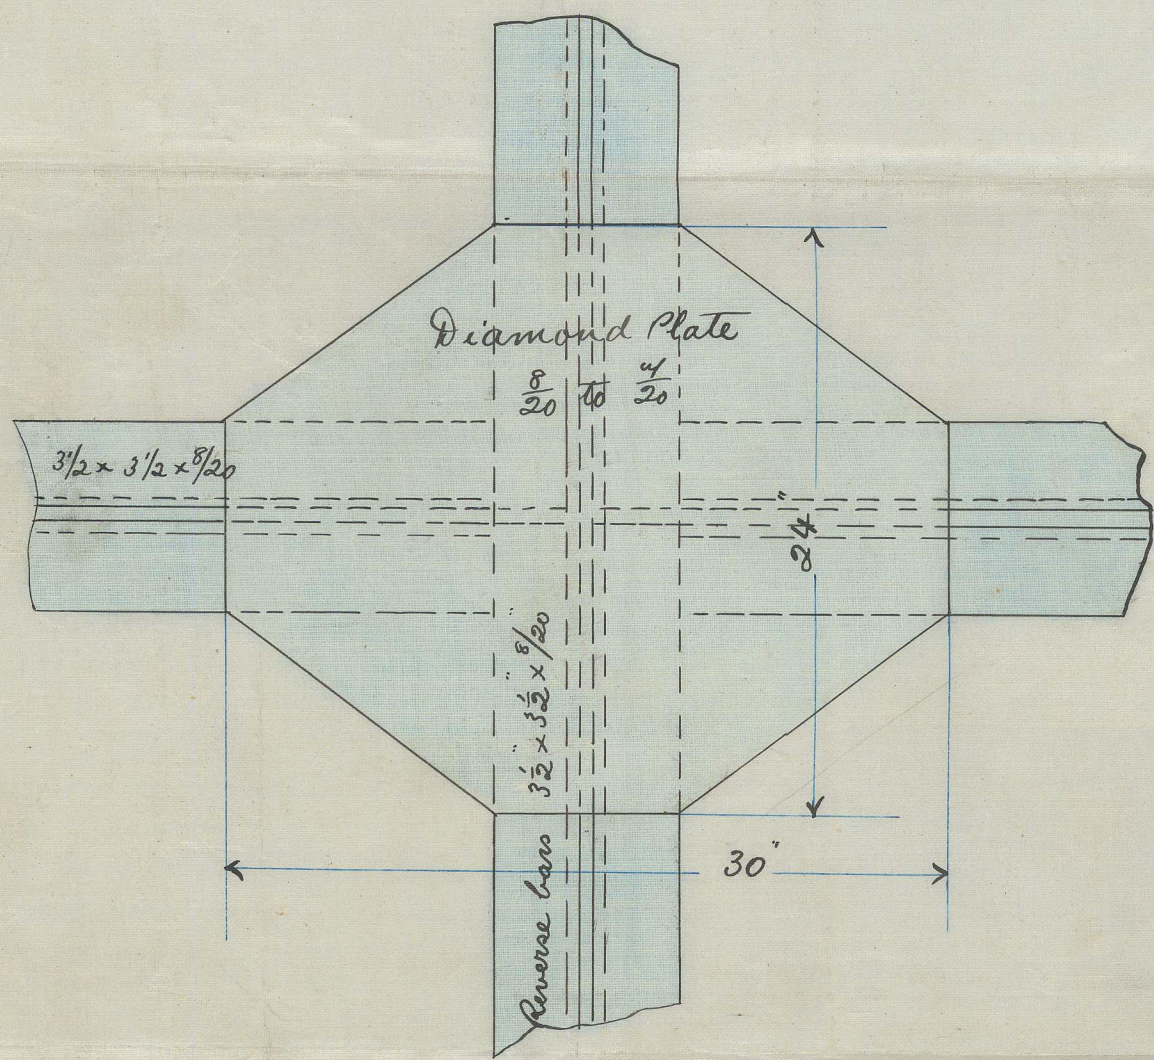

All Shell Butt Straps including Sand & Main Sheer - Strake Triple Riveted for full length & Straps 1/20 Hooker for 1/2 length remainder 3/20 Hooker. Outer row of rivets spaced 5 to 5 1/2 dia apart. Centers.

W. Richardsons
Newcastle on Tyne
30 April 1899.

NWC813-0171

6 MAY. 89

© 2021

Lloyd's Register
Foundation








NWC813-0171

15/10/1911


53-0
100-0
300-0

1886. Sept 2.

© 2021

Lloyd's Register
Foundation