

W. 5.9.89


S. J. Stanley Grange - Inc. 1st Survey Report No 23890
238 Ship.

Pumping Arrangement.

Scale 1/2" = 1 Foot.



P.A. 2.9.89

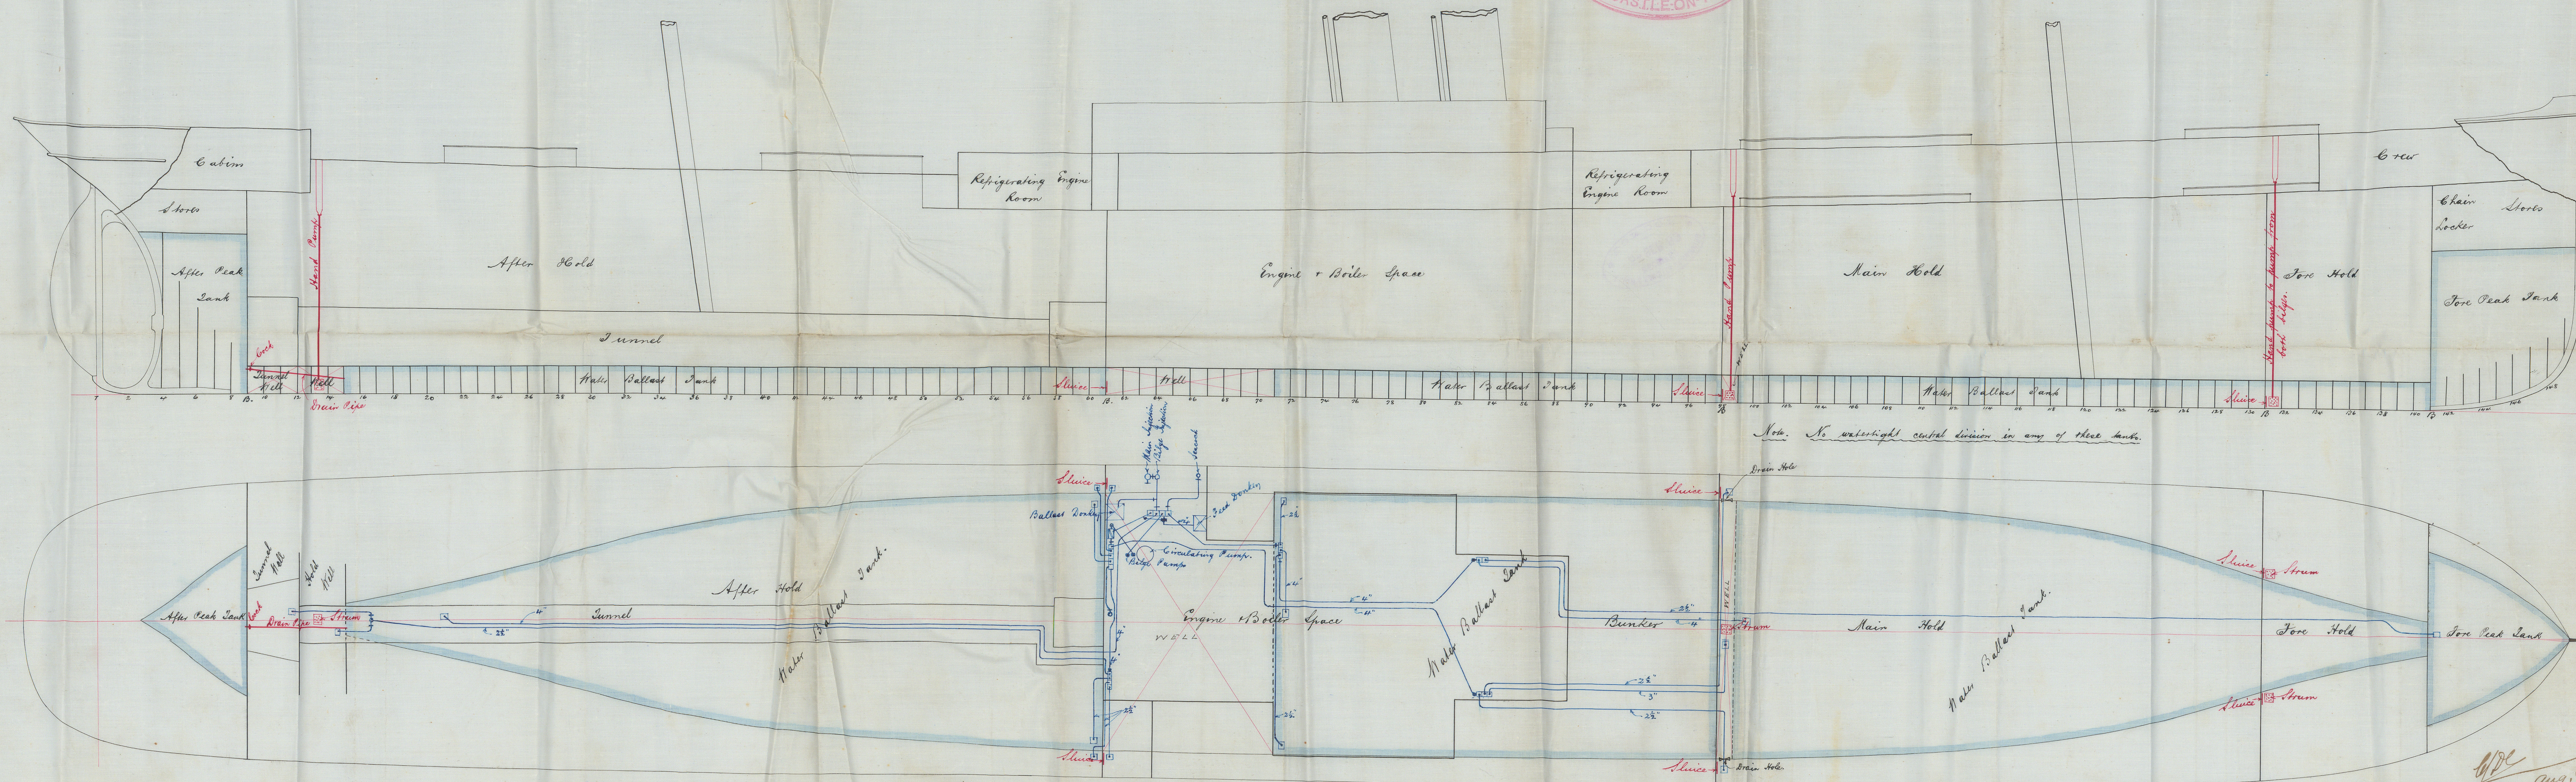

Note. No watertight central division in any of these tanks.

W.A. 3.9.89

W.A. 2.9.89