


ALL PLATES AND RIVETS OF STEEL

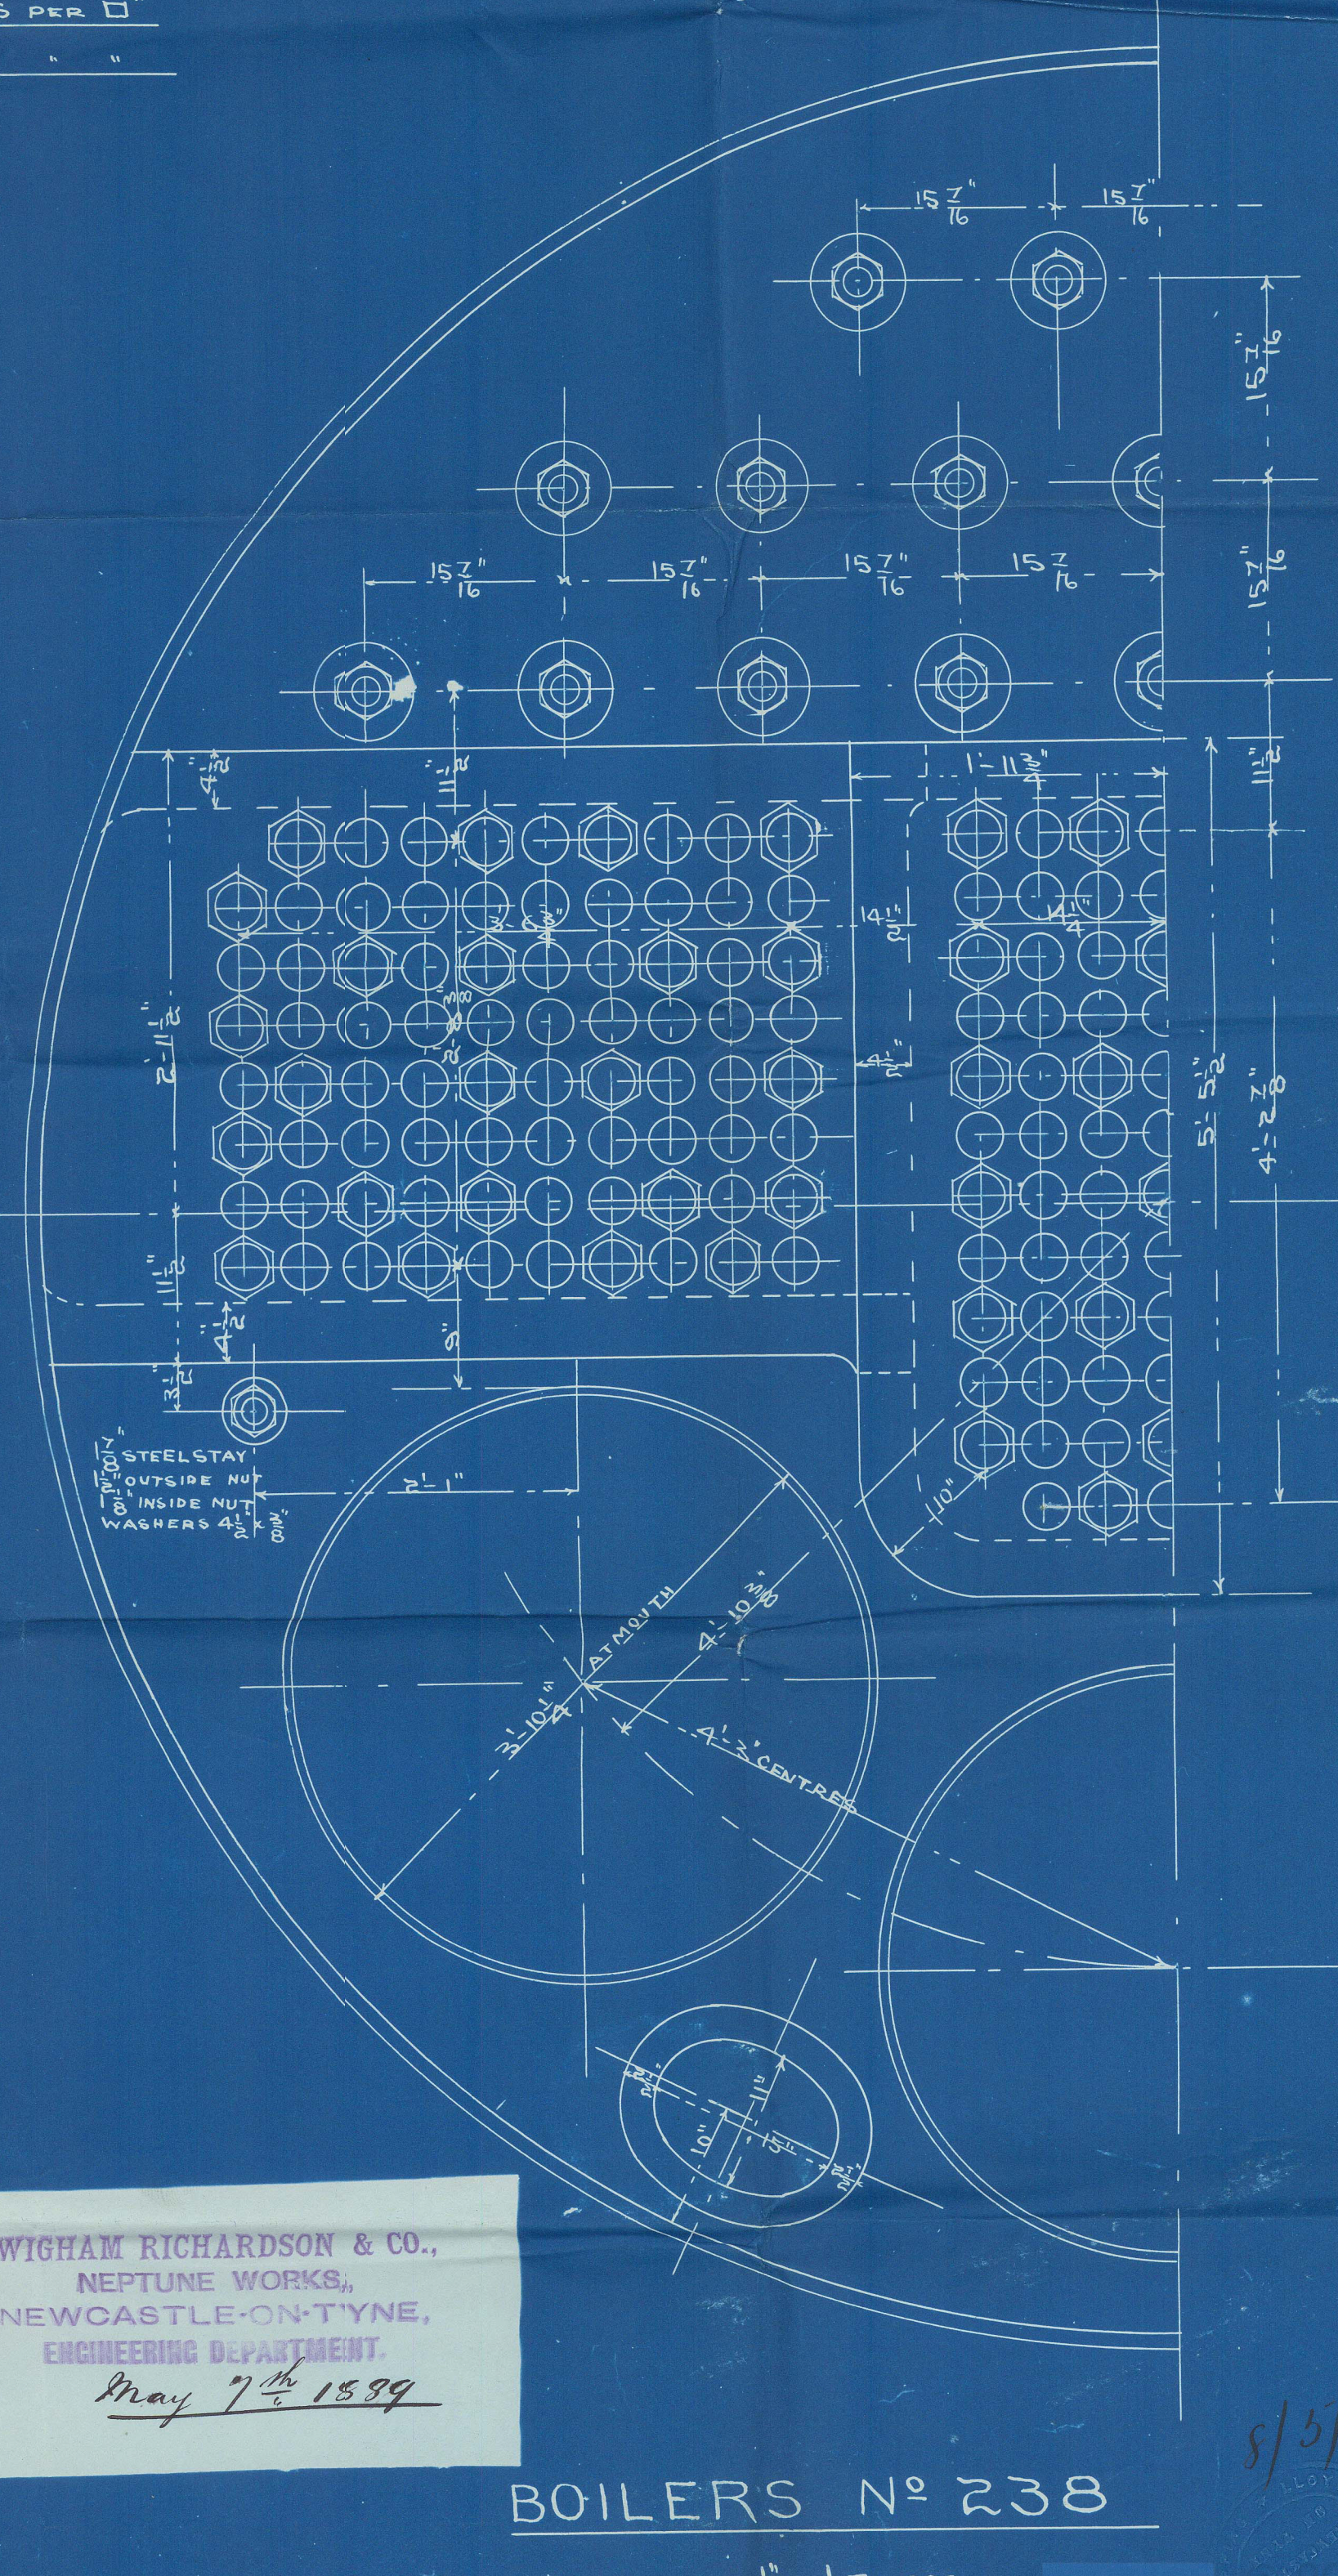

WIGHAM RICHARDSON & CO.
NEPTUNE WORKS,
NEWCASTLE-ON-TYNE,
ENGINEERING DEPARTMENT.
May 7th 1899

BOILERS N° 238

SCALE 1" = 1 FOOT

• 3. THUS




3-0177
Lloyd's Register
Foundation

S. S. "Hornby Grange"
No Report No 23895

W. C. Co 238
H. P. 1504

No 3044
Lgds test
300 lbs
15. 11. 89

NWC813-0177

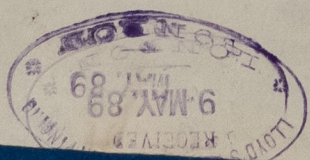

© 2021

Lloyd's Register
Foundation