


S.S. Presidia No. 1 Entry Report No. 119

S.S. No 258.

CLASS 100.A.1.

BRIDGE DECK

QUARTER DECK

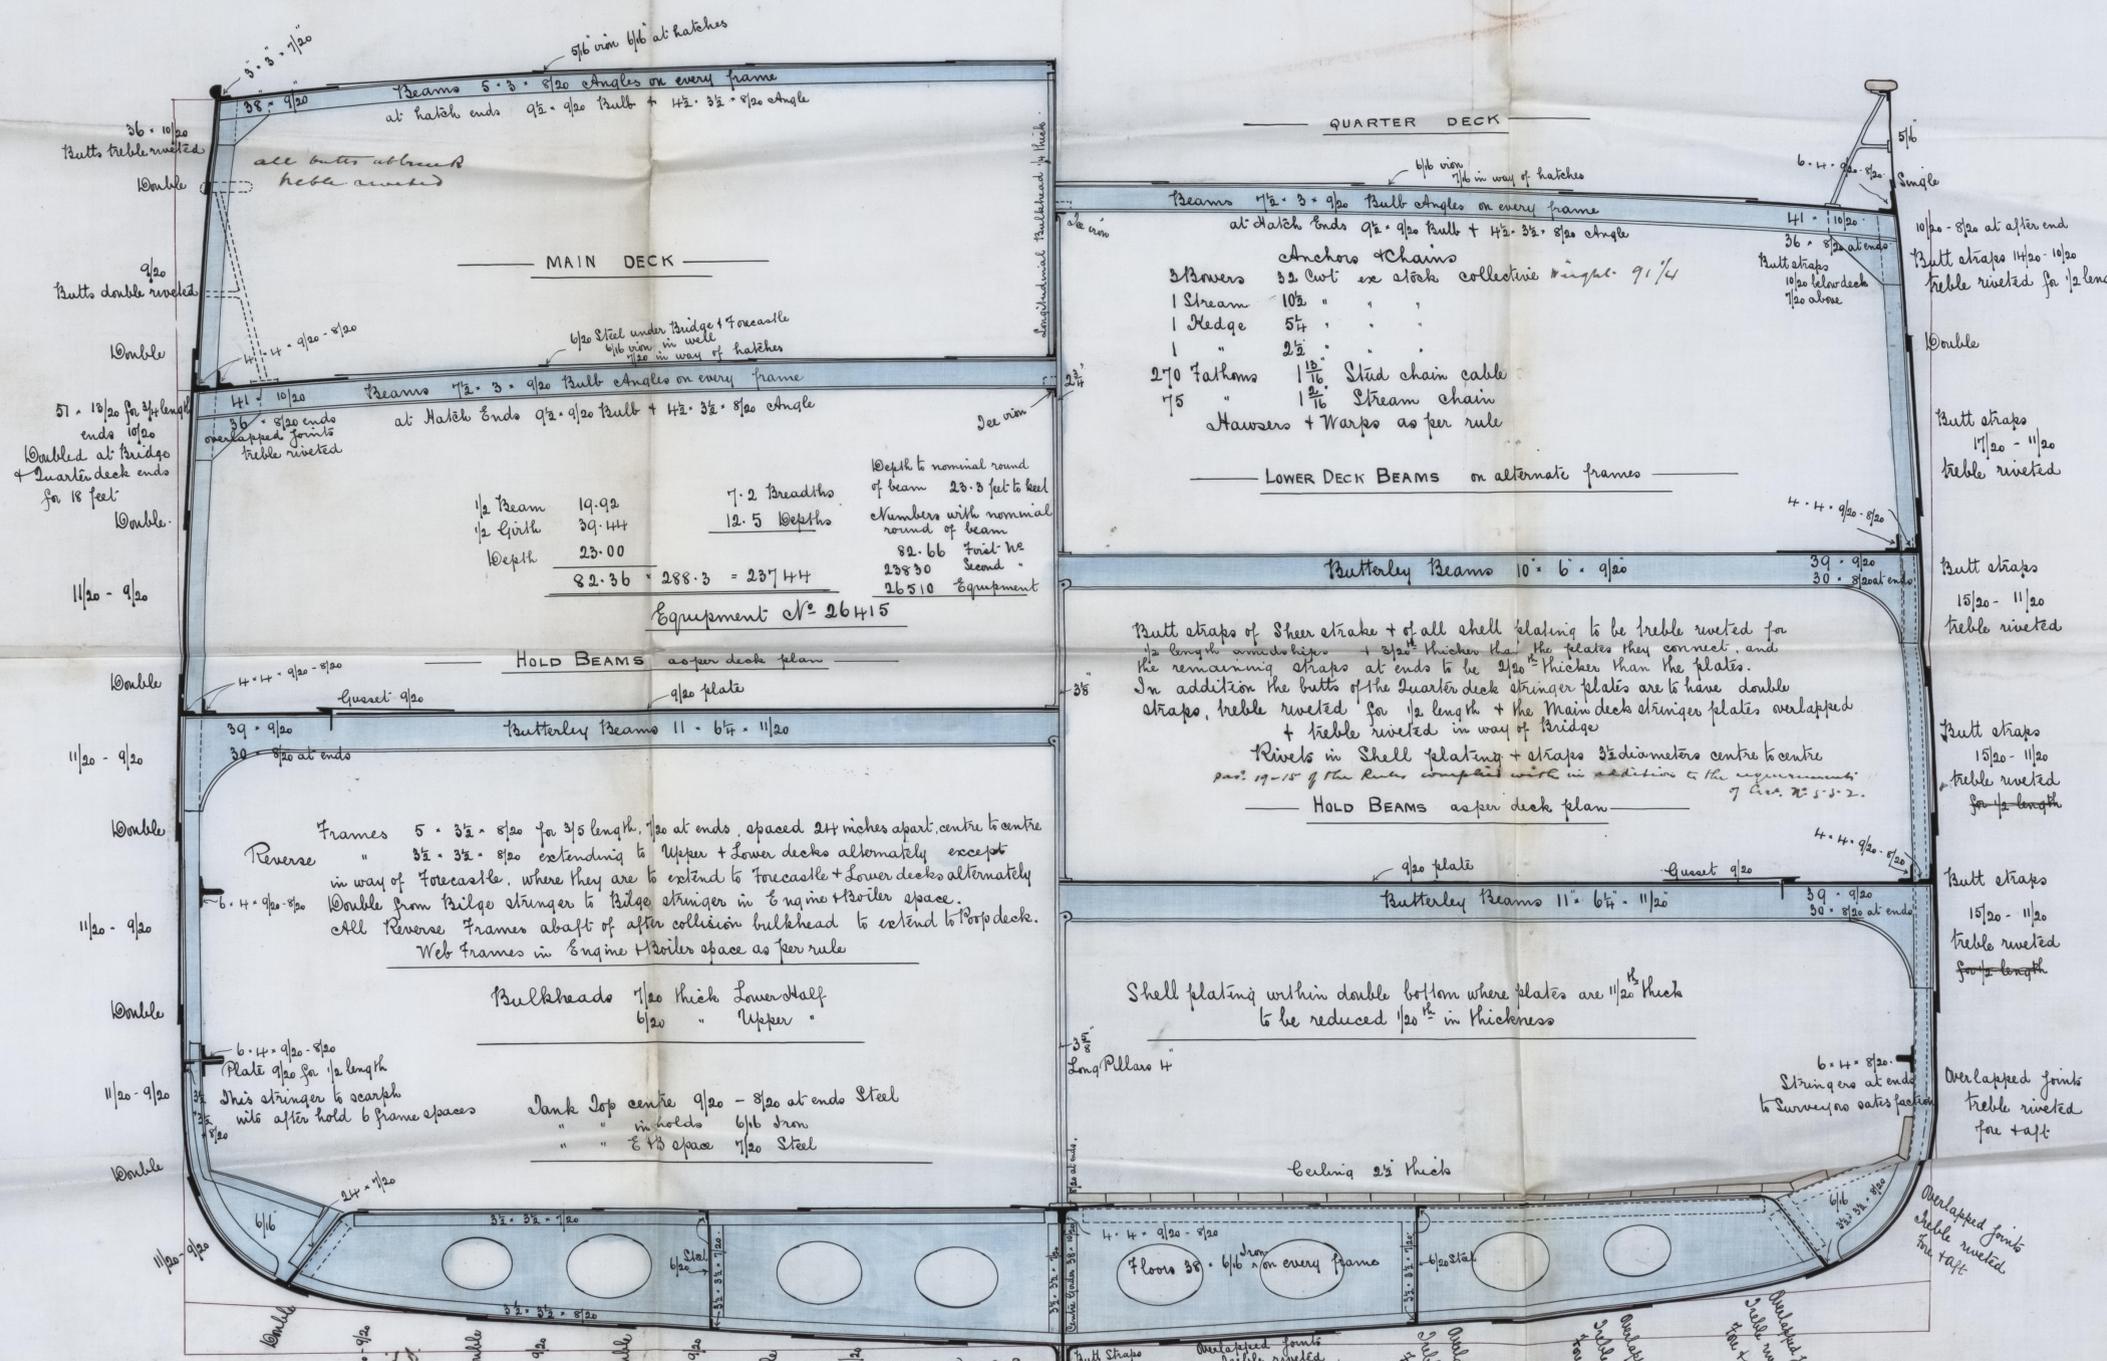

ANCHORS & CHAINS
 Hawsers + Warps as per rule

Equipment No 26415


Butt straps of Sheer strake + of all shell plating to be treble riveted for 1/2 length...
 Rivets in Shell plating + straps 3 diameters centre to centre
 per 19-15 of the Rules applied with in addition to the requirements of Art. 23-3-2.

Shell plating within double bottom where plates are 1/2" thick to be reduced 1/20" in thickness

4 floor 38" dia 6/16 on every frame

JOHN READHEAD & SONS,
 Engineers, Boiler-Makers
 Iron & Steel Shipbuilders
 SOUTH SHIELDS.

NWC814-0164