

"British Queen"

Received at

Office.

18

Lloyd's Register of British and Foreign Shipping.

(Report on Vessel No. *24273* Port *Newcastle*)

No. *243*

SHIP FORGINGS OR CASTINGS.

I have to report that the undermentioned Iron ~~or Steel~~ Forgings ~~or Castings~~, manufactured by *The Palmers S B Co* of *Jarrow* for the Vessel No. *642*, being built by *The Palmers S B Co* of *Jarrow* have been inspected by me as set forth below, and found to be, so far as can be seen, *sound*

The words FORGINGS or CASTINGS, IRON or STEEL, should be struck out as may be required.

Mark on Forgings.

Lloyd's
No. *38B*
76


John C Craig

Newcastle

15/4/90

	STERN FRAME.	RUDDER FRAME.	STEM.
Material*	<i>Scrap iron</i>	<i>Scrap iron</i>	
How made	<i>Forged</i>	<i>Forged</i>	
Dimensions	<i>11 - 7 1/2</i>	<i>10 - 5</i>	
Progress on Inspection	<i>Forged & Smithed</i>	<i>Forged & Smithed</i>	<i>Not seen</i>
Dates when Inspected	<i>Oct 7-8-14-20-29</i>	<i>January 8-13-21-27</i>	
	<i>November 5-8-18/89</i>	<i>February 3-10-18-21/90</i>	

SKETCHES OF FRAMES SHEWING POSITION AND DESCRIPTION OF WELDS OF FORGINGS, OR PARTICULARS OF TESTS APPLIED TO CASTINGS.

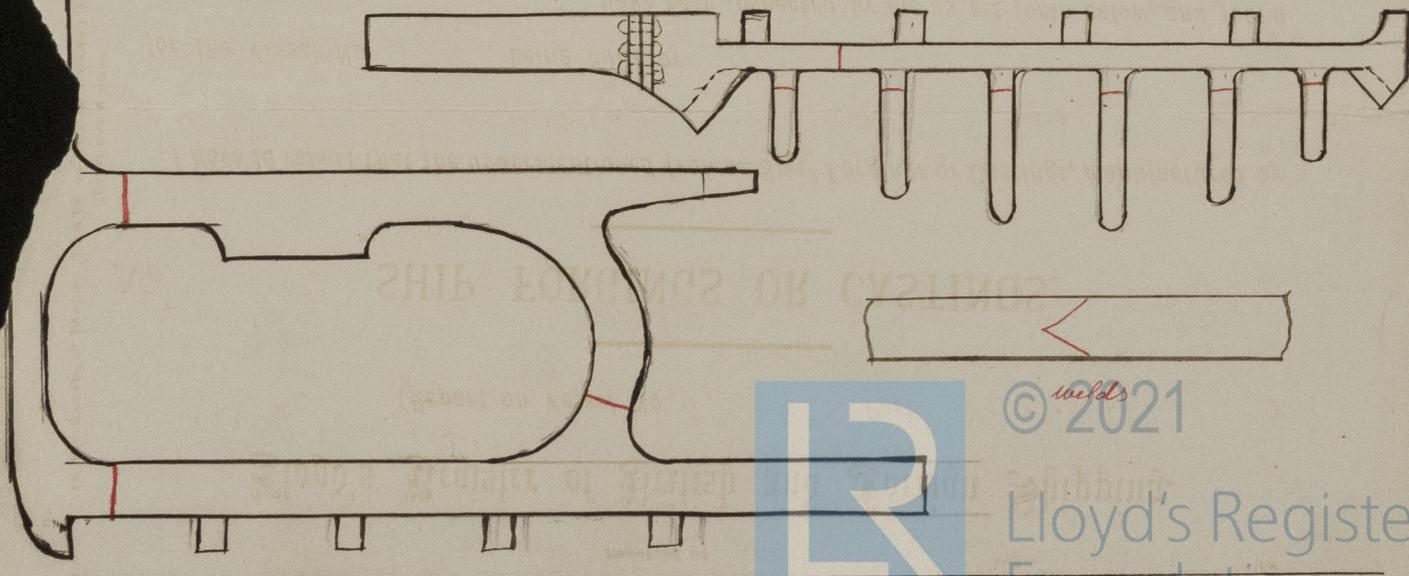

James Skelby
No 642




© 2021

Lloyd's Register
Foundation