


Dec 17. 1. 90



Sec. St. British Lucca No 1 Entry Report No 2024/3

No 642 PUMPING PLAN

SCALE $\frac{1}{8}$ INCH = ONE FOOT

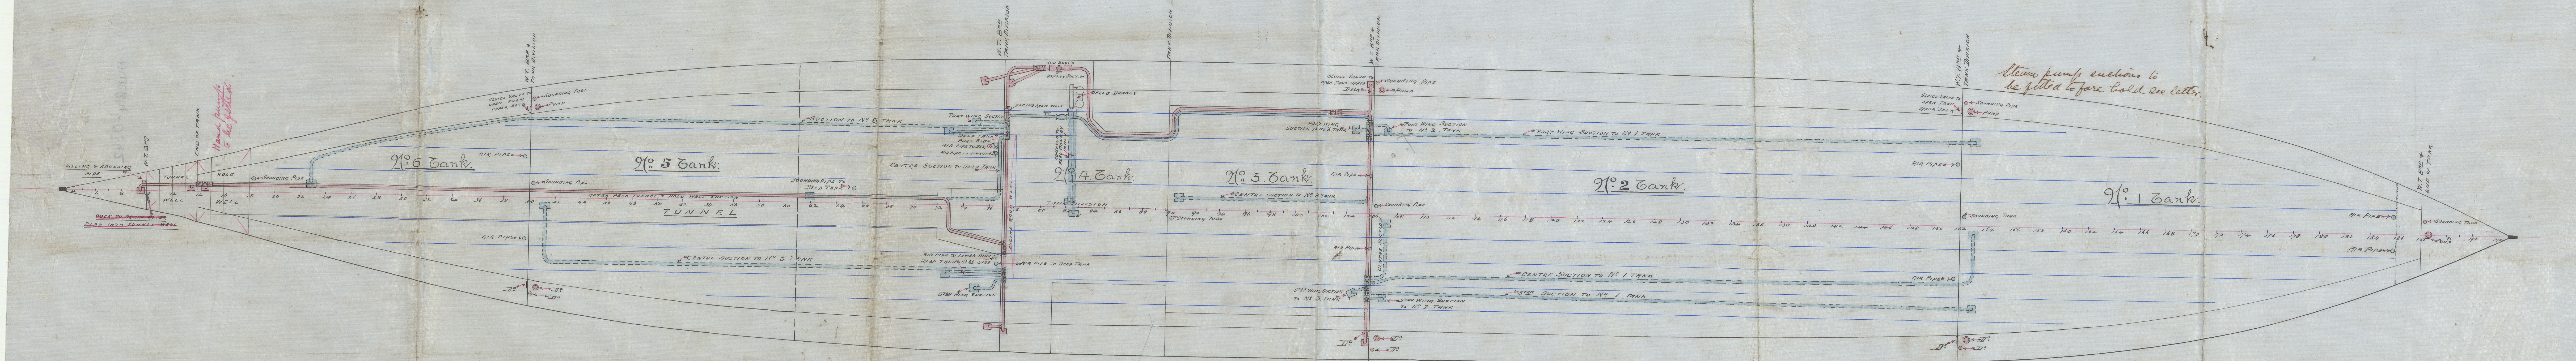

M.A. 17. 1. 90

Steam pump suction to be fitted to fore hold see letter.

NWC 814-0342

NWC814-0342

K₂

WART 40 DVA

3



24400

10

2

Lloyd's Register
Foundation