



Dec 5-7-92
 Revised 7-11-1892
 18-18-92

S.S. N° 181

SKETCH OF PROPOSED STRENGTHENING OF
 MAIN DECK AT FORE END OF BRIDGE

SCALE $\frac{1}{4}" = 1 \text{ FOOT}$

WEB FRAME
 9" x 9" BULB
 SINGLE $3\frac{1}{2} \times 3\frac{1}{2} \times \frac{7}{16}$ ANGLE

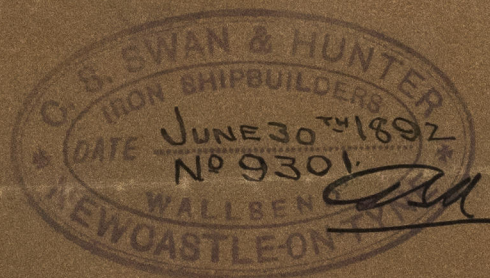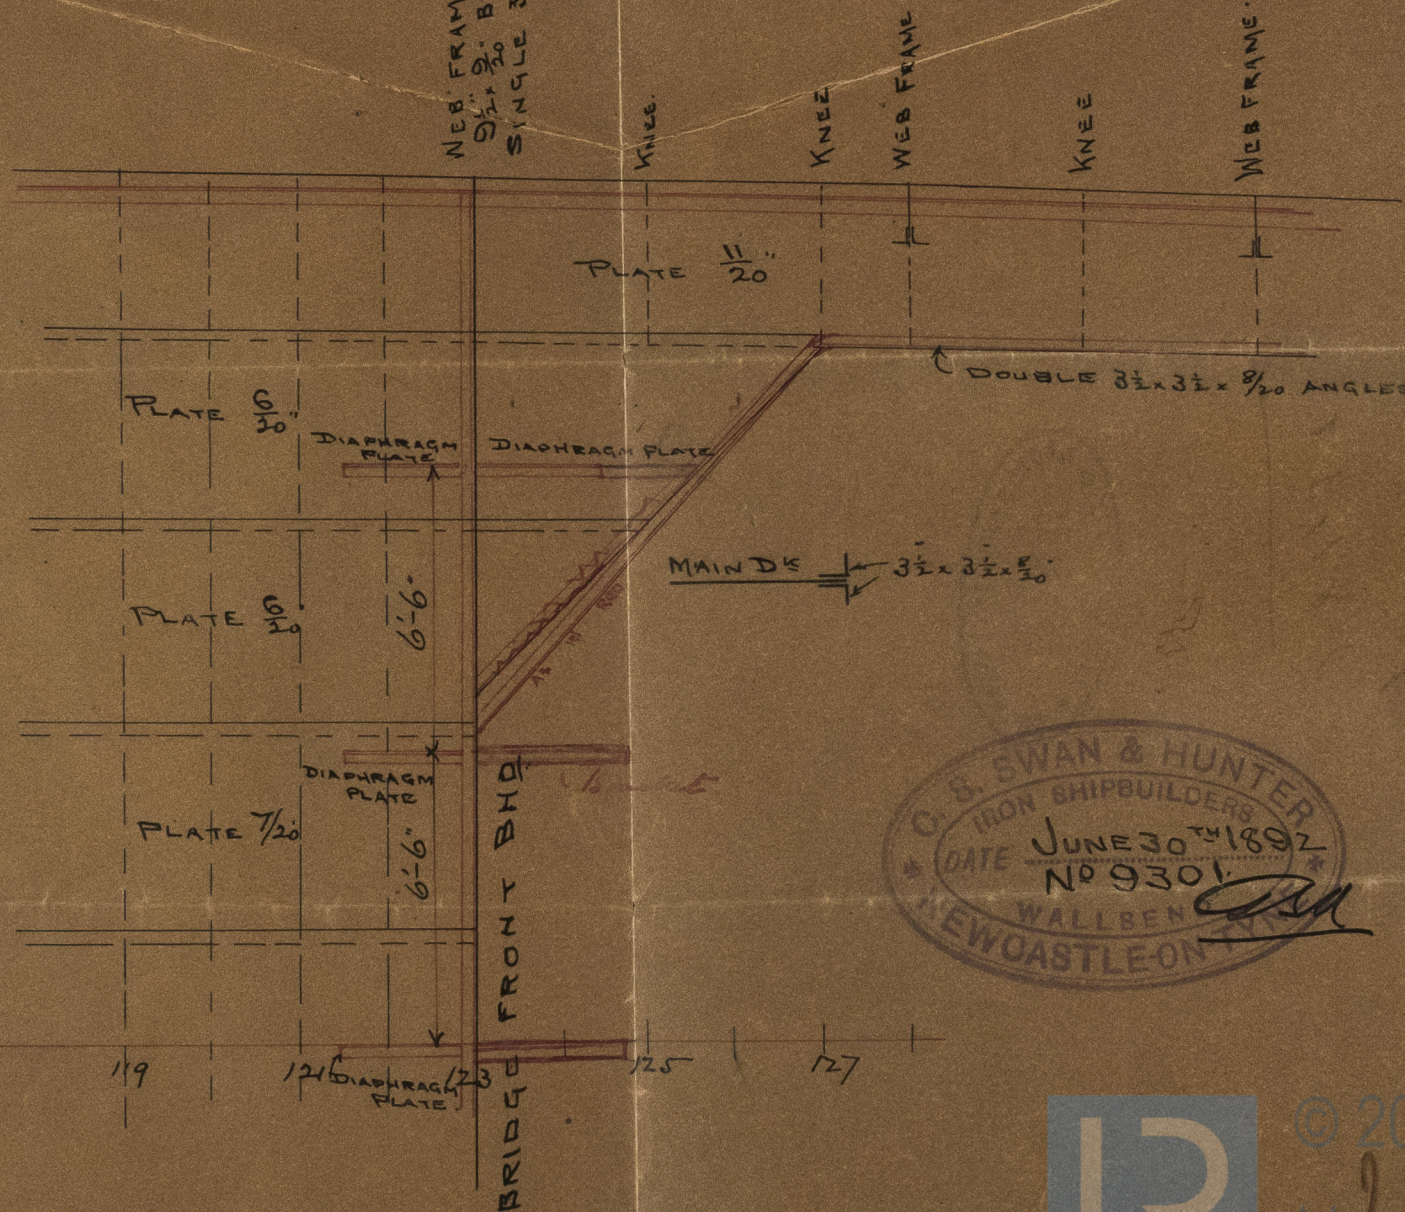

© 2021
 2/17/92
 Lloyd's Register
 Foundation

181


NW2316-0011

1/1 "Zeno"

Newcastle Report

10

281,500

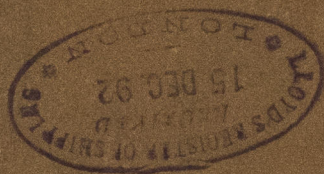

© 2021

Lloyd's Register
Foundation