
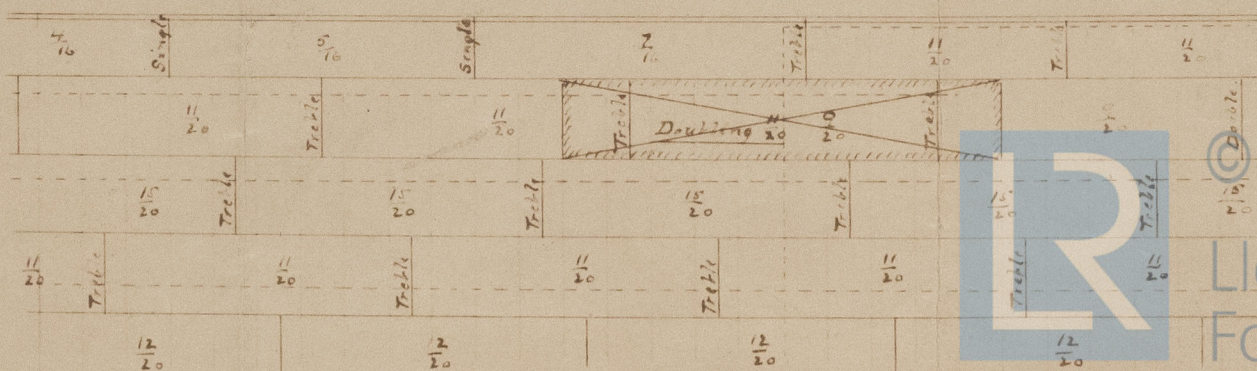


Scale $\frac{1}{8} = 1 \text{ Foot.}$

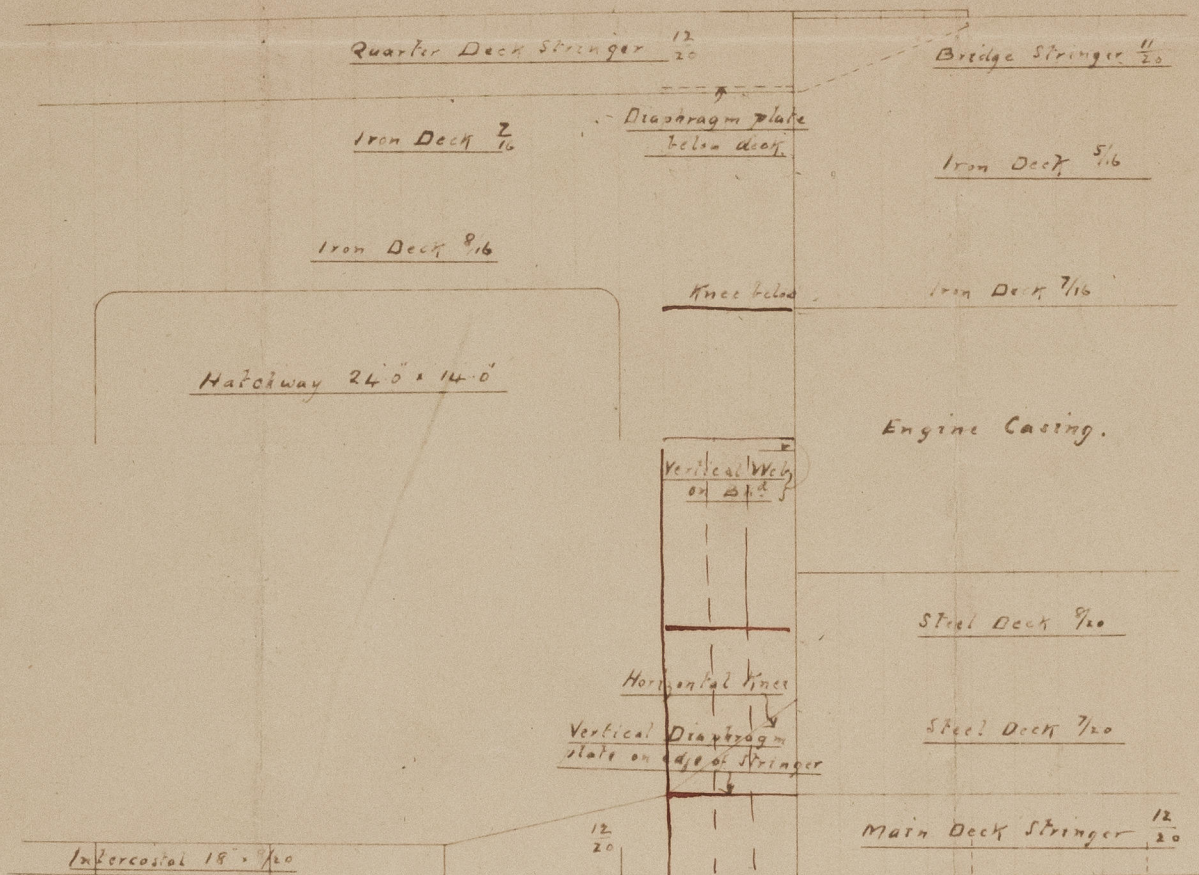

No 157

Strengthening at after break
Duplicate of Lloyd's

G. S. hi copy

Have 1st Entry Report
No 24420 on
S/s "Radnorshire"



© 2021

Lloyd's Register
Foundation