


S.S. N^o 157

PROFILE SHOWING ARRANGEMENT

of beams, webs, stringers &c.

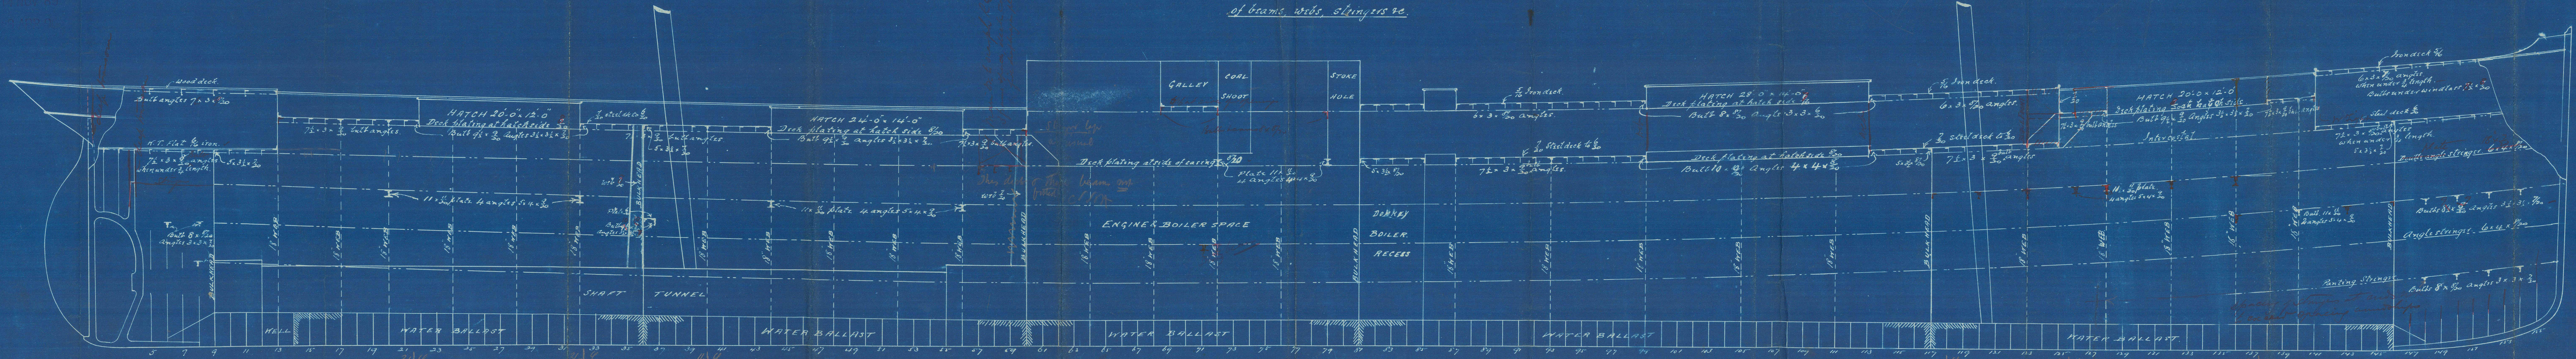

November 6th 1889
N^o 7647

157

London Profile


Swan & Kintners


Profile 157

Sew: Stm: "Raduotshin"

Uwe 1st Entry Report

No 24420



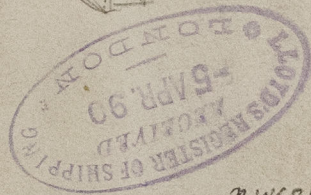

NWC816-0015



© 2021

Lloyd's Register
Foundation