


PUMPING ARRANGEMENT  
S. S. N<sup>o</sup> 157  
SCALE  $\frac{1}{8}$  INCH = 1 FOOT.



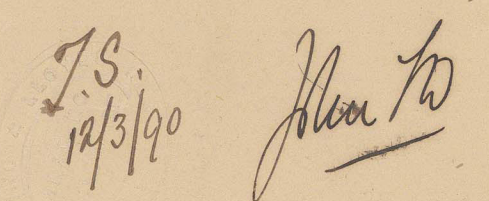

157 7WC816-0017

Lloyd's Pumping plan  
Sew. Stn: "Raduotshie"  
Uwe 1<sup>st</sup> Entry Report  
W<sup>o</sup> 24420



© 2021

Lloyd's Register  
Foundation