

Sew: Stm: "Radnorshire" "NW816-0036"

Received at

Office,

18

Lloyd's Register of British and Foreign Shipping.

(Report on Vessel No. 24420 Port Newcastle)

No. 330

SHIP FORGINGS OR CASTINGS.

I have to report that the undermentioned Iron or Steel Forgings or Castings, manufactured by

Messrs Hawthorn Leslie & Co of Hebburn  
for the Vessel No. 157, being built by Messrs Swan Hunter  
of Wallsend have been inspected by me as set forth below, and found  
to be, so far as can be seen, sound

The words FORGINGS or CASTINGS, IRON or STEEL, should be struck out as may be required.

Mark on Forgings.

Lloyd's

No. 113B


86

John B Craig

Newcastle

|                          | STERN FRAME.                                | RUDDER FRAME.    | STEM.    |
|--------------------------|---|------------------|----------|
| Material* . . . .        | Scrap iron                                  | Scrap iron       |          |
| How made . . . .         | Forged                                      | Forged           |          |
| Dimensions . . . .       | 10-6  | 8-4              |          |
| Progress on Inspection . | Forged & Smithed                            | Forged & Smithed | Not seen |
| Dates when Inspected     | March 3-10-11-21-25-27<br>April 1-3-9-22/90 |                  |          |

SKETCHES OF FRAMES SHEWING POSITION AND DESCRIPTION OF WELDS OF FORGINGS, OR PARTICULARS OF TESTS APPLIED TO CASTINGS.

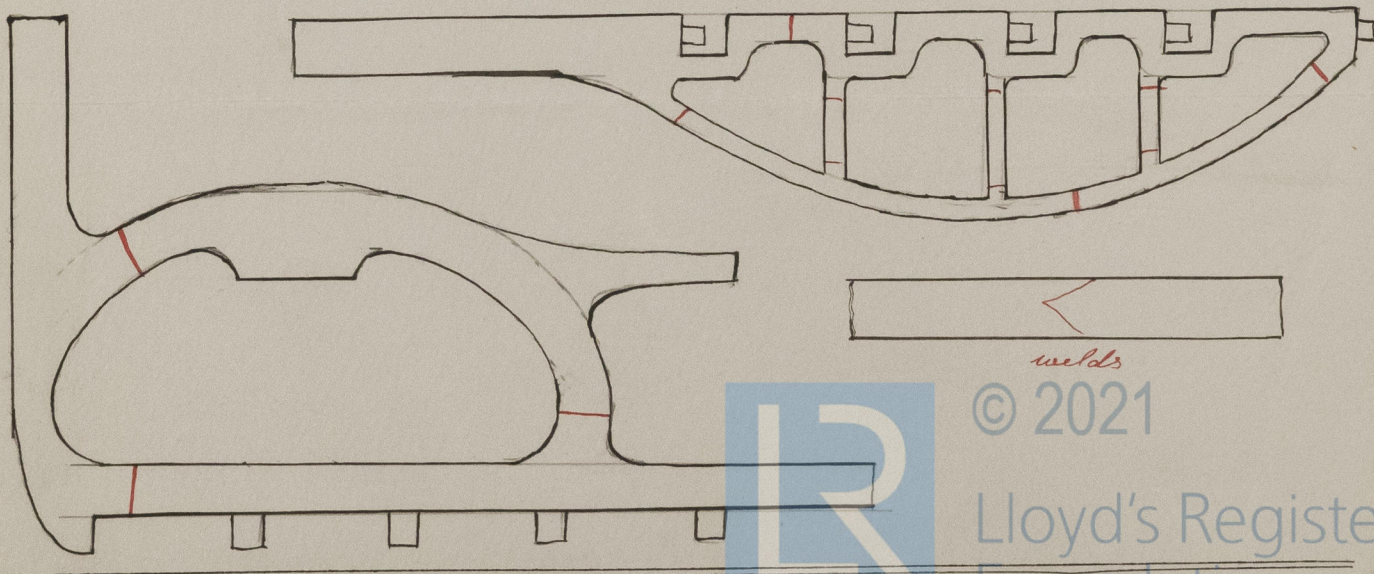



Es Swan + Hunters  
No 154 S/S



© 2021

Lloyd's Register  
Foundation