

Wipper Lane



MIDSHIP SECTION

S.S. N° 43

SCALE 1/2" = 1 FOOT

Class 100A Spar Deck.

1/2 Girth	37.22	D	10.44
1/2 Beam	20.00	L.S.	13.96
Depth	22.58	B	7.88
	74.40	L	
	515.33		
	2597		
	2597		
	599.5		
	799		
	2399		
	25194.864		

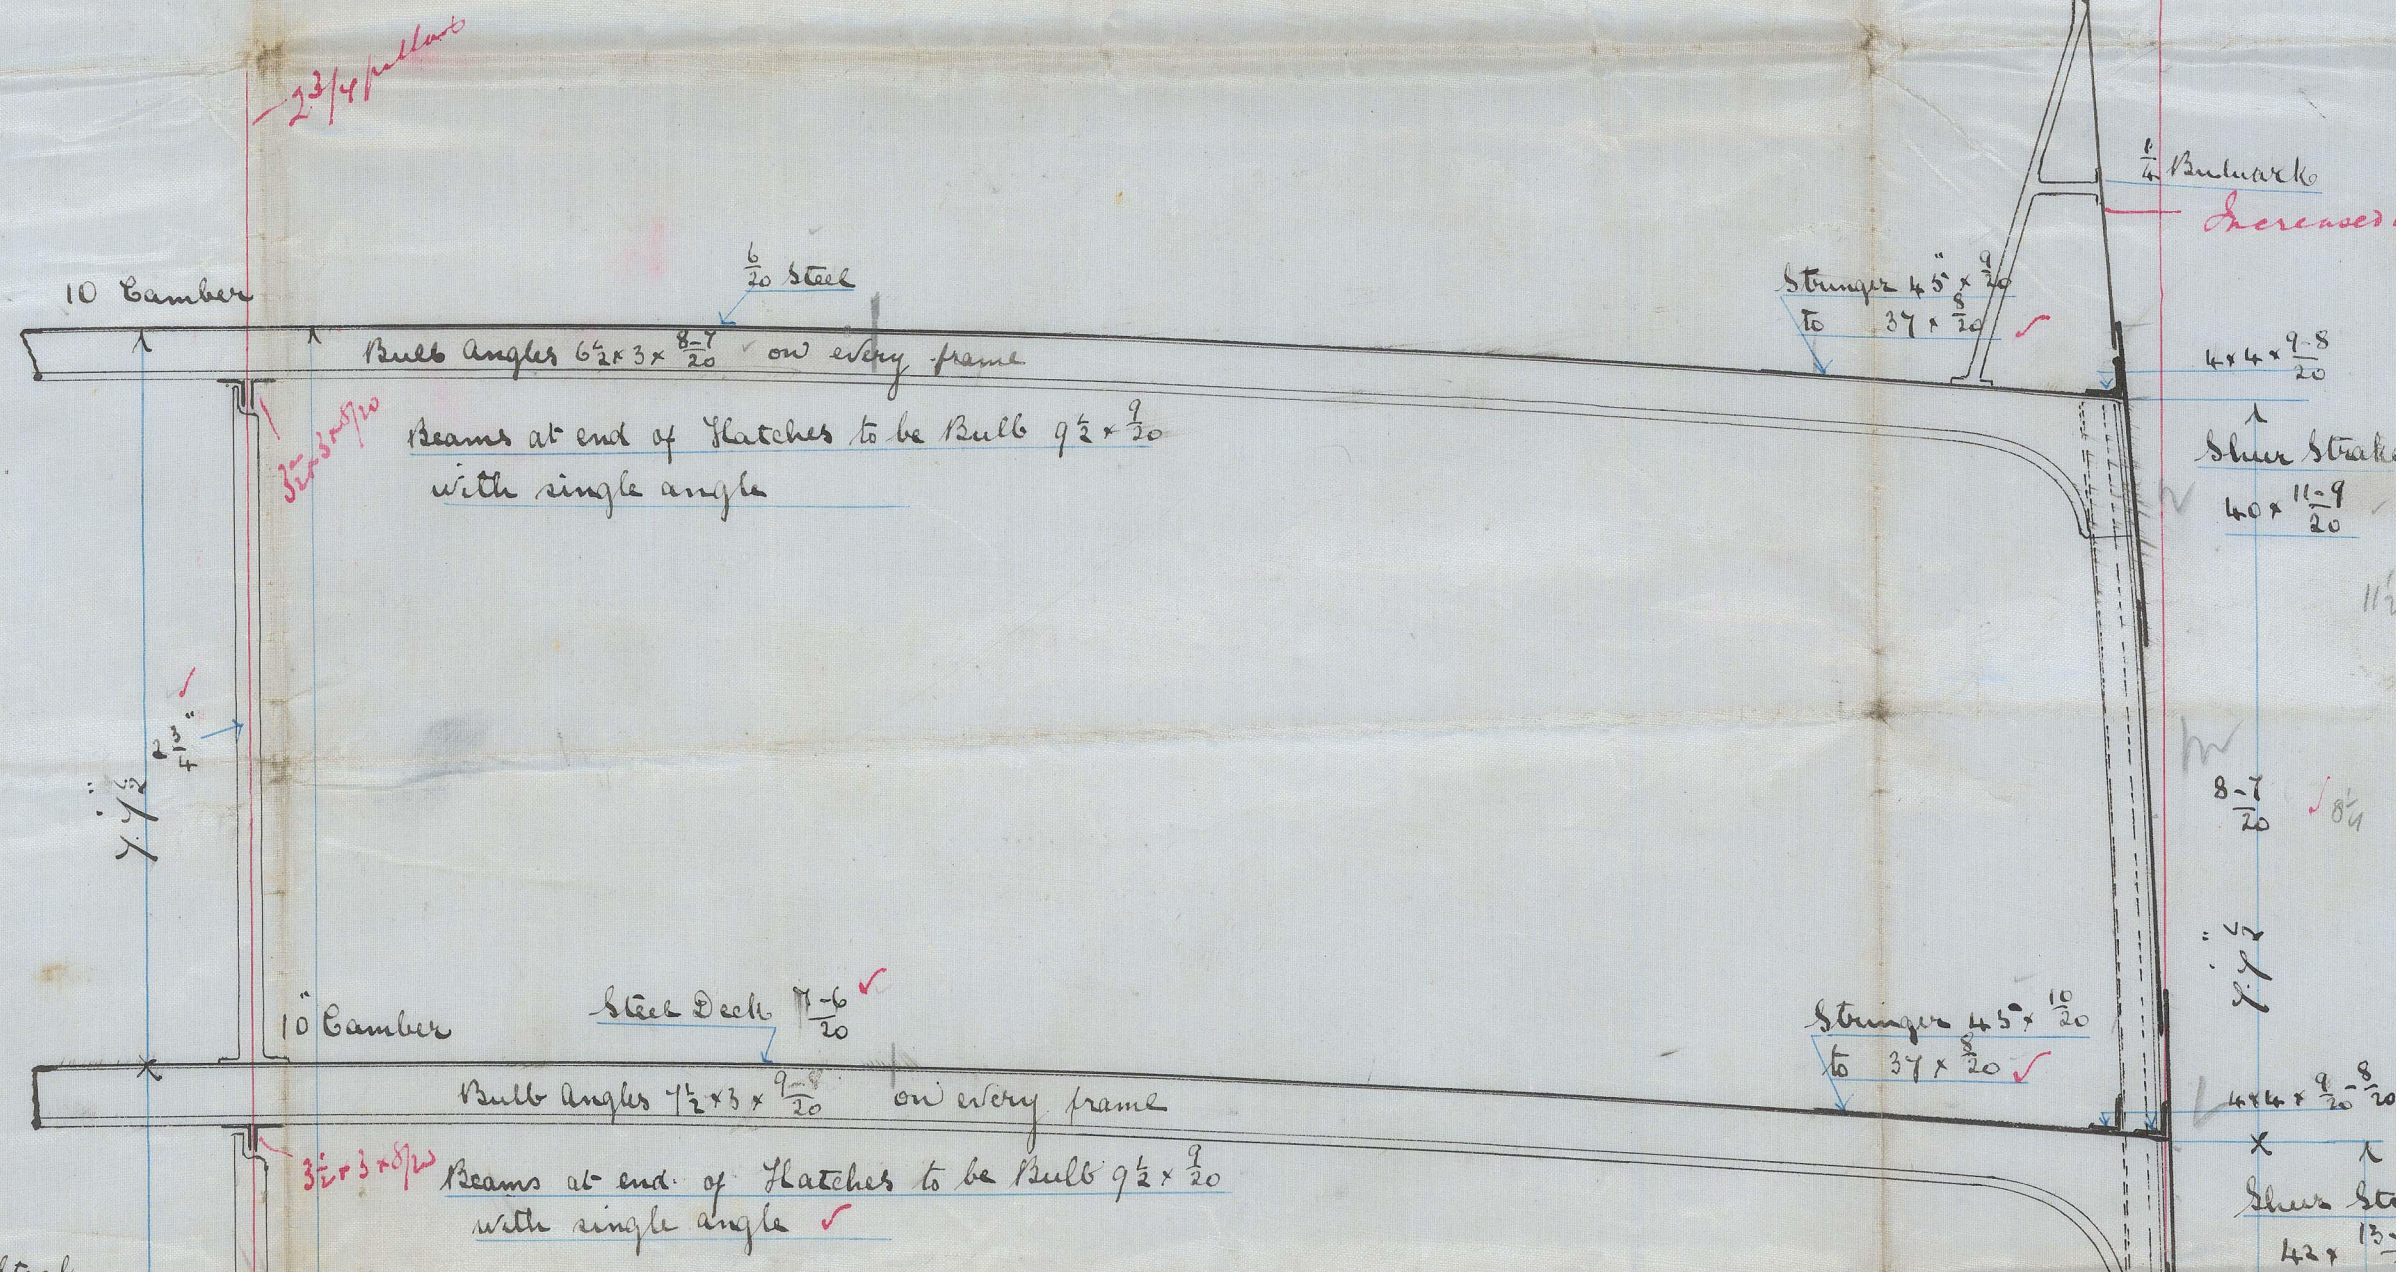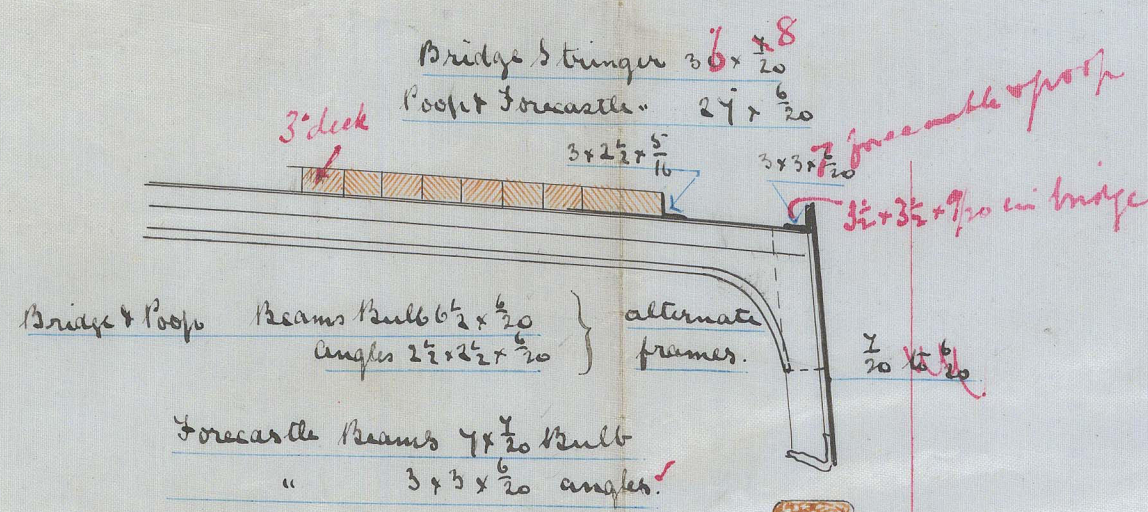


Equipment

2 Rows	36 1/2 cutls ex stock
1 "	31 "
1 Stream	1 1/4 "
1 Hodge	5 1/2 "
1 Hodge	2 1/4 "
300 Salthorn	1 1/2 Stud Chain Cable
90 "	1 1/2 Stream Chain or 1/4" steel wire
100 "	12" Towline or 1/4" steel wire
90 "	10" Hawser
90 "	8 1/2" Warpr

Equipment Numerical

1/2 Girth	44.94
1/2 Beam	20.00
Depth	30.20
	95.14
	1315.33
	2854.2
	4754.0
	9514
	2854.2
	30000.4962
	1968
	31968

Equipment Numerical

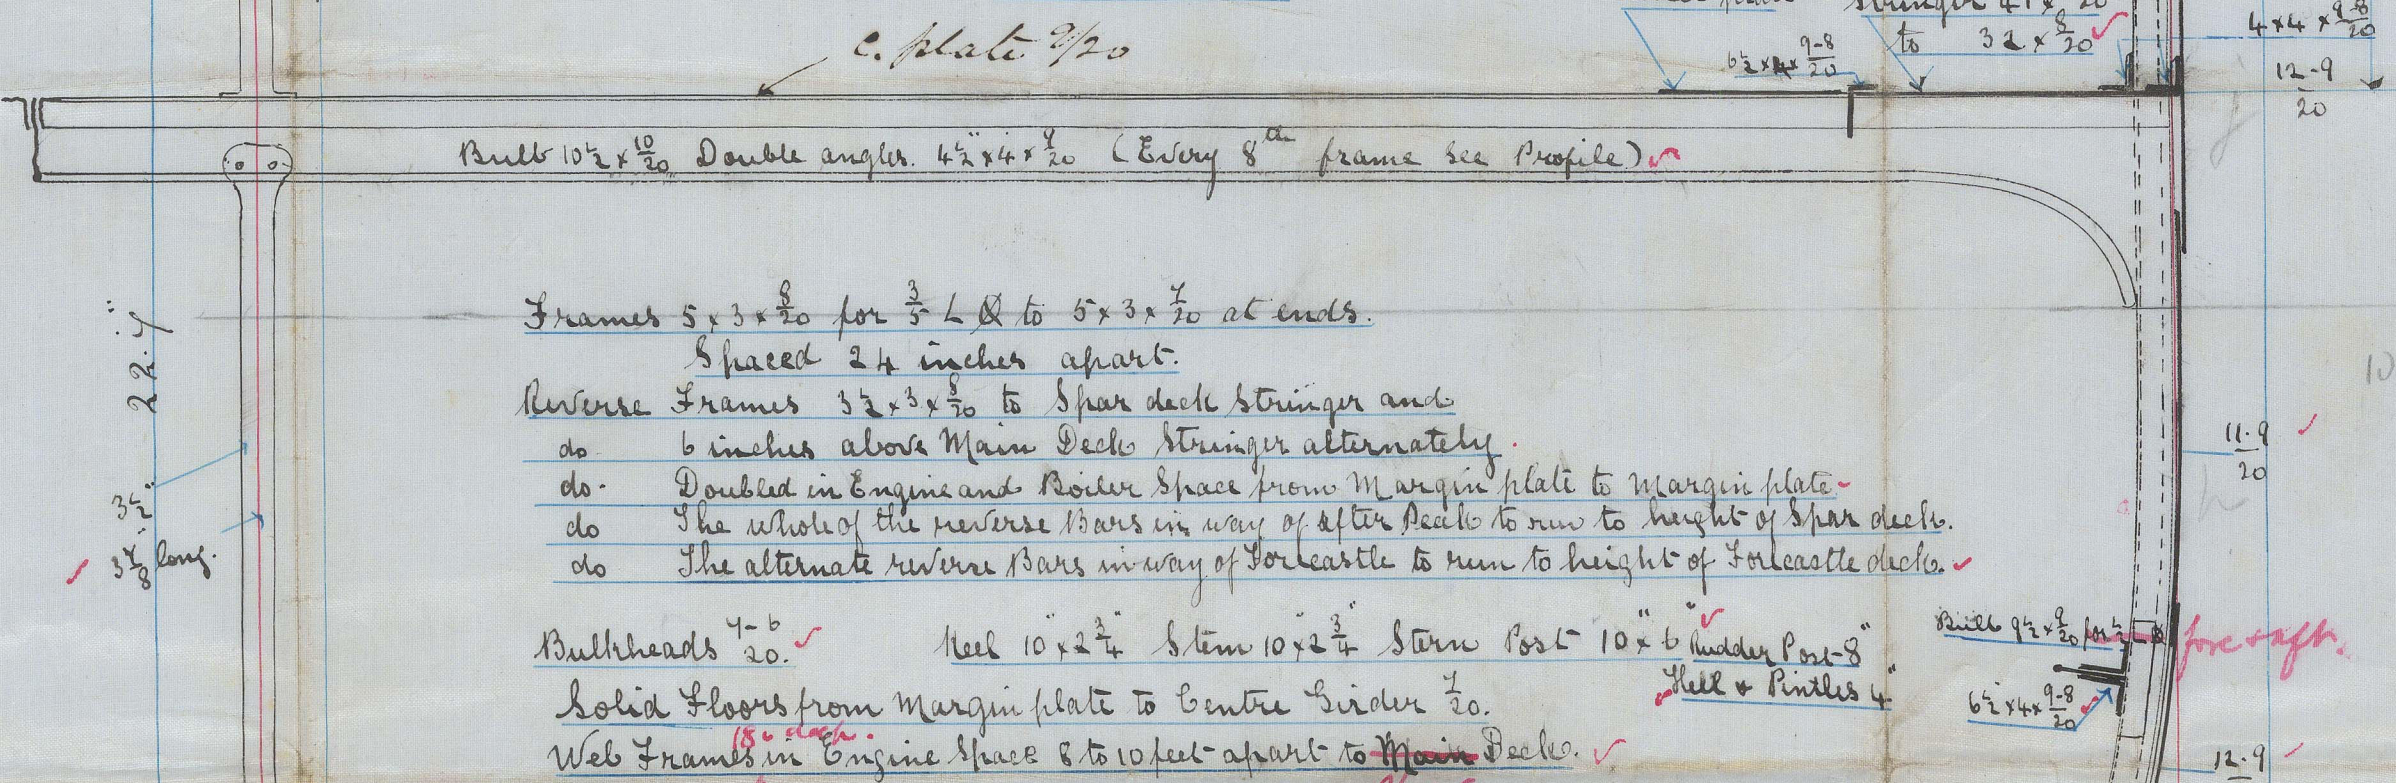

Butt Straps
All the Butts of the Shell Plating & Main Deck Stringer plate for 1/2 L & 1/2 to be double riveted with the Butts now of Rivets spaced 5 to 5 1/2 diam apart and to be 1/2 thicker than plates they connect for 1/2 length amidships and 1/2 thicker at ends. The Butts of the Main Deck Stringer Plate to have Double Straps for 1/2 L & 1/2 double riveted 1/2 L & 1/2

Aug 28-1890
JAS. DOBSON & CO
SHIPBUILDERS
W. WALKER
CASTLE-ON-TYNE

Rec 25687

— 2.2. N. 43



29/8/99

NWC 819 - 0044

Lloyd's Register
Foundation