


dn 9. 10² 90


revised
12 Dec 1890

SUCTION PLAN. NO. 43 SHIP.

SCALE $\frac{1}{8}$ " = 1 Foot.

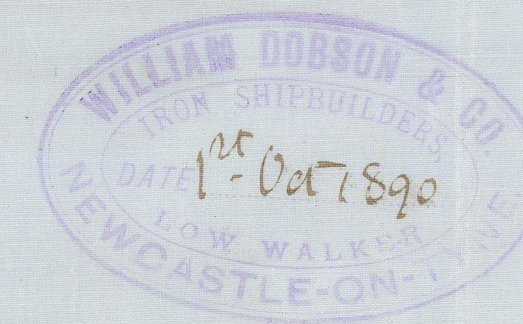


MA 3. 10. 90
men 4/10/90

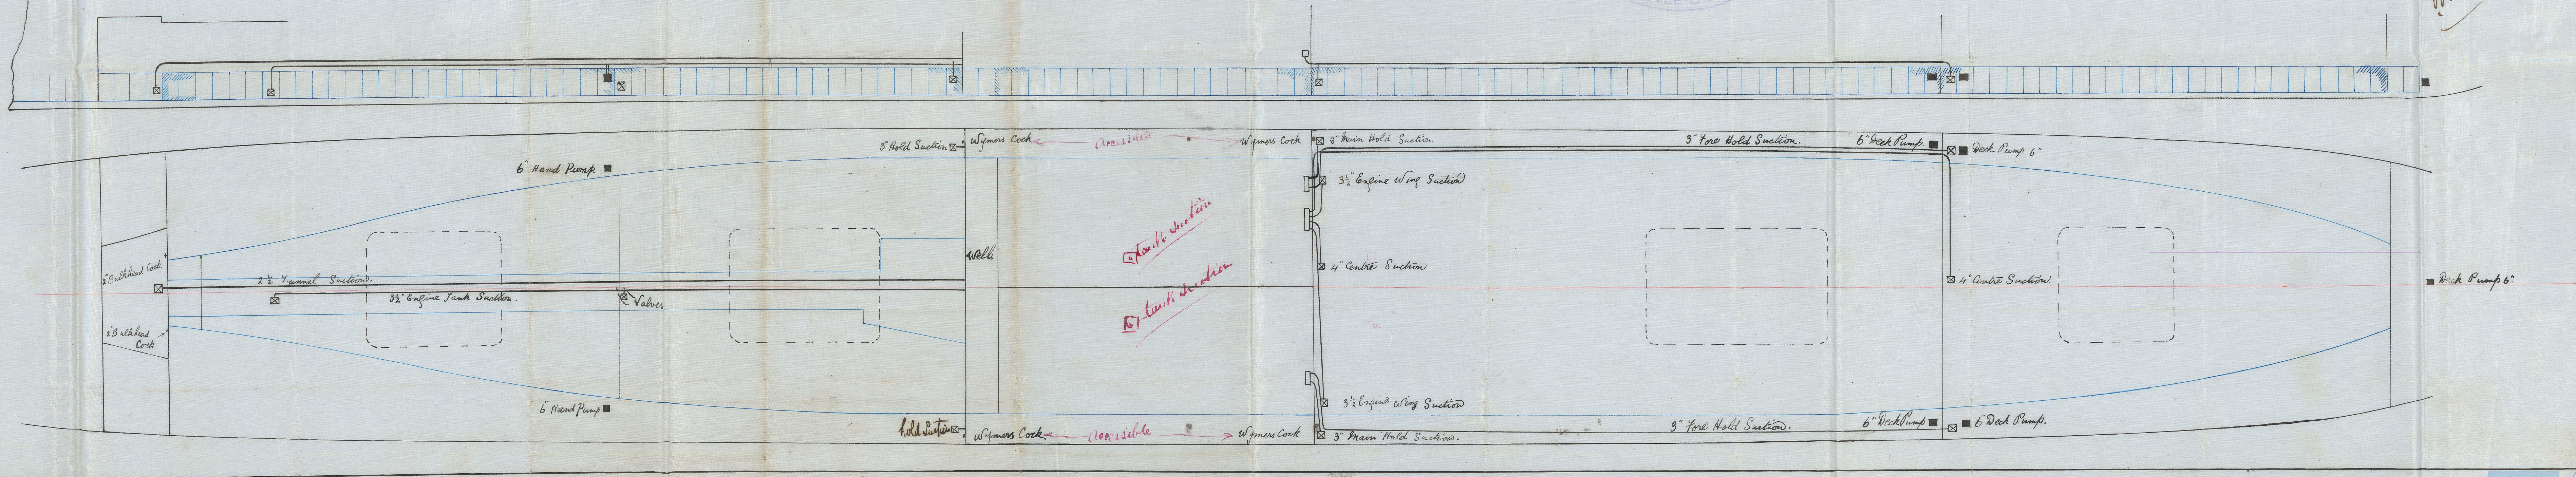

MA 6-10 90

25 OCT 1964

2 CASE 1" = 1 FOOT

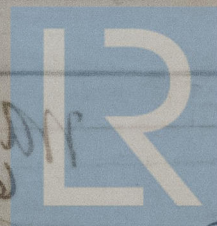

Lloyd's Register
Foundation

NWC 819-0047