


FRI 3 OCT 91

Handwritten notes:
2 1/2 ft
3 ft
4 ft
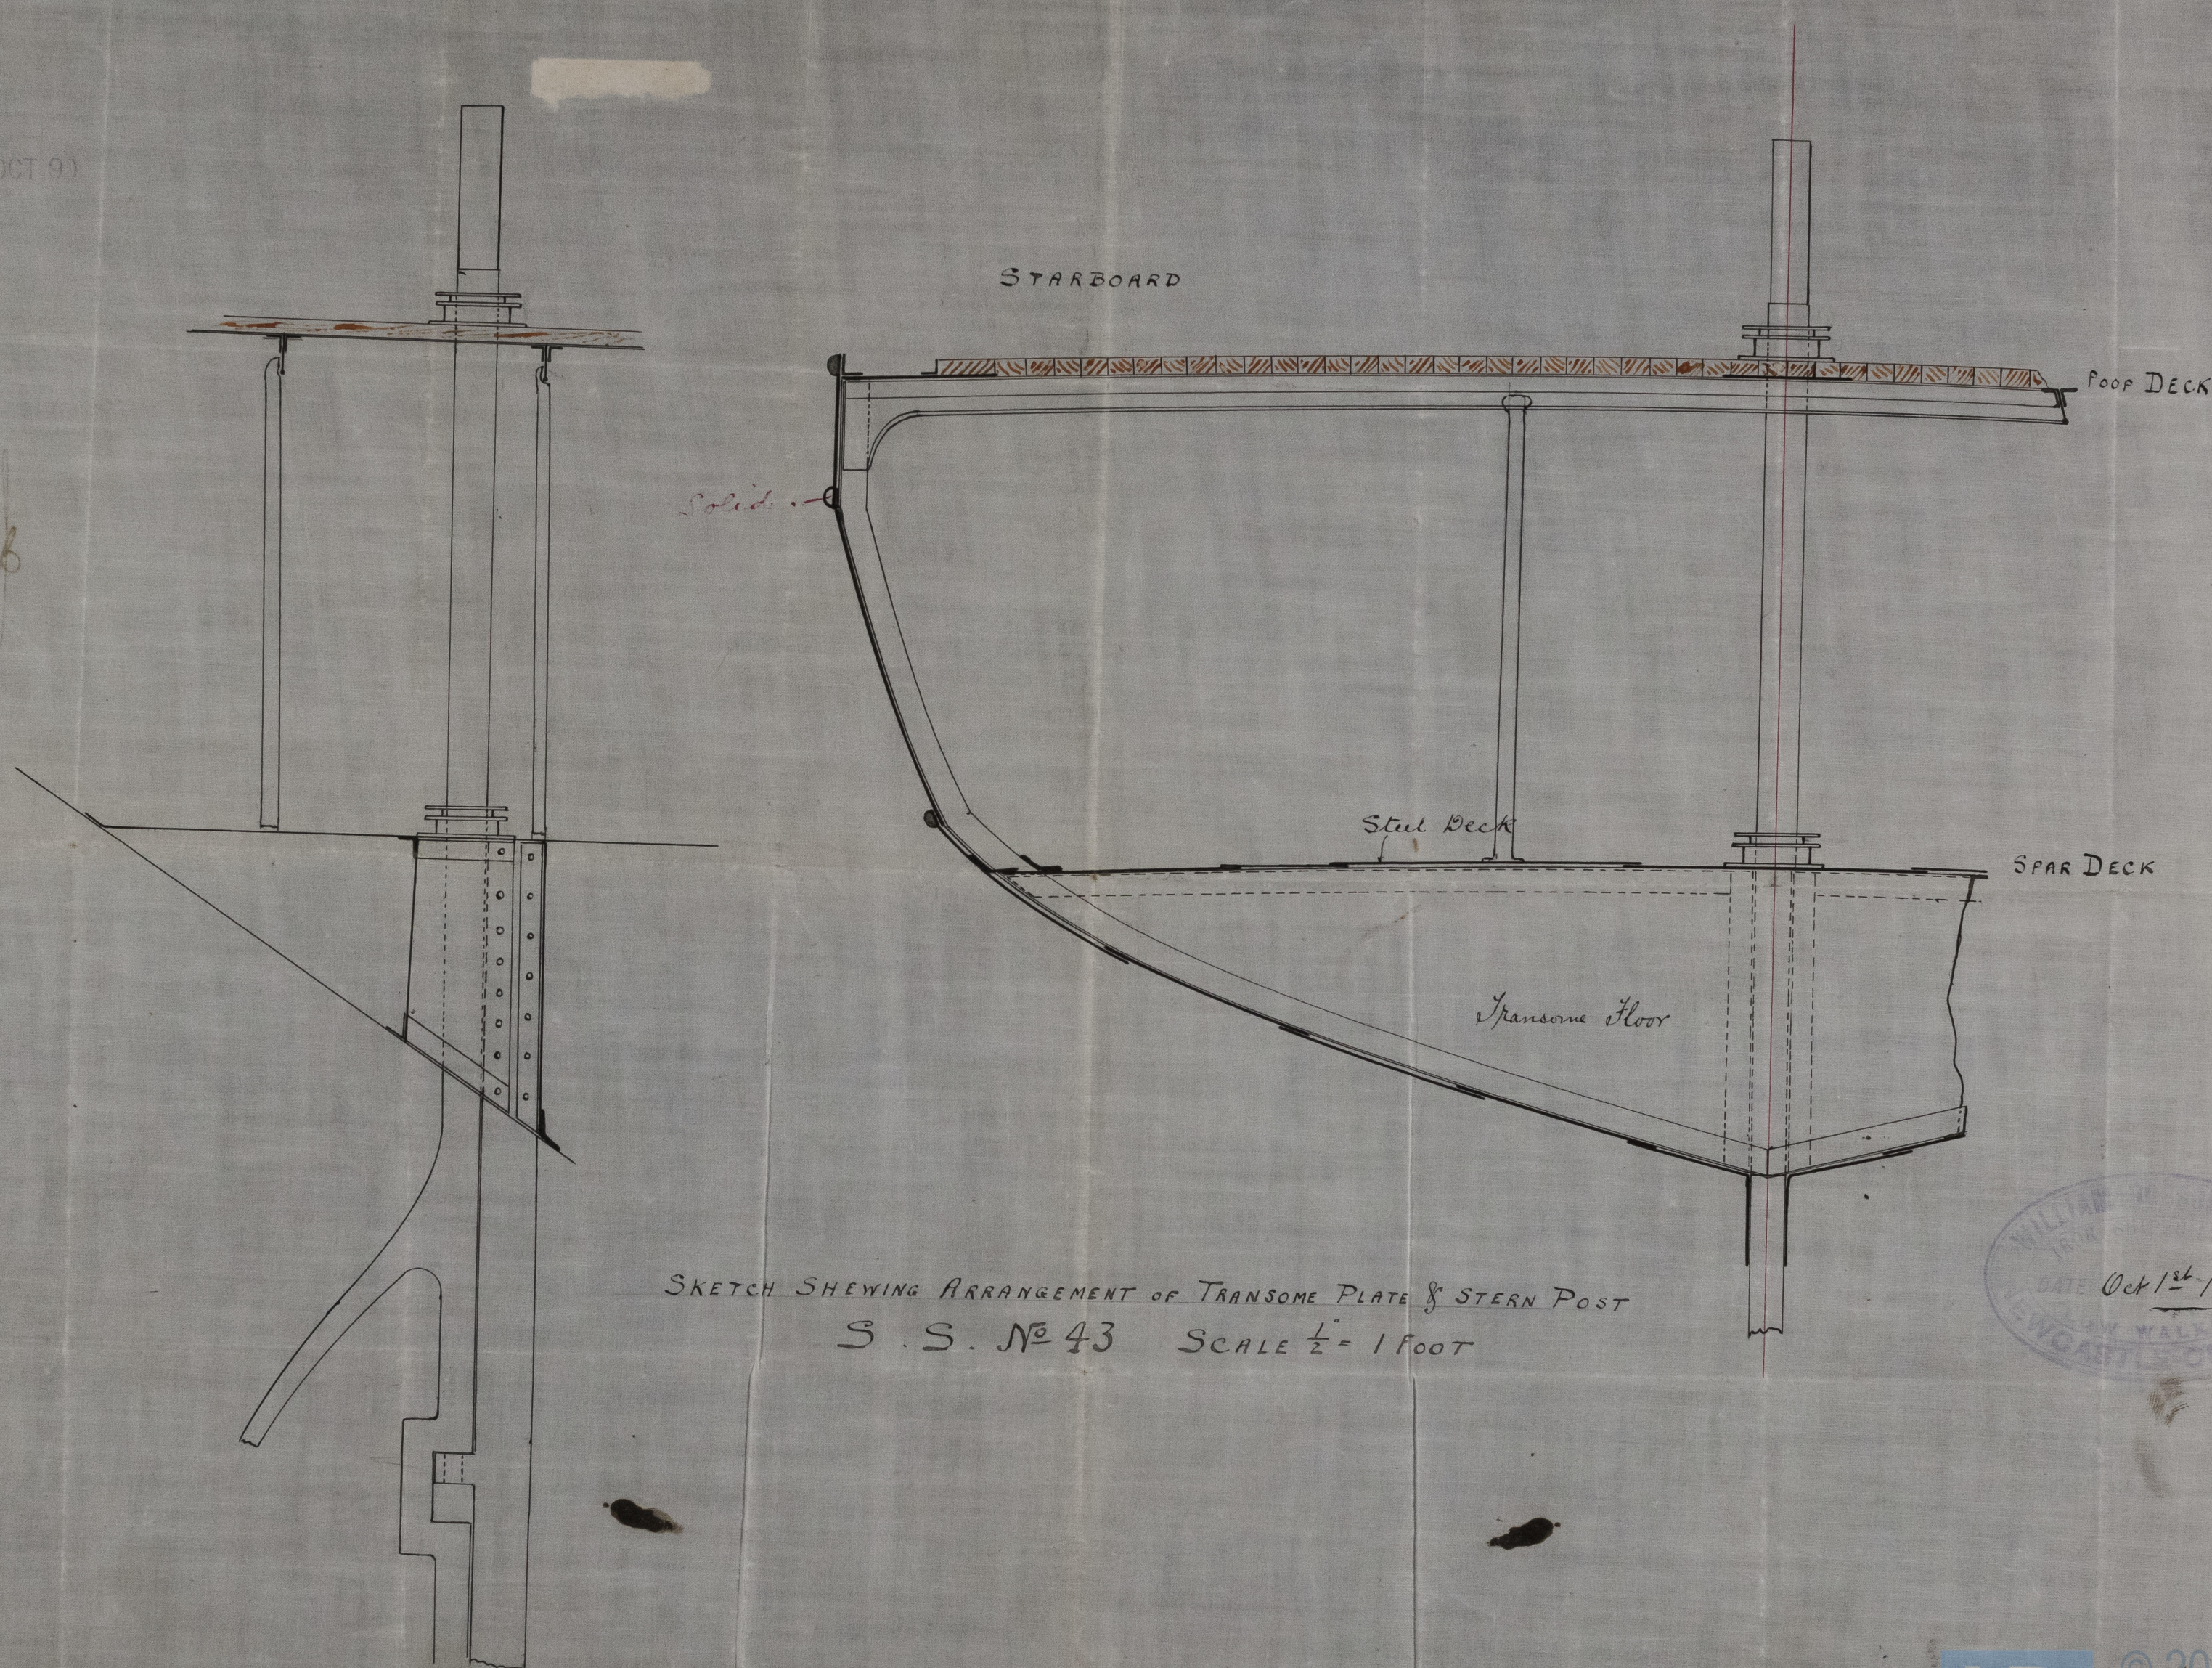

SKETCH SHEWING ARRANGEMENT OF TRANSOME PLATE & STERN POST
S. S. N^o 43 SCALE $\frac{1}{2}$ " = 1 FOOT

WILLIAM WALKER & CO.
IRON SHIPBUILDERS
DATE Oct 1st 1890
NEWCASTLE-ON-TYNE




© 2021

Lloyd's Register
Foundation

NWC819 - 0048