


Received at

Office

18

Lloyd's Register of British and Foreign Shipping.

(Report on Vessel No. 25681 Port Newcastle)

No. 506

SHIP FORGINGS OR CASTINGS.

I have to report that the undermentioned Iron or Steel Forgings or Castings, manufactured by

The Jarrow Forge Co of Jarrow  
for the Vessel No. 43, being built by Messrs W Dobson & Co  
of Walker have been inspected by me as set forth below, and found  
to be, so far as can be seen, sound

Mark on Forgings.

Lloyd's

No. 169B

96


John C Craig

Newcastle

31/1/91

|                        | STERN FRAME.           | RUDDER FRAME.            | STEM.          |
|------------------------|------------------------|--------------------------|----------------|
| Material*              | Scrap iron             | Scrap iron               | Scrap iron     |
| How made               | Forged                 | Forged                   | Forged         |
| Dimensions             | 10' - 6"               | 8' - 4"                  | 10' - 2 3/4"   |
| Progress on Inspection | Forged & Smithed       | Forged & Smithed         | Smithed        |
| Dates when Inspected   | Sept 29/12 - 16/22 Oct | December 29/20           | November 10/21 |
|                        | 1-6-13-22 Nov 3/91     | January 6/13-16-20-27/91 |                |

SKETCHES OF FRAMES SHEWING POSITION AND DESCRIPTION OF WELDS OF FORGINGS, OR PARTICULARS OF TESTS APPLIED TO CASTINGS.

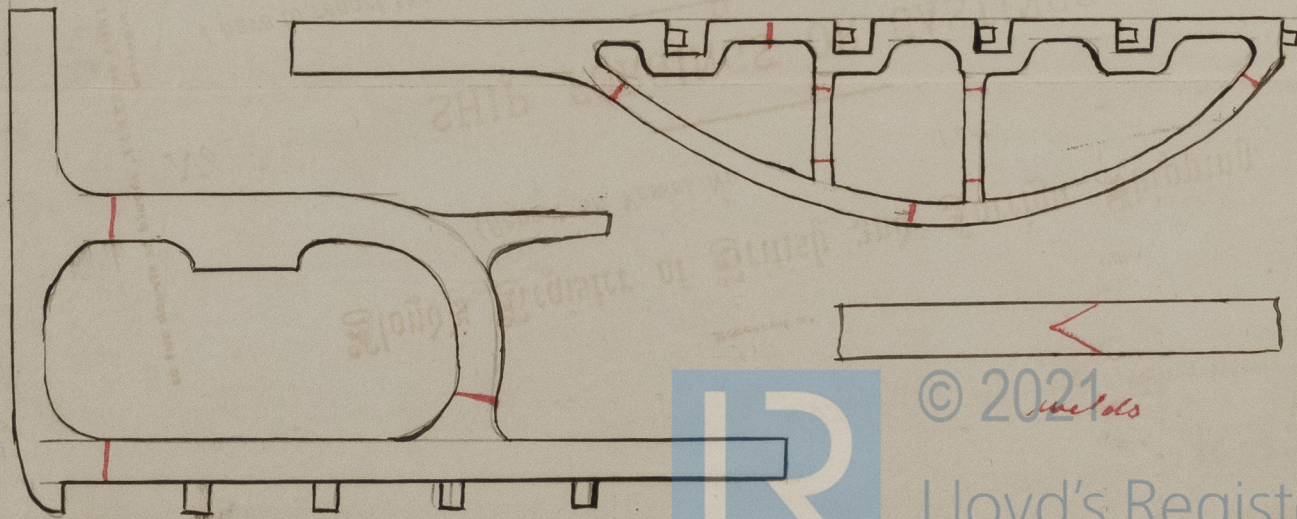



Bobson 43



© 2021

Lloyd's Register  
Foundation